## **ADDENDUM #1**

Project Name:
Capitol West Stairs & Surrounding Landings Repair - Bid Issuance #3
DAS# 9420.00
RFB 942000-01
Addendum #1
Dated: July 31, 2025

This Addendum forms a part of the bidding and contract documents. This Addendum supersedes and supplements all portions of the original bidding and contract documents dated <u>July 01, 2025</u> with which it conflicts.

ACKNOWLEDGE RECEIPT OF THIS ADDENDUM IN THE SPACE PROVIDED ON THE BID FORM. FAILURE TO DO SO MAY SUBJECT THE BIDDER TO DISQUALIFICATION.

### 1. CLARIFICATIONS

A. Budget \$487,000

## 2. PLANS

A. No items.

## 3. SPECIFICATIONS

- A. Section 00 0115, List Of Drawing Sheets: Remove F. A110.3 North Stair Elevations, H. A113.3 South Stair Elevations and I. A113.4 West Stair Elevations.
- B. Section 01 2300 Replace entire section with attached Section 01 2300.
- C. Section 01 1200, Contract Summary, 1.09 Bid Package Instructions, Bid Package #01 add the following:
  - 7. Include lump sum Allowance of \$10,000.00 for repair of granite slab supports and granite tread supports. Condition of existing supports is unknown. Contractor to assume standard mortar bed for setting granite as part of base bid. Contractor to submit invoices, delivery slips, and/or time sheets to show actual quantities to be signed off by construction manager at time of execution/delivery on a daily basis.

# 4. QUESTIONS AND CLARIFICATIONS

A. No Items.

# 5. SUBSTITUTION REQUESTS

A. No items.

# 6. ATTACHMENTS

- A. Section 00 0115, List Of Drawing Sheets (1 page)
- B. Section 01 2300 Alternates (1 page)
- C. OPN Addendum #1, Dated July 31, 2025 (Contents 2 typed pages and 4 drawing sheets)

**END OF ADDENDUM** 

# **SECTION 00 0115**

# **LIST OF DRAWING SHEETS**

# **DRAWINGS**

1.01	SHEET	TITLE
Α.		COVER SHEET
B.	A000.3	SITE ACCESS & GENERAL DRAWING INFORMATION
C.	A100.3	SITE IMPROVEMENTS
D.	A101.3	SITE SIGNAGE (ALT. 1 and ALT. 2)
E.	A102.3	ENLARGED FLOOR PLANS - EAST STAIRS
-F.	A110.3	NORTH STAIR ELEVATIONS
G.	A111.3	EAST STAIR ELEVATIONS
<del>- H</del>	A112.3	SOUTH STAIR ELEVATIONS
<del></del>	A113.3	WEST STAIR ELEVATIONS
J.	A120.3	DETAILS
K.	A120.4	SIGNAGE GRAPHICS (ALT. 1 and ALT. 2)

# **END OF SECTION**

### SECTION 01 2300 ALTERNATES

#### **PART 1 GENERAL**

#### 1.01 SECTION INCLUDES

- A. Description of Alternates.
- B. Procedures for pricing Alternates.
- C. Documentation of changes to Contract Price and Contract Time.

#### 1.02 ACCEPTANCE OF ALTERNATES

- A. Alternates quoted on Bid Forms will be reviewed and accepted or rejected atomes option. Accepted Alternates will be identified in the Owner-Contractor Agreement.
- B. Coordinate related work and modify surrounding work to integrate the Work of each Alternate.
- C. Include as part of each alternate, miscellaneous devices, accessory objects, and similar items incidental to or required for a complete installation whether or not indicated as part of alternate
- D. Execute accepted alternates under the same conditions as other work of the Contract.

### 1.03 SCHEDULE OF ALTERNATES

- A. ALTERNATE NO. 1 Signage Type Mark G1, G2, P1, P2, and P3.
  - a. Includes all construction for signage type mark G1, G2, P1, P2, and P3.
  - b. This includes the new foundations, granite bases, new bronze poles.
  - c. Includes any demolition and construction including general conditions, signage, and signage attic stock, excavation, concrete footings, and granite bases.
  - d. Provide and install new bronze posts and shoes (owner supplied) as noted on drawings.
  - e. Remove and reinstall existing bronze posts and shoes (owner supplied) as noted on the drawings.
  - f. Paint signposts where noted on the drawings.
  - g. Includes temporary signage for this type of sign during construction.
  - h. Includes specifications: 02 4100, 03 3000, 04 0140, 05 5000, 09 9600, and 10 1423 as applies.
- B. ALTERNATE NO. 2 Signage Type Mark WF1 and WF2.
  - a. Includes all construction for signage type mark WF1 and WF2.
  - b. This includes the new foundations, granite base, new bronze poles and restoration of the the WF1-subsets with existing signage frame mounted on stands and new placards. And restoration of the WF2 existing signage frame mounted to the building and new placards.
  - c. Includes any demolition and construction including general conditions, signage, signage attic stock, excavation, concrete footings, and granite base.
  - d. Prep. and paint sign with high performance coating, replace clear acrylic sign glazing and graphics complete as noted on drawings.
  - e. Includes temporary signage for this type of sign during construction.
  - f. Includes specifications: 02 4100, 03 3000, 04 0140, 05 5000, 09 9600, and 10 1423 as applies.

### **PART 2 PRODUCTS - NOT USED**

# **END OF SECTION**



# **ADDENDUM #1**

9420.00 DAS CC Capitol West Stairs &

PROJECT: Surrounding Landscape Repairs Bid

Issuance #3

OWNER: State of Iowa Legislative Branch DATE: July 31, 2025

**PROJECT NO.:** 19802019

BID DATE: August 7, 2025

### TO ALL HOLDERS OF DRAWINGS AND PROJECT MANUALS

This addendum is issued to incorporate the following changes in the drawings and project manual. For bids to be considered, this addendum must be acknowledged by indicating on the Form of Bid.

Bidders shall make the following corrections or additions to the bidding documents. These items shall supersede, modify, and/or change all statements or drawings to the contrary in the drawings and project manual and shall take precedence over these documents. Bidders shall base their bid on the drawings and project manual and as modified by the changes herein stated.

To: All Bidders Contents: (2) Typed Pages

(0) Specification Section Pages

(4) Drawing Sheets

#### 1. DIVISION 0/1- FRONT ENDS

### PROJECT MANUAL CHANGES

Detail

Item#	/Sheet	Description of Change
1.	N/A	None

### 2. ARCHITECTURE

### ARCHITECTURAL MANUFACTURERS/PRODUCTS:

Item #	Section	Description of Change
1.	N/A	None

#### ARCHITECTURAL DRAWING CHANGES

Item #	Sheet #	Description of Change
1.	A000.3	Detail E6
		A. Clarification - Will the contractor lay down area shown on A000.3 be
		available for parking? Answer - yes, but only two vehicles.
		B. Will the lay down area be available during the Legislative Session time
		frame or will all materials need to be removed? No, This area will not be

		available during the Legislative Session. Contractor will need to clean and remove materials by December 1, 2025 and will be likely be available sometime in May 2026 after the Legislative Session. This date is not known but next the session is scheduled for approximately 100 calendar days.  C. See attached drawing of A000.3
2.	A102.3	<ul> <li>A. Detail A2 – Showing the demolition of the granite treads to match the location of the new granite treads.</li> <li>B. Detail A11 – Revised the hatch pattern to show the replacement new granite slab replacement.</li> <li>C. Clarification - The drainage pipe does not daylight on the south side of the sidewalk.</li> </ul>
		<ul> <li>D. Clarification - Replace broken granite pavers with salvaged attic stock by owner (assume 24 replacements). Are the pavers on site? Answer is No, the salvaged pavers are stored off site but will be brought to the site by the owner for the contractor to install</li> <li>E. See attached drawing of A102.3</li> </ul>
3.	A111.3	Detail J3, J12 and A3  A. The intent is to repoint all sides of the balustrades.  B. See the attached drawing A111.3.
4.	A120.3	A. Added a diagram for rebar configuration and sizes in the concrete foundation for the post bases.     B. Add size of the four stainless steel dowels between the granite and concrete.     C. See the attached drawing A120.3.
5.	A120.4	The graphics and digital images for the signage will be provided to the contractor.

# **END OF ADDENDUM**

10

11

12


13

15

17

18

1 2 3 4 5 6 7 8 9

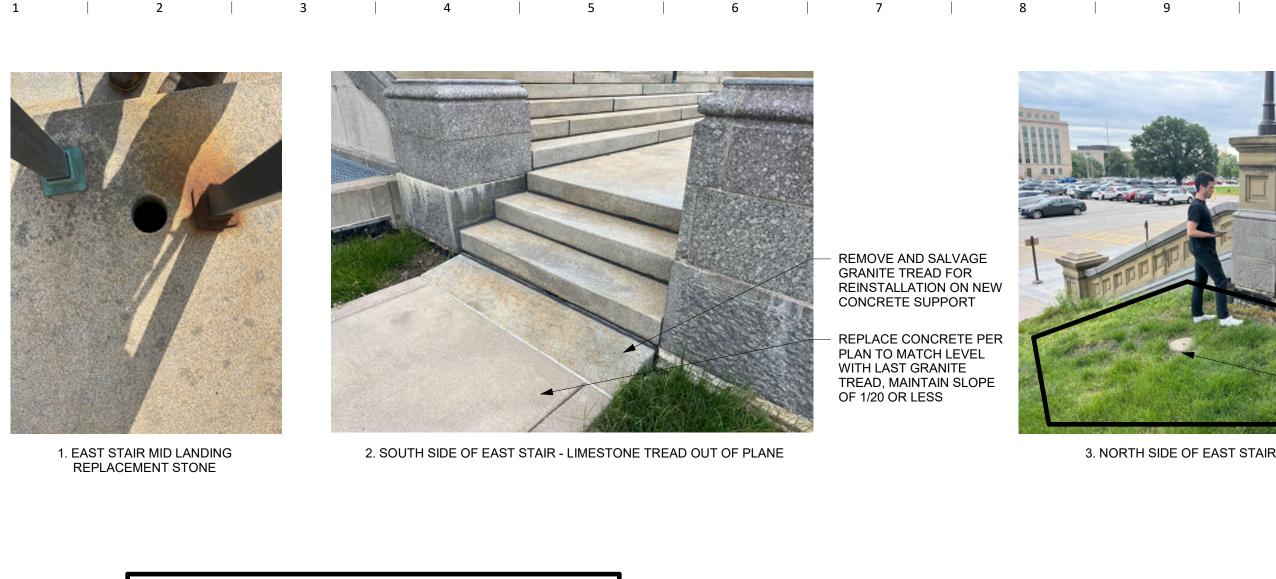

ENLARGED PLAN - EAST STAIR - DEMOLITION

1/8" = 1'-0"



11 | 12


1 | 2 | 3 | 4 | 5 | 6 | 7 | 8 | 9 | 10 | 11 | 12 | 13 | 14 | 15 | 16 | 17 | 18 | 19 | 20 | 21


13



REGRADE TO HEAVY LINE. PROVIDE DRAINAGE AWAY



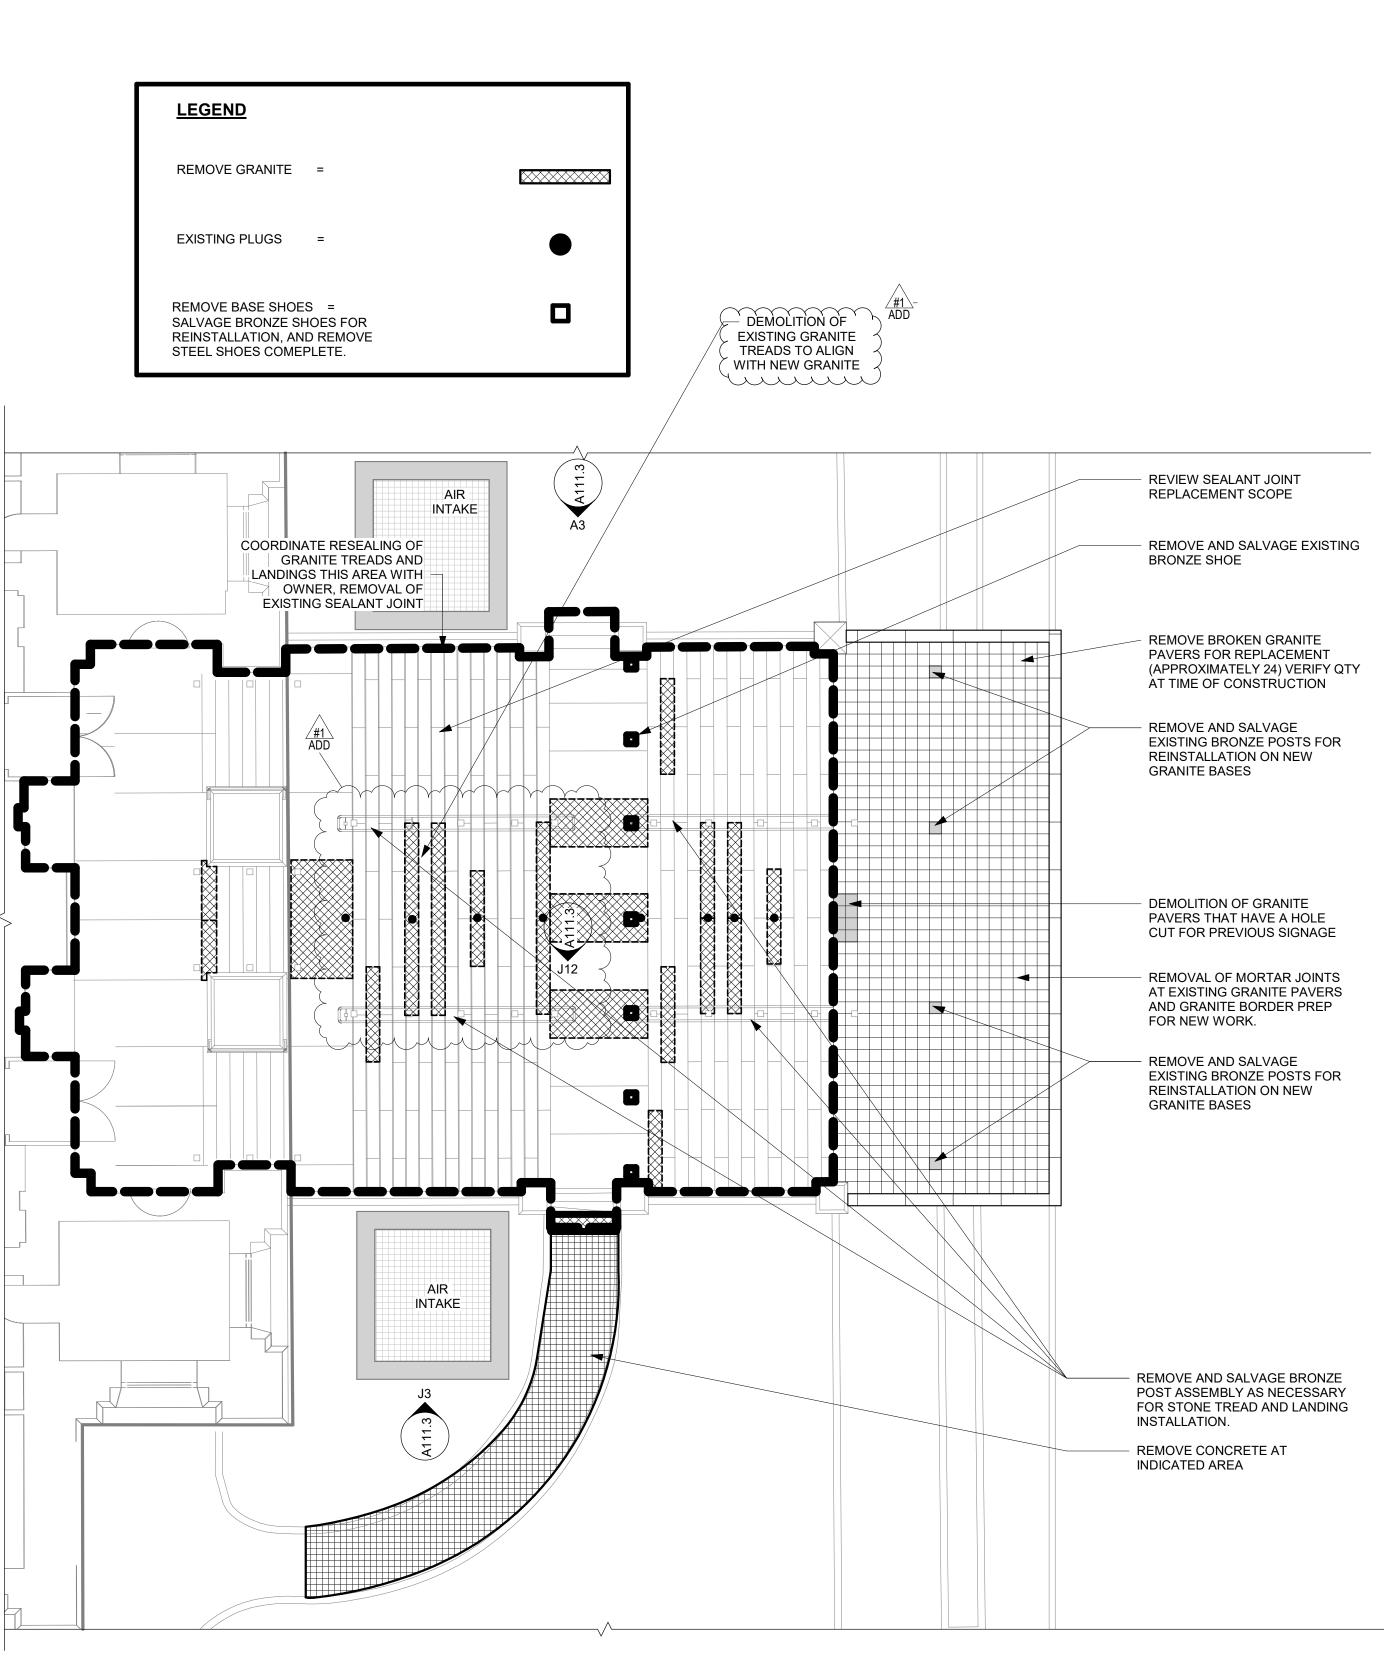

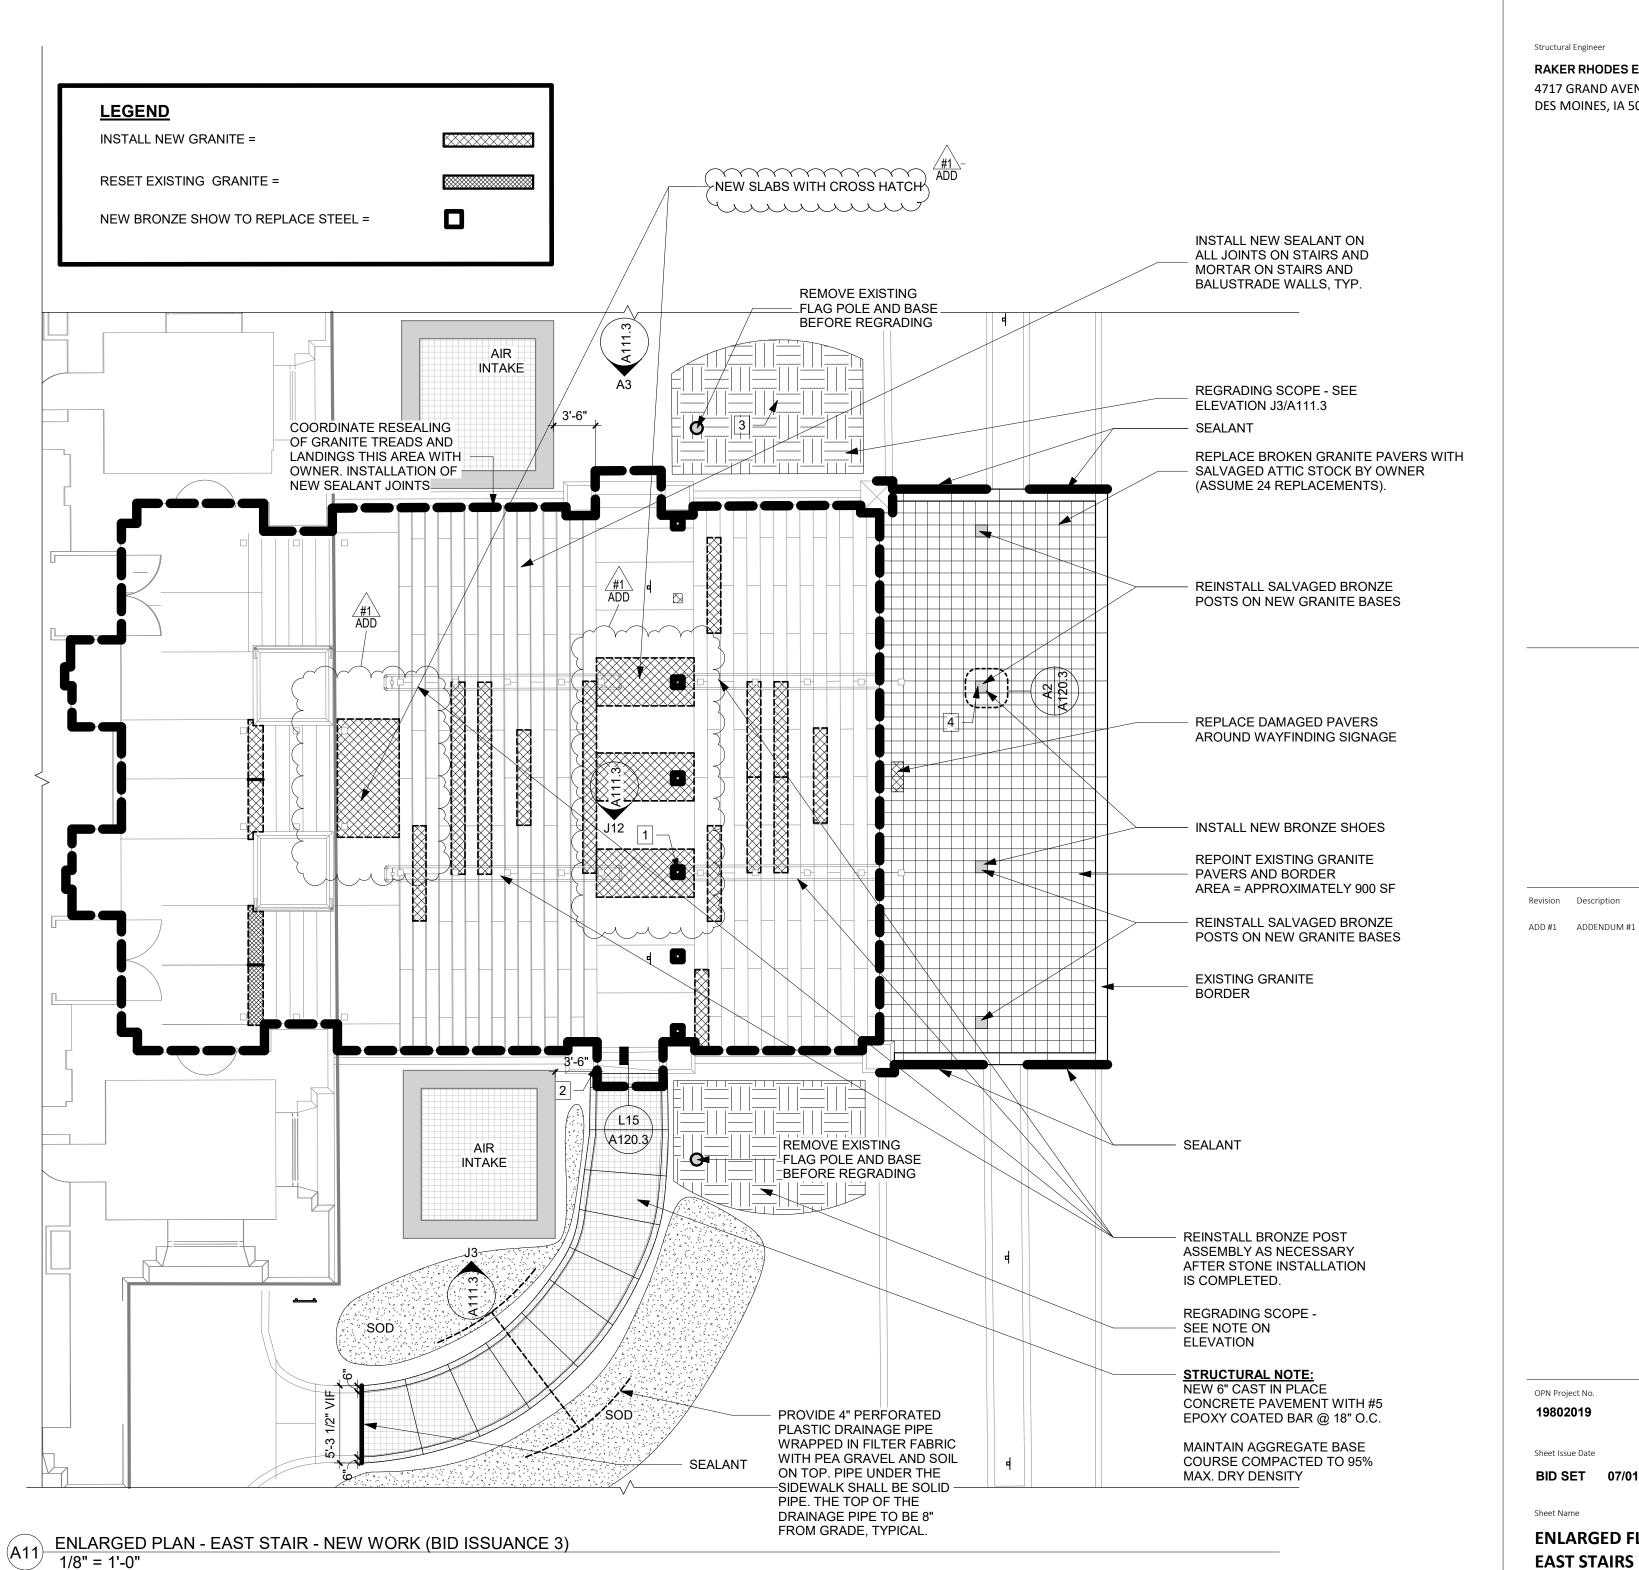

17

REPLACE EXISTING

CONCRETE BASE WITH

**NEW GRANITE BASES AS** 


100 Court Ave., Suite 100 Des Moines, IA 50309 P: 515-309-0722 www.opnarchitects.com All reports, plans, specifications, computer files, field data, notes and other documents and instruments prepared by OPN Architects, Inc. as instruments of service shall remain the property of OPN Architects, Inc. OPN Architects, Inc. shall retain all common law, statutory and other reserved rights, including the copyright thereto. © 2025 OPN Architects, Inc. 9420.00 DAS Capitol West Stairs & **Surrounding Landscape Repairs** Bid Issuance 3 1007 E GRAND AVENUE DES MOINES, IA 50319 Construction Manager THE SAMUELS GROUP 2929 WESTOWN PARKWAY, SUITE 200 WEST DES MOINES, IA 50266 Structural Engineer RAKER RHODES ENGINEERING **4717 GRAND AVENUE** DES MOINES, IA 50309

OPN Project No. 19802019 Sheet Issue Date

BID SET 07/01/2025

**ENLARGED FLOOR PLANS -**EAST STAIRS

A102.3

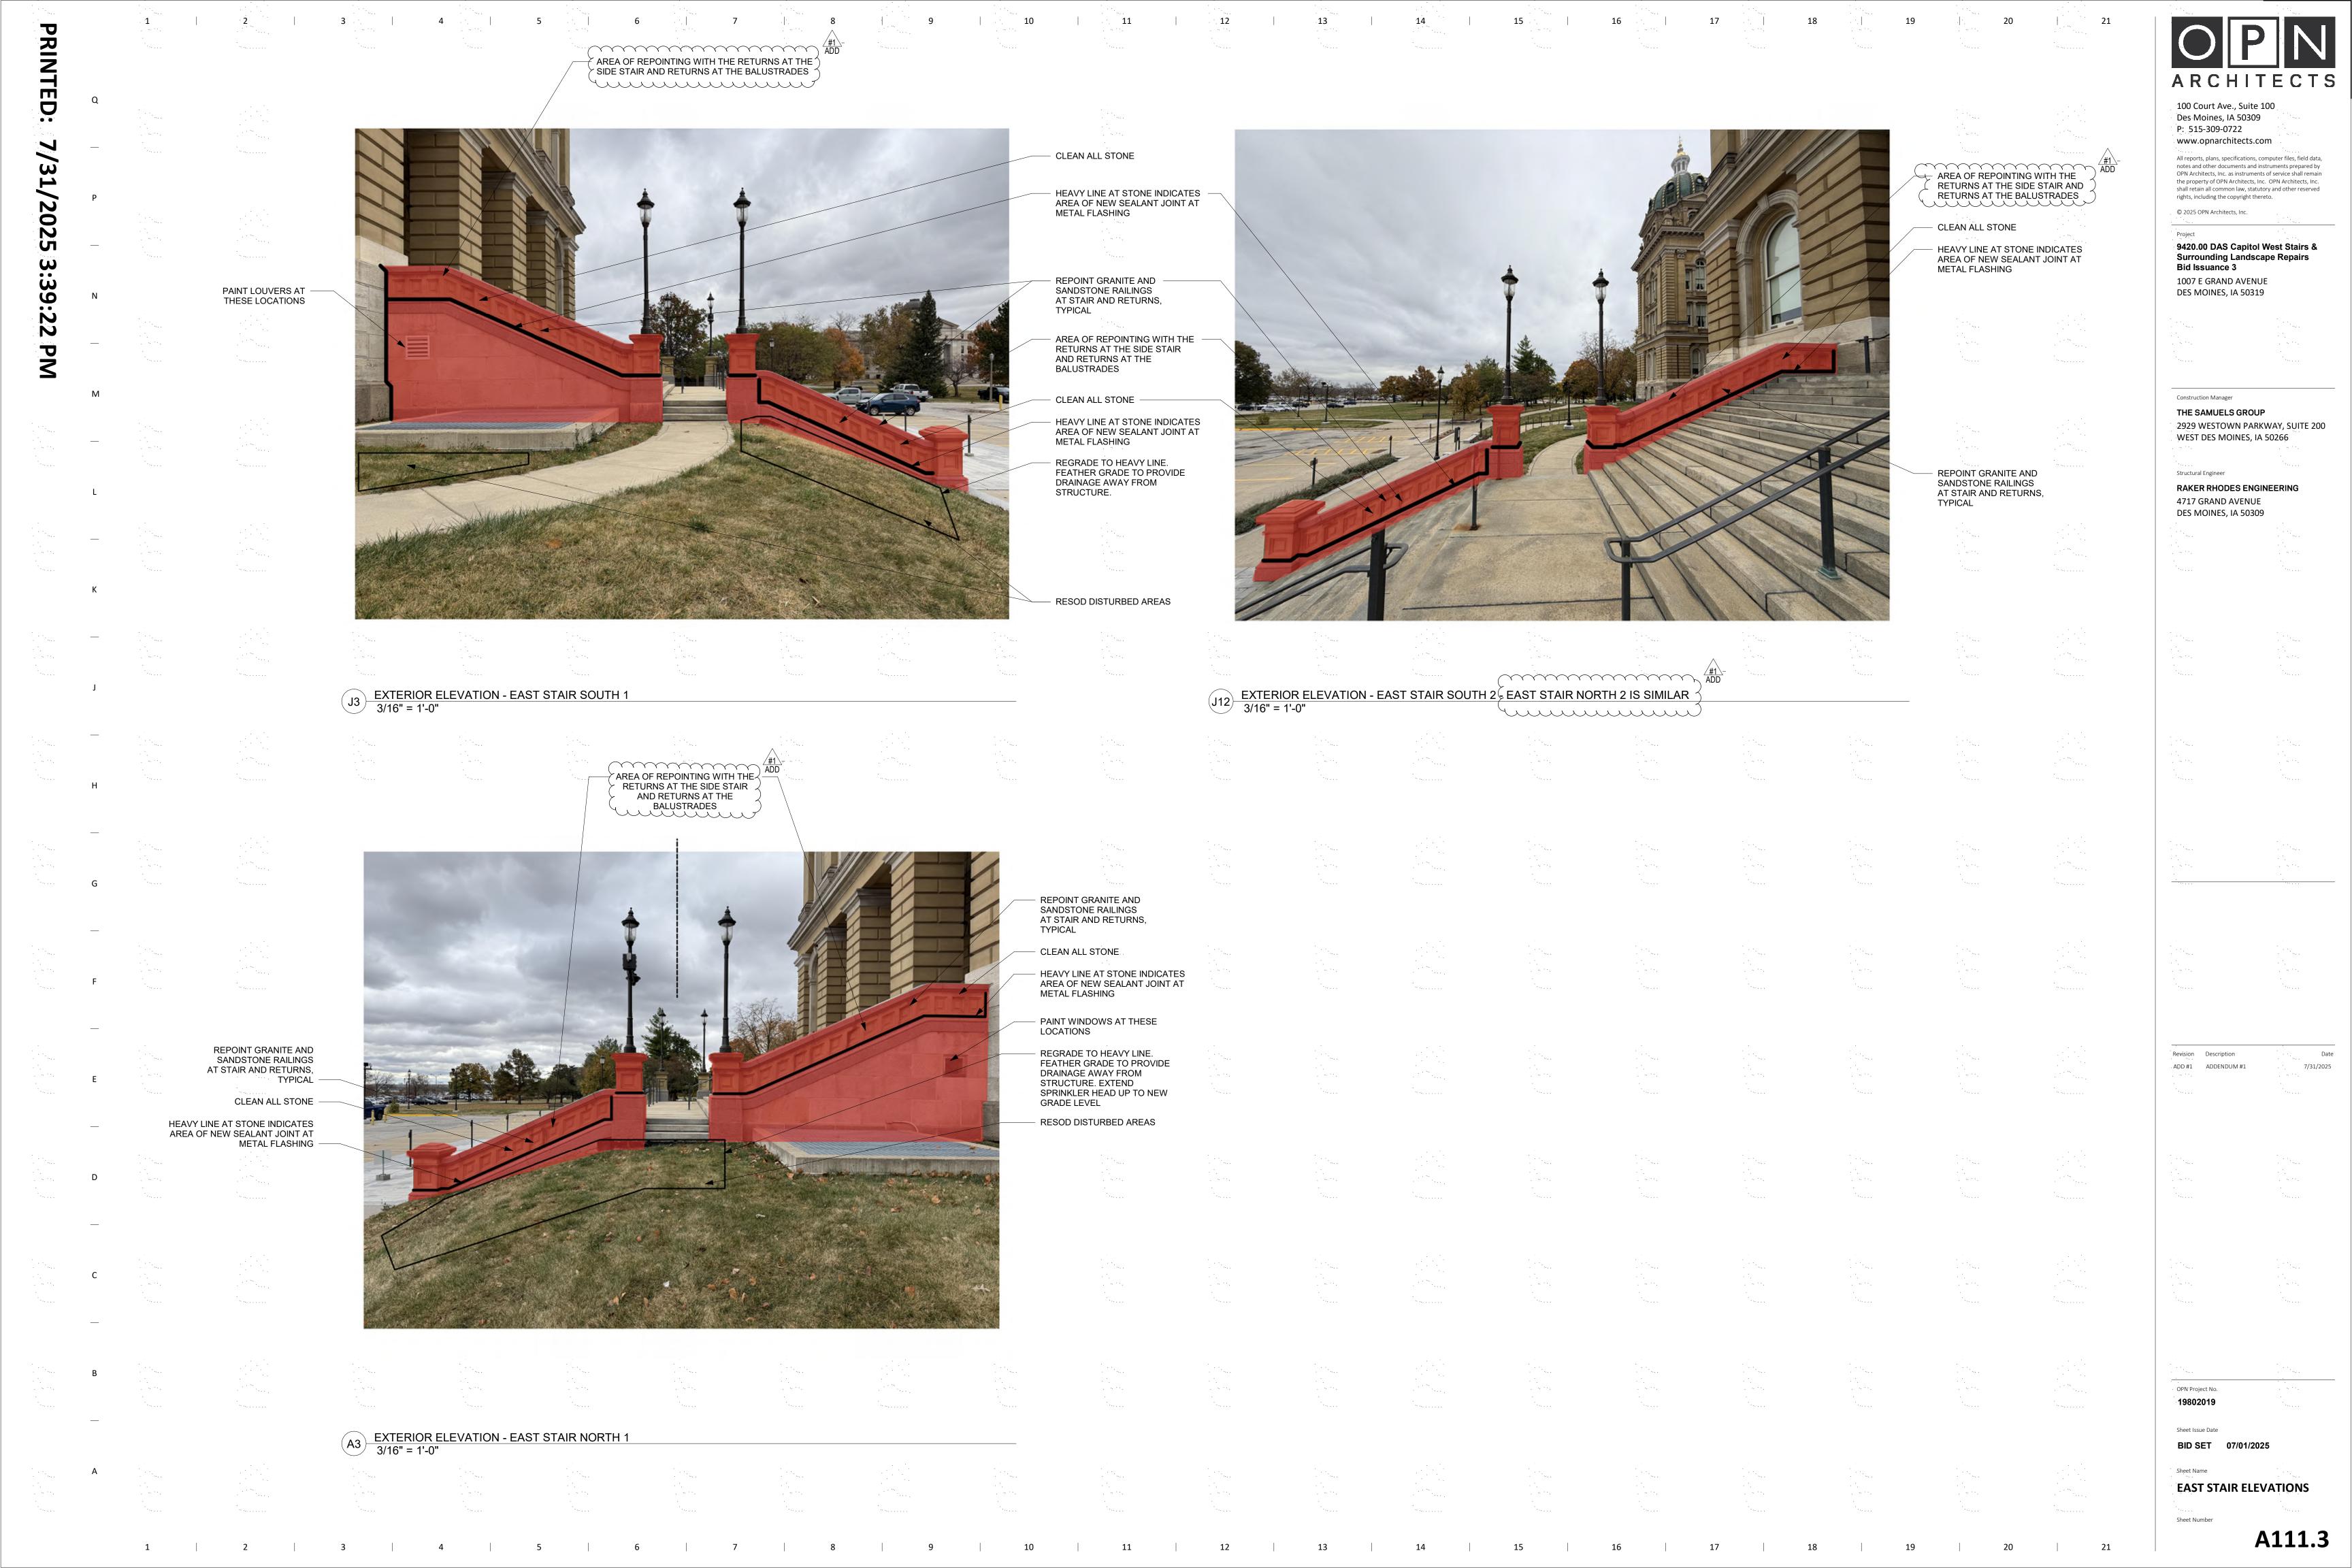

100 Court Ave., Suite 100

All reports, plans, specifications, computer files, field data, notes and other documents and instruments prepared by OPN Architects, Inc. as instruments of service shall remain the property of OPN Architects, Inc. OPN Architects, Inc. shall retain all common law, statutory and other reserved

9420.00 DAS Capitol West Stairs & Surrounding Landscape Repairs

2929 WESTOWN PARKWAY, SUITE 200

RAKER RHODES ENGINEERING

A120.3