

# ADDENDUM NO. 1

Date: February 07, 2020

Project: IA DAS – Eldora STS Decentralization Building Package DAS RFB #898201-01 DAS Project 8982.01

\*\*\*Bid date has changed from February 11, 2020 to February 18, 2020 by 2:00pm \*\*\*

Questions due date has changed from February 5, 2020 to February 11, 2020 by 2:00pm. All questions must follow the procedure in Specification 00 2113 and be submitted to the Purchasing Agent.

# QUESTIONS AND ANSWERS FROM THE PRE-BID MEETING:

- Q1. In spec section 09 5100, ACP 2 is called out as a 24"x 48" however on drawing 03-A1.02 detail D4: Ground Floor Ceiling Plan has the ACP 2 panels in the kitchen drawn ad a 24" x 24" panel. Please confirm what size these need to be.
- A1. Refer to revisions in spec section 08 5100 and sheet 03-A1.02.
- Q2. For those same ACP 2 panels in the kitchen, the spec calls out for a USG Mars Ceiling tile. Usually in a kitchen or bathroom, the USG Sheetrock Lay-in panels are typically used because they are intended to be cleaned/whipped down if needed (see attached data page). They are a 5/8" drywall with a vinyl face on them so they can be cleaned. Please let me know which tile option you would like for that Kitchen area.
- A2. Refer to revisions in spec section 08 5100 and sheet 03-A1.02.
- Q3. On drawing 04-A1.02, the reflected plan only says "New ACP", but does not indicate which type. I assume this is to be ACP-1, but I wanted to verify. Please let me know which tile type you want in this area.
- A3. Refer to revised sheet 04-A1.02.
- Q4. Please clarify responsibilities of packaged RTU controls points integration.
- A4. The RTU manufacturer shall provide BACnet points list or PICS files to the BAS vendor for integration.
- Q5. As related to the asbestos abatement included in BP 02-1, who will the air clearances be determined by?
- A5. Shive-Hattery will conduct air monitoring and clearances.

2810 Wakefield Circle, Ames, IA 50010 phone 515.232.4358 fax 515.232.0599 www.storycon.com

# SPECIFICATIONS ITEMS:

# 1. 00 0110 – Table of Contents Summary

- **a. ADD** Under Paragraph 2.013 Specification '23 2214 Steam and Condensate Heating Specialties'.
- b. ADD Under Paragraph 2.014 Specification '26 2923Veriable-Frequency Motor Controllers'.

# 2. 00 1113 – Notice to Bidders

a. DELETE 'Bids must be received no later than 2:00 pm, local time, Tuesday, February 11, 2020' and REPLACE with 'Bids must be received no later than 2:00 pm, local time, Tuesday, February 18, 2020'.

# 3. 00 2113 – Instruction to Bidders

- a. Paragraph 3.06, B., 1. DELETE 'February 11, 2020' and REPLACE with 'February 18, 2020'.
- b. Paragraph 3.010, A. DELETE 'February 5, 2020' and REPLACE with 'February 11, 2020'.
- c. Paragraph 3.011, A. DELETE '2:00pm, February 5, 2020' and REPLCE with 'February 11, 2020'.
- 4. 00 4116 Bid Form
  - a. **REPLACE** this section in its entirety attached.

# 5. 01 1200 – Contract Summary

a. **REPLACE** this section in its entirety – attached.

# 6. 08 5100 – Acoustical Ceilings

- a. ADD Paragraph 2.2.C to provide washable 2x2 ACP ceilings:
  - C. Acoustical Panels, Type ACP3: Mineral fiber with membrane-faced overlay, with the following characteristics:
    - 1. Classification: ASTM E1264 Type IV.
      - a. Form: 1 and 2.
      - b. Pattern: "E" lightly textured.
    - 2. Size: 24 by 24 inches.
    - 3. Thickness: 3/4 inch.
    - 4. Light Reflectance: Minimum 85 percent, determined in accordance with ASTM E1264.
    - 5. NRC Range: 70 to 80, determined in accordance with ASTM E1264.
    - 6. Ceiling Attenuation Class (CAC): Minimum 30, determined in accordance with ASTM E1264.
    - 7. Panel Edge: Square.
    - 8. Suspension System: Exposed grid.
    - 9. Basis of Design Product:
      - a. USG Corporation; Mars Acoustical Panels: www.usg.com.
      - b. Or architect pre-approved equivalent.

# 7. 22 3000 - Plumbing Equipment

a. ADD paragraph 2.1.H which reads: "Furnish and install, as shown on plans, a buffer tank on the hot side of the heat exchanger. The unit shall have flanged, NPT, or grooved inlet and outlet connections. An NPT vent connection shall be fitted to the top and an NPT drain connection shall be fitted to the bottom of the vessel. Provide with 2 ports. The Buffer Tank must be designed, constructed, and stamped for 125 psig @ 450°F (232°C) in accordance

Page 2 of 10

2810 Wakefield Circle, Ames, IA 50010 phone 515.232.4358 fax 515.232.0599 www.storycon.com

with ASME section VIII, Division 1 of the ASME Boiler and Pressure Vessel Code, and registered with the National Board of Boiler and Pressure Vessel Inspectors. The Buffer Tank shall be painted with one shop coat of red oxide primer. A manufacturers' Data Report for Pressure Vessels, Form U-1A as required by the provisions of the ASME Boiler and Pressure Vessel Code shall be furnished for each unit upon request."

# 8. 23 5215 – Fire Tube Condensing Boilers

- a. **REMOVE** Cleaver-Brooks from approved manufacturers.
- **b. CLARIFICATION** of paragraph 2.4 and 2.5. Separate boiler control panel is not required if the boilers have built-in functionality for staging and controlling all boilers.
- c. ADD paragraph 2.6.A.14 under ACCESSORIES which reads: "Motorized Isolation Valves."

# 9. 23 7413 – Packaged Rooftop Air Conditioning Units

- **a. ADD** paragraph 2.9.D which reads: "Provide single-stage, on/off hot gas reheat option to provide increased dehumidification. The option shall consist of a hot-gas reheat coil located on the leaving air side of the evaporator coil prepiped and circuited. The option shall be equipped with crankcase heater(s), low pressure switch(es), controls including room humidistat, and a thermostatic expansion valve(s) (TXV) as required for full dehumidification operation."
- **b. DELETE** paragraph 3.3.K
- c. DELETE paragraph 3.3.L

# 10. 26 2923 – Variable-Frequency Motor Controllers

**a. ADD** this section in its entirety – attached.

# DRAWING ITEMS:

1. DRAWINGS

# a. SHEET - 02-AD-02 - SECOND FLOOR - REFLECTED CEILING DEMOLITION PLAN

- i. **REVISE –** 4C SECOND FLOOR REFLECTED CEILING DEMO PLAN to remove ceiling work from CLOSET 3-304 & BATHROOM 3-305.
- ii. **REVISE –** 4E SECOND FLOOR –DEMO PLAN to add keynote AD33 and revise scope of work in CLOSET 3-304 & BATHROOM 3-305.
- iii. **REVISE DEMO KEYNOTE LEGEND to include keynote AD33**.

# b. SHEET – 02-A1-01 - COTTAGE 3 & 4 FLOOR PLANS

- i. **REVISE –** A3 SECOND FLOOR RCP to remove ceiling from CLOSET 3-304 & remove new demising wall between BATHROOM 3-305 & CLOSET 3-304.
- ii. **REVISE –** 1 SECOND FLOOR PLAN Copy 1 to remove new demising wall between BATHROOM 3-305 & CLOSET 3-304.
- iii. REVISE 1 SECOND FLOOR PLAN Copy 1 to add keynote A59 to BATHROOM 3-305.
- iv. **REVISE –** ARCHITECTURAL KEYNOTE LEGEND to include keynote A59.

Page 3 of 10

2810 Wakefield Circle, Ames, IA 50010 phone 515.232.4358 fax 515.232.0599 www.storycon.com

- v. REVISE B4 GROUND FLOOR REFLECTED CEILING PLAN to call for NEW ACP1 at LAUNDRY 4-109, shaded area in LOCKER ROOM 3-111 and shared areas in LOCKER ROOM 4-111.
- c. SHEET 03-A1-02 COTTAGE 5 & RECEIVING CEILING PLANS
  - i. **REVISE –** D4 GROUND FLOOR CEILING PLAN to call for NEW ACP3 at KITCHEN 5-101 and KITCHEN 6-101.
- d. SHEET 04-A1-02 COTTAGE 7 & 8 CEILING PLANS
  - i. **REVISE –** A4 FIRST FLOOR CEILING PLAN to call for NEW ACP1 at SLEEPING 7-201, SLEEPING 8-201, OFFICE 8-211 AND OFFICE 8-212.
- e. SHEET 10-A1-01 CANTEEN FIRST FLOOR PLAN
  - i. **REVISE –** A4 FIRST FLOOR CEILING PLAN to call for NEW ACP1 at CANTEEN 1.
- f. SHEET 01-M1.01 SCHOOL MECHANICAL PLAN MECHANICAL ROOM
  - i. REVISE Heating water coils and associated keynotes on AHU-5.
- g. SHEET 01-M5.00 SCHOOL MECHANICAL DETAILS
  - i. REVISE Annotation on B1 Boiler Piping Detail
  - ii. REVISE Flow and EWT on HX-1 on Heating Water Schematic.
- h. SHEET 01-M5.01 SCHOOL MECHANICAL DETAILS
  - i. **REVISE** Detail A1 AHU HEATING WATER COIL PIPING DEAIL FOR MULTIPLE COILS.
  - ii. REVISE Heating Water Return temperature to 120°F

# i. SHEET- 01-M6.00 SCHOOL MECHANICAL SCHEDULES

- i. ADD Note 3 to GLYCOL FEED SCHEDULE.
- ii. **REVISE –** NOTE 4, GPM, HEAD, SHUTOFF HEAD and BHP on P-4 and P-5 on MECHANICAL PUMP SCHEDULE.
- iii. ADD -NOTE 2 on AIR HANDLIND UNIT REPLACEMENT HEATING COIL HOT WATER SCHEDULE.
- iv. REVISE HC-5A and HC-5B on AIR HANDLIND UNIT REPLACEMENT HEATING COIL HOT WATER SCHEDULE.
- v. ADD HC-5C on AIR HANDLIND UNIT REPLACEMENT HEATING COIL HOT WATER SCHEDULE.
- vi. REVISE HX-1 on HEAT EXCHANGER PLATE AND FRAME SCHEUDLE.

Page 4 of 10

2810 Wakefield Circle, Ames, IA 50010 phone 515.232.4358 fax 515.232.0599 www.storycon.com

- j. SHEET 02-M1.01 COTTAGE 3 & 4 MECHANICAL PLANS FIRST FLOOR & SECOND FLOOR.
  - i. REVISE GF3-1 Location
  - ii. ADD Keynote M-02-22

# k. SHEET - 02-M5.00 COTTAGE 3 & 4 MECHANICAL DETAILS & CONTROLS

- i. REVISE Detail C1 GAS PIPING SCHEMATIC
- ii. REVISE Detail C4 SENSORY ROOM TEMPERATURE CONTROL
  - 1. Provide flat-plate sensor without user adjustment in lieu of thermostat
- iii. **REVISE** Detail B1 TYPICAL FURNACE INSTALLATION SCHEMATIC AND CONTROLS
  - 1. Remove mixed air damper and revise sequence to match 2-position damper control.
- iv. ADD Detail ELECTRIC UNIT HEATER CONTROL
- v. MOVE GAS CONNECTION DETAIL to sheet 02-M6.00

# I. SHEET – 02-M6.00 COTTAGE 3 & 4 MECHANICAL SCHEDULES

- i. REVISE NOTES 2, 3, & 9 on PACKAGED ROOFTOP UNIT SCHEDULE
- m. SHEET 02-P1.01 COTTAGE 3 & 4 PLUMBING PLAN GROUNF FLOOR AND SECOND FLOOR
  - i. **REVISE** Domestic water and fire protection layout.
  - **ii. ADD –** Keynotes P-02-09 and P-02-10

# n. SHEET - 02-P6.00 COTTAGE 3 & 4 PLUMBING SCHEDULES & DETAILS

- i. REVISE BACKFLOW PREVENTER DEATIL
- ii. ADD SIDEWALK SIAMESE FIRE DEPARTMENT CONNECTION DETAIL

# o. SHEET – 02-PD.01 COTTAGE 3 & 4 PLUMBING DEMOLITION PLAN

- i. **REVISE** Demolition of piping at tunnel level.
- ii. ADD Keynotes PD-02-05, PD-02-06, PD-02-07

# p. SHEET - 03-M1.01 COTTAGE 5 & RECEIVING MECHANICAL GROUND FLOOR PLANS

- i. ADD Annotation furnace intake duct.
- ii. ADD OA Intake for GF6-1 and keynote M-03-14.

#### Page 5 of 10

2810 Wakefield Circle, Ames, IA 50010 phone 515.232.4358 fax 515.232.0599 www.storycon.com

# q. SHEET – 03-M1.02 COTTAGE 5 & RECEIVING MECHANICAL PLAN FIRST AND SECOND FLOORS

i. ADD – Annotation on existing duct to new furnace.

#### r. SHEET – 03-M5.00 COTTAGE 5 & RECEIVING MECHANICAL DETAILS

i. ADD - NEW LAUNDRY FURNACE INSTALLATION DETAIL

# s. SHEET - 03-M5.01 COTTAGES 5 & RECEIVING MECHANICAL CONTROLS

- i. REVISE Detail A4 ERV INTEGRATION SCHEMATIC
  - 1. Add humidity sensor
- **ii. REVISE –** Detail C1 SENSORY ROOM TEMPERATURE CONTROL
  - 1. Provide flat-plate sensor without user adjustment in lieu of thermostat
- iii. REVISE Detail C4- RTU INTEGRATION SCHEMATIC
  - 1. Add humidity sensor
- iv. REVISE A1a TYPICAL FURNACE CONTROL SCHEMATIC & SEQUENCE
  - 1. Remove mixed air damper and revise sequence to match 2-position damper control.
- v. ADD Detail ELECTRIC UNIT HEATER CONTROL

# t. SHEET - 03-M6.00 COTTAGE 5 & RECEIVING MECHANICAL SCHEDULES

i. REVISE - NOTES 2, 3, 9, & 11 on PACKAGED ROOFTOP UNIT SCHEDULE

# u. SHEET - 04-M1.01 COTTAGE 7 & 8 MECHANICAL GROUND FLOOR PLANS

- i. ADD Annotation furnace intake duct.
- ii. ADD OA Intake for GF8-1 and keynote M-04-12

#### v. SHEET - 04-M5.00 COTTAGE 7 & 8 MECHANICAL DETAILS

i. ADD – NEW LAUNDRY FURNACE INSTALLATION DETAIL

#### w. SHEET - 04-M5.01 COTTAGES 5 & RECEIVING MECHANICAL CONTROLS

- i. REVISE Detail A4 ERV INTEGRATION SCHEMATIC
  - 1. Add humidity sensor
- ii. REVISE Detail C1 SENSORY ROOM TEMPERATURE CONTROL
  - 1. Provide flat-plate sensor without user adjustment in lieu of thermostat
- iii. REVISE Detail C4- RTU INTEGRATION SCHEMATIC
  - 1. Add humidity sensor

Page 6 of 10

2810 Wakefield Circle, Ames, IA 50010 phone 515.232.4358 fax 515.232.0599 www.storycon.com

- iv. REVISE A1a TYPICAL FURNACE CONTROL SCHEMATIC & SEQUENCE
  - 1. Remove mixed air damper and revise sequence to match 2-position damper control.
- v. ADD Detail ELECTRIC UNIT HEATER CONTROL

#### x. SHEET - 04-M6.00 COTTAGE 7 & 8 MECHANICAL SCHEDULES

i. REVISE - NOTES 2, 3, 9, & 11 on PACKAGED ROOFTOP UNIT SCHEDULE

#### y. SHEET - 08-M1.01 ADMINISTRATION BUILDING MECHANICAL PLAN GROUND FLOOR

i. REVISE - Tag on steam unit heater to SUH-1

# z. SHEET - 08-M6.00 ADMINISTRATION BUILDING MECAHNICAL SCHEDULES

- i. REVISE Tag SUH-1 in UNIT HEATER SCHEDULE-STEAM
- **ii. ADD** note 3. to FEEDWATER PUMP SCHEDULE which reads: "INTERLOCK PUMP OPERATION WITH BOILER LOW WATER FEED CONTROL."

# aa. SHEET - 09-M5.00 A.E. SHEPHERD MECHANICAL DETAILS

- i. REVISE THERMOSTATIC MIXING VALVE SCHEMATIC
- ii. REVISE ELECTRIC WATER HEATER PIPING DETAIL

# bb. SHEET - 10-M1.01 CANTEEN MECHANICAL LAYOUT

**i. REVISE** – Size of NG piping.

# cc. SHEET - 10-MD.01 CANTEEN MECHANICAL DEMOLITION

i. ADD – Keynote MD-10-08

# dd. SHEET - 10-P1.01 CANTEEN PLUMBING DEMOLITION AND NEW WORK PLAN

# ee. ADD SHEET - 02-M6.00 COTTAGE 3 & 4 MECHANICAL SCHEDULES

- i. REVISE NOTE 2 on PACKAGED ROOFTOP UNIT SCHEDULES
- ii. ADD Keynote PD-10-02

# ff. SHEET - 11-M1.01 KITCHEN & STORAGE MECHANICAL GROUND FLOOR PLAN

- i. **REVISE** Unit heater tags to "HWUH-XX".
- gg. SHEET 11-M1.02 KITCHEN & STORAGE MECHANICAL FIRST AND SECOND FLOOR PLAN
  - i. **REVISE** Unit heater tags to "HWUH-XX".

# hh. SHEET – 11-M5.02 KITCHEN & STORAGE MECAHNICAL SCHEMATIC

Page 7 of 10

2810 Wakefield Circle, Ames, IA 50010 phone 515.232.4358 fax 515.232.0599 www.storycon.com

i. **REVISE** – Unit heater tags to "HWUH-XX"

# ii. SHEET - 11-M6.00 KITCHEN & STORAGE MECHANICAL SCHEDULES

- i. REVISE Unit heater tags to "HWUH-XX"
- ii. ADD Note 3 to GLYCOL FEED SYSTEM SCHEDULE

### jj. SHEET - 11-P5.00 KITCHEN & STORAGE PLUMBING DETAILS & SCHEDULES

i. **REVISE** – HIGH EFFICIENCY GAS-FIRED WATER HEATER DETAIL to show preassembled water heater stand.

# kk. SHEET - 19-MD.01 VOCATIONAL MECHANICAL DEMOLITION PLAN

- i. **REMOVE** existing unit heater from above 106 OFFICE space.
- II. SHEET 19-PD.01 VOCATIONAL PLUMBING DEMOLITION
  - i. ADD Existing floor drain.

# mm. SHEET – 19-P1.01 VOCATIONAL PLUMBING PLAN

i. ADD – Existing floor drain.

# nn. SHEET – 21-M1.01 GENERAL SUPPLY MECHANICAL PLAN

- i. REVISE Location of gas meter.
- **ii. REVISE** GAS PIPING SCHEMATIC.

# 2. APPROVED SUBSTITUTIONS

SPECIFICATION SECTION	PRODUCT	APPROVED SUBSTITUTION
22 1123	Domestic Water Circ Pumps	Wilo Pumps – Stratos Model
22 3000	Domestic Water Heat Exchangers	AERCO Model SPDW23
22 3300	Electric Water Heater	Bock; nDurance
22 3400	Gas Fired Water Heaters	Bock; Optitherm
23 2123	Hydronic Pumps	Wilo Pumps - Models IL & NL
23 5215	Fire Tube Condensing Boilers	Fulton Endura
23 5215	Fire Tube Condensing Boiler	RBI Flexcore Condensing Boiler Model CK2500

Page 8 of 10

2810 Wakefield Circle, Ames, IA 50010 phone 515.232.4358 fax 515.232.0599 www.storycon.com

23 5216	Steel Water-Tube Boilers	RBI Infinite Energy Model IB399
23 5233	Steel Water-Tube Boilers	Rite 15 psi Low Pressure Steam Boilers – Model 48S
23 7223	ERV	Carrier
23 7413	Packaged Rooftop A/C Units	ClimateMaster Models RGED & RKRL
23 7413	RTU	Carrier
23 7414	AHU-1	Carrier
23 8200	Electric Baseboard	Indeeco Electric Baseboard Model BBI
23 8200	Electric Unit, Baseboard & Cab Unit Heaters	Brasch
23 8200	Hydronic Unit Heaters	Zehnder Rittling
23 8200	Hydronic Cab Heater	Zehnder Rittling
23 8200	Electric Cabinet Unit Heaters	Markel
23 8200	Electric Baseboard and Cabinet Unit Heaters	Redd-I; TPI Corp.
23 8200	Electric Baseboard	Markel
N/A	Variable Frequency Drives	Danfoss – VLT HVAC
M6.00	Replacement Heating Coils	Heatcraft

ATTACHMENTS:

- 1. Specification Section 00 4116 BID FORM
- 2. Specification Section 01 1200 CONTRACT SUMMARY
- 3. Specification Section 23 2214
- 4. Specification Section 26 2923
- 5. 02-A1.01
- 6. 02-AD.02
- 7. 03-A1.02
- 8. 04-A1.02
- 9. 10-A1.01
- 10. 01-M1.01
- 11. 01-M5.00
- 12. 01-M5.01
- 13. 01-M6.00
- 14. 02-M1.02

Page 9 of 10

2810 Wakefield Circle, Ames, IA 50010 | phone 515.232.4358 | fax 515.232.0599 | www.storycon.com

15.	02-M5.00
16.	02-M6.00
17.	02-P1.01
18.	02-P6.00
19.	02-PD.01
20.	03-M1.01
21.	03-M1.02
22.	03-M5.01
23.	03-M5.00
24.	03-M6.00
25.	04-M1.01
26.	04-M5.01
27.	04-M5.00
28.	04-M6.00
29.	08-M1.01
30.	08-M6.00
31.	09-M5.00
32.	10-M1.01
33.	10-MD.01
34.	10-P1.01
35.	11-M1.01
36.	11-M1.02
37.	11-M5.02
38.	11-M6.00
39.	11-P5.00
40.	19-MD.01
41.	19-P1.01
42.	19-PD.01
43.	21-M1.01

END OF ADDENDUM

Page 10 of 10

2810 Wakefield Circle, Ames, IA 50010 | phone 515.232.4358 | fax 515.232.0599 | www.storycon.com

#### **SECTION 00 4116**

#### **BID FORM**

#### RFB #898201-01

#### BID FORM for CONSTRUCTION CONTRACT for State Training School for Boys 3211 Edgington Avenue, Eldora, Iowa 50627

Project 8982.01

Iowa Department of Administrative Services GSE-Central Procurement Bureau Hoover State Office Building, Level 3 1305 East Walnut Street Des Moines, Iowa 50319-0105

The following documents are to be completed and submitted with your bid.

- 1. Bid Proposal Form (Required)
- 2. Non Discrimination Clause Form
- 3. Contractor Targeted Small Business Enterprise Pre-Bid Contract Information Form
- 4. Bid Security 5% of total Bid amount (Is to be submit in separate envelope) (Required)

#### Authorized Representative:

The undersigned Bidder, in response to your Request for Bid for construction of the above project, having examined the Drawings, Specifications, and other Bidding Documents dated January 6, 2020 and Addenda issued and acknowledged below as received and being familiar with all the conditions surrounding the construction of the proposed project including the availability of materials and labor, hereby proposes to furnish all labor, materials, equipment and supplies to perform all work to construct the project in strict accordance with the proposed Contract Documents, within the time and at the prices stated below. Prices are to cover all expenses incurred in performing the work required under the proposed Contract Documents, of which this bid is a part.

Bidder acknowledges receipt of the following Addenda which are a part of the Bidding Documents and for which any effect on cost of the Work is included in the bid amounts indicated:

Addendum No	Dated
Addendum No	Dated
Addendum No	Dated
Addendum No	Dated
Addendum No.	Dated

Note that the State of Iowa is exempt from State and Local sales and use taxes (including local option and school option) for this project. Taxes on construction materials shall NOT be included in the bid amounts.

Amounts shall be indicated in both words and figures. In case of discrepancy, the amount indicated in words shall govern.

#### BID PACKAGES:

BP #02-1

Description: Asbestos abatement at the administrative building, canteen building, kitchen building and power plant building.

Bidder proposes and agrees to perform all Base Bid work as described in the Construction Documents for the sum of:

UNIT PRICE	DESCRIPTION	QUANTITY	UNIT PRICE	TOTAL PRICE
#01	Asbestos Abatement of Thermal	3,000 LF	\$	\$
#02	Asbestos Abatement of Floor Tile and Mastic	1,400 SF	<u>*</u> \$	<u>*</u>
#03	Asbestos Abatement of Plaster Ceilings	460 SF	\$	\$
#04	Asbestos Abatement of Drywall Walls and Ceilings	2,000 SF	<u>\$</u>	\$
#05	Asbestos Spot Abatement of Plaster Walls and Ceilings	12 EA.	\$	\$
#06	Site Mobilization for Abatement	7 EA.	<u>\$</u>	\$
			TOTAL OF BID	\$

# BP #09-1

Description: Framing, drywall, painting, ceilings and doors.

Bidder proposes and agrees to perform all Base Bid work as described in the Construction Documents for the sum of:

Dollars

(\$\_\_\_\_\_). This sum includes an Owner's Allowance #01 in the amount of

\$80,000.

BP #09-1 Alternate #01

Description: Bulkheads in Cottages 5, 7, 8 and Receiving.

Bidder proposes and agrees to perform all work as described in the Construction Documents for the sum of:

Dollars

(\$\_\_\_\_\_).

BP #09-1 Alternate #03

Description: Sensory Room Buildouts.

Bidder proposes and agrees to perform all work as described in the Construction Documents for the sum of:

(\$\_\_\_\_\_).

# BP #23-1

Description: Mechanical, Plumbing, Demo, Concrete and Masonry.

Bidder proposes and agrees to perform all work as described in the Construction Documents for the sum of:

(\$\_\_\_\_\_). This sum includes an Owner's Allowance #02 in the amount of

\$20,000.

BP #23-1 Alternate #02

Description: Ductwork Cleaning in Cottages.

Bidder proposes and agrees to perform all work as described in the Construction Documents for the sum of:

Dollars

(\$\_\_\_\_\_).

BP #23-1 Alternate #03

Description: Sensory Room Buildouts.

Bidder proposes and agrees to perform all work as described in the Construction Documents for the sum of:

Dollars

Dollars

Dollars

(\$\_\_\_\_\_).

BP #26-1

Description: Electrical and man-down system.

Bidder proposes and agrees to perform all work as described in the Construction Documents for the sum of:

		D
	).	
BP #	26-1 Alternate #03	
Dese	cription: Sensory Room Buildouts.	
	er proposes and agrees to perform all work as described in the Construction Docume sum of:	۶n
		D
(\$	).	
BP #	26-1 Alternate #04	
Dese	cription: Man Down Additional Hardware.	
	er proposes and agrees to perform all work as described in the Construction Docume sum of:	n
		D
(\$	).	
BP #	26-1 Alternate #05	
Desc	cription: Man Down Front-End Software Upgrade.	
	er proposes and agrees to perform all work as described in the Construction Docume sum of:	ent
		D
BP #	26-1 Unit Price #05	
Dese	cription: Security System Transponders.	
	er proposes and agrees to perform all work as described in the Construction Docume sum of:	۶n
		D

BP #26-1 Unit Price #06

Description: Internal Security System Receivers.

Bidder proposes and agrees to perform all work as described in the Construction Documents for the sum of:

(\$).

ΒP	#26-1	Unit	Price	#07
	π <b>∠</b> Ο Ι	Onit	1 1100	<i>m</i> 01

Description: External Security System Receivers.

Bidder proposes and agrees to perform all work as described in the Construction Documents for the sum of:

		Dollars
(\$	)	

Bidder hereby certifies that:

- 1. This bid is genuine and is not made in the interest of or on behalf of any undisclosed person, firm or corporation;
- 2. Bidder has not directly or indirectly induced or solicited any other bidder to put in a false or sham bid; Bidder has not solicited or induced any person, firm or corporation to refrain from bidding; and Bidder has not sought by collusion to obtain any advantage over any other bidder or over the Owner.
- 3. Bidder hereby certifies that the Bidder is registered with the Iowa Labor Commissioner as a Contractor as required by Chapter 91C, Code of Iowa.
- 4. Bidder agrees to comply with all Federal and State Affirmative Action/Equal Employment Opportunity requirements concerning fair employment and will not discriminate between or among them by reason of race, color, religion, sex, national origin or physical handicap.
- 5. All construction under this Contract shall conform to the requirements of the *Iowa State Building Code*.
- 6. Bidder agrees that this bid shall remain valid and shall not be withdrawn for a period of thirty (30) calendar days after the date for receipt of bids.
- 7. Bidder agrees that if written notice of acceptance of this bid is mailed, emailed, or delivered to the undersigned within thirty (30) days after the date in which bids are due, or at any time thereafter before it is withdrawn, the undersigned will sign and return the Contract Agreement, prepared in accord with the Bidding Documents and this bid as accepted; and will also provide proof of insurance coverage and required surety bonds.
- 8. Bidder understands that the Owner reserves the right to reject any and all bids, and to waive irregularities or informalities and enter into a contract for the work, as the Owner deems to be in the best interest of the State.
- Bidder understands that the Owner reserves the right to accept any, or no, Alternate Bid, if requested, and that the Alternate Bids may be considered in any order or combination, and the low Bidder shall be determined on the basis of the sum of the base bid and any Alternate(s) accepted.

Dollars

#### Subcontractors:

The Trade Contractor must identify all Subcontractors and Suppliers within 48 hours of the published date and time for which bids must be submitted, in accordance with Iowa Code Section 8A311, as amended by House File 646 in 2011. Subcontractors and suppliers may not be changed without the approval of the Owner. Requests for changing a Subcontractor or supplier must identify the reason for the proposed change, the name of the new Subcontractor or supplier, and the change in the subcontractor or supplier price as a result of the change. Any reduction in subcontractor or supplier price as a result of the change, if the change is approved by the Owner, shall be deducted from the Trade Contract Price via a deductive Change Order. Any such changes, if approved by the Owner, which result in an increase in the Trade Contract Price shall be borne by the Trade Contractor.

#### Enforcement of Reciprocal Resident Bidder Preference, per Iowa Code 73A.21.

All bidders shall either check the box next to "Resident Bidder" or check the box next to "Nonresident Bidder" and by doing so and signing thereafter certifies and attests to the same. All information requested must be provided. Seek out the advice of an attorney if you have questions.

"Resident Bidder" means a person or entity authorized to transact business in of the State of Iowa and having a place of business for transacting business within the State of Iowa at which it is conducting and has conducted business for at least three years prior to the date of the first advertisement for the public improvement. Note, however, that if a nonresident bidder's state or foreign country has a more stringent definition of a resident bidder, the more stringent definition is applicable as to bidders from that state or foreign country.

Resident Bidder

Name of Resident Bidder: \_\_\_\_\_

By: \_\_\_\_\_ Authorized Agent and Signatory of Resident Bidder

OR:

Nonresident Bidder
--------------------

Name of Nonresident Bidder: \_\_\_\_\_

Name of State or Foreign Country of Nonresident Bidder:

Particularly identify and describe any preference, labor preference, or any other type of preferential treatment, in effect in the nonresident bidder's state or foreign country at the time of this bid:

NOTICE: Nonresident Bidders domiciled in a state or country with a resident labor force preference shall make and keep, for a period of not less than three years, accurate records of all workers employed on the public improvement. The records shall include each worker's name, address, telephone number when available, social security number, trade classification, and the starting ending time of employment.

By: \_

Authorized Agent and Signatory of Nonresident Bidder

Bid Form shall be signed by an officer of the company with authority to bind in a contract. Notice of acceptance of this bid, or request for additional information by the Department of Administrative Services, may be addressed to the undersigned at the address set forth below:

Legal Name of Firm:			
Date:			
Signature of Bidder:			
Title:			
Typed Name of Signatory:			
Email:			
Business Address:			
Telephone Number:	Fax Number:		
Federal Tax Identification Number:			
Iowa Contractor Registration Number:			
Bidder Safety Manager Name:			
For an out-of-state Bidder, Bidder certifies that	t the Resident Preference	e given by the	ne State or
Foreign Country of Bidder's residence,		, is	_%.

END OF SECTION

# **SECTION 01 1200**

# **CONTRACT SUMMARY**

# PART 1 - GENERAL

# 1.01 SECTION INCLUDES

- A. Project Information
- B. Project Summary
- C. Bid Scope Summary
- D. Work Hour Restrictions
- E. Access to Site
- F. Coordination with Occupants
- G. Rules for Construction Workers
- H. Bid Package Instructions

# 1.02 PROJECT INFORMATION

- A. Facility Name/Location: 3211 Edgington Avenue, Eldora, Iowa 50627
- B. DAS Project #: 8982.01
- C. Owner: State of Iowa, Department of Administrative Services, Hoover State Office Building, Level 3, 1305 East Walnut Street, Des Moines, IA 50319
- D. Owner's Representative: Jennifer Kleene, Iowa Department of Administrative Services, 109 SE 13th Street, Des Moines, IA 50319
- E. Construction Manager: Jeffrey Reams, Story Construction Co., 2810 Wakefield Circle, Ames, IA 50010

# 1.03 PROJECT SUMMARY

- A. The project includes, but is not limited to:
  - 1. Bid Package #02-1: Asbestos Abatement at the Administrative Building, Canteen Building, Kitchen Building and Power Plant Building.
  - 2. Bid Package #09-1: Framing, Drywall, Painting, Ceilings and Doors.
  - 3. Bid Package #23-1: Mechanical, Plumbing, Demo, Concrete and Masonry.
  - 4. Bid Package #26-1: Electrical and Man-Down System.
- B. Target date to provide substantial completion is phased for each bid package. See Specification Section 00 3113 PRELIMINARY SCHEDULE for further information.

# 1.04 BID SCOPE SUMMARY

- A. Scope Applicable to All Bid Packages:
  - Construction of the project shall be accomplished under separate multiple contracts. Award of each separate contract shall be to the lowest responsive, responsible bidder. Bidders may bid more than one Bid Package; however, combined bids will not be accepted. Refer to Section 01 1200-1.09 for a description of work included under each separate contract. Contracts for this Project include the following:
    - a. Bid Package #02-1: Asbestos Abatement at the Administrative Building, Canteen Building, Kitchen Building and Power Plant Building.
    - b. Bid Package #09-1: Framing, Drywall, Painting, Ceilings and Doors.
    - c. Bid Package #23-1: Mechanical, Plumbing, Demo, Concrete and Masonry.
    - d. Bid Package #26-1: Electrical and Man-Down System.
  - 2. The Contractor's Work includes all labor, supervision, materials, equipment, services, supplies, tools, facilities, transportation, hoisting, storage, receiving, licenses,

inspections, certifications, overhead, profit, or other items required or reasonably inferable to properly and timely perform and complete all work and services to be performed by the Contractor pursuant to this Agreement. Unless specifically stated otherwise, incidental work required to accomplish the work of this Bid Package shall be included the bid. This would include, but not be limited to, temporary facilities, protection of the work, security of equipment, materials, and work in progress, etc. Contractor's Work shall be performed in accordance with the Drawings, Specification Divisions 00 and 01, and Specification sections applicable to each Contractor's scope.

- 3. Contractor is responsible for all labor and equipment to unload, account for all material delivered, stock, and delivery for this scope of work. Storage and delivery of materials and equipment at the Site shall be permitted only to the extent approved in advance by the Construction Manager, and if anything so stored obstructs the progress of any portion of the work, it shall be promptly removed or relocated by the Contractor without reimbursement.
- 4. Contractors shall designate two competent persons for the Project, one of which shall always be onsite during the performance of the Contractor's work or any of its subcontractors' work.
- 5. Provide all temporary facilities required for this scope of work including trailer, trailer power, telephone, secured storage, temporary power for work, temporary and task lighting for work, etc. as determined necessary by Contractor. Coordinate location of trailers, material storage and utility lines with Construction Manager. Limited space is available, and permission to bring any such facility or excess materials on to the site shall be approved by the Construction Manager.
- 6. Each Contractor shall be responsible for locating private utilities that affects their scope of work.
- 7. Contractors shall clean up and dispose of waste materials and debris generated from their work daily.
- 8. Contractors shall remove mud, dirt, and debris from roadways as it is generated from their work.
- 9. Protect adjacent existing building elements from damage from scope of work. Repair existing building elements damaged during Contractor's scope of work.
- 10. Contractors shall have a copy of their own Company Safety Manual onsite and submit an electronic copy to the Construction Manager.
- 11. If not included in the Company Safety Manual, Contractors shall submit their OSHArequired Silica Control Policy/Plan along with documentation identifying who the onsite Component Silica Control person(s) are, prior to beginning work onsite.
- 12. Refer to Section 01 4000-3.04 regarding inspection and testing responsibilities.
- 13. Contractors shall provide cutting and patching for its own work.
- 14. Contractors shall maintain an accurate set of As-Built Drawings throughout the duration of the Project.

- 15. Each person must pass a background check prior to work onsite (excluding delivery drivers). The background checks will be completed by the State of Iowa at no cost to the Contractors. Information needed includes full name, date of birth, and social security number.
- 16. Each person working onsite (excluding delivery drivers) shall attend a 45-minute State Training School and Story Construction Co. safety orientation prior to site entry. Upon successful completion of the orientation, each person will receive a hard-hat sticker to identify successful completion. Each person must successfully complete the orientation prior to being allowed onsite to perform work. A 24-hour notice to the Construction Manager of the need for an orientation is required.
- 17. Each Contractor shall designate a representative to attend one 60-minute preconstruction meeting.
- 18. Each Contractor and their Subcontractors shall designate an onsite representative to attend a daily 15-minute "End of Shift Meeting" on days which work is performed by them.
- 19. Each Contractor and their Subcontractors shall designate an onsite representative to attend a weekly 60-minute production and planning meeting the weeks which work is performed by them, plus the two (2) weeks ahead of each Contractor/Subcontractor starting work on site.
- 20. Each Contractor shall designate a representative to attend a 60-minute bi-weekly Owner/Designer/Construction Manager Meeting.
- 21. Prior to the weekly production and planning meeting, each Contractor and their Subcontractors shall populate the project planning and communication board with daily activities. This shall include activity description, quantity of work planned for completion daily, crew size for each activity, and location of each activity. The Construction Manager will assist with the population of the board.
- 22. Each Contractor shall have their Project Manager and onsite representative attend a Story Construction Co. Planning and Production system orientation. Plan for this meeting to last 2-hours.
- 23. All persons shall wear hardhats, safety classes, work boots, full-length pants, and shirts with a minimum of 4-inch sleeves while onsite.
- 24. All persons are prohibited from using products containing tobacco and/or nicotine on site.

# 1.05 WORK HOUR RESTRICTIONS

A. Work hours are from 7:00 AM to 6:00 PM, Monday through Friday unless arrangements are made in advance.

# 1.06 CONTRACTOR USE OF SITE AND PREMISES

- A. Construction Operations: Limited to areas noted on Drawings.
- B. Provide access to and from site as required by law and Owner:
  - 1. Emergency Building Exits During Construction: Keep all exits required by code open during construction period; provide temporary exit signs if exit routes are temporarily altered.

- 2. Do not obstruct roadways, sidewalks, or other public ways without permission of Owner and permit if required.
- C. The facility will always be occupied during the duration of the project. Contractor personnel shall conduct themselves in an agreeable manner at all times. Failure to do so may result in removal from the work site.
- D. Personal vehicles shall be parked in the designated parking areas shown in the drawings. The vehicles are to remain locked and not running unless occupied.
- E. Tool trailers and office trailers shall be parked in the designated parking areas shown in the drawings. Tool trailers and office trailers must always be locked unless occupied by personnel.

# 1.07 OWNER OCCUPANCY

- A. Owner intends to occupy the effected locations upon completion of the work.
- B. Cooperate with Owner to minimize conflict and to facilitate Owner's operations.
- C. Schedule the Work to accommodate Owner occupancy.

# 1.08 RULES FOR CONSTRUCTION WORKERS

- A. The staff of the State of Iowa has a responsibility to protect the public by providing a secure environment. All work site rules must be followed always.
- B. All personnel entering the site must have a background check completed prior to entering the campus to perform work. This does not apply to delivery drivers.
- C. Hot Work Permit Processes, when necessary, will be adhered to for this project.
- D. The Training School properties are tobacco free. The use of tobacco and nicotine products are prohibited.
- E. The Contractor is permitted access only to the work site and no other area of the institution.
- F. No drugs, alcohol, or firearms are allowed on the work site.
- G. Do not leave money, drugs, alcohol, or firearms in your personal vehicle.
- H. Company and personal vehicles are to be parked and locked in designated or authorized area of the work.
- I. Never leave keys in any vehicle. If a security officer finds keys in a vehicle, they are under orders to turn them in to a security supervisor.
- J. Do not give anything to residents or take anything from residents; if they offer, inform your supervisor.
- K. During an emergency, follow the instructions of the Training School staff.
- L. All tools, materials and equipment shall always be controlled by the Contractor and never left unattended without being secured. The Contractor shall have a written inventory of tools which they have onsite. All tools shall be secured at the end of each shift. If tools, materials or equipment are missing, the Contractor shall immediately notify the State Training School Staff.
- M. Each person shall check in and check out at the Administration Building switchboard each time entering or exiting the Training School, including breaks and lunch.
- N. All persons shall wear hardhats, safety glasses, work boots, full-length pants and shirts with a minimum of 4-inch sleeves while onsite.

# 1.09 BID PACKAGE INSTRUCTIONS

- A. **Bid Package #02-1** Asbestos abatement as shown or called to be removed at the administrative building, canteen building, kitchen building and power plant building. Additional abatement is anticipated at additional locations and buildings for unforeseen materials which shall be measured and included in the unit pricing items. Trade Contractor shall include all of the following as base bid work, but not limited to, as part of the contract:
  - 1. Specifications:
    - a. Division 00 Procurement and Contracting Requirements
    - b. Division 01 General Requirements
    - c. Division 02 Existing Conditions
      - 1) Specifications 02 8200 Asbestos Abatement Complete.
  - 2. Drawings:
    - a. Drawing set titled, "ELDORA STATE TRAINING SCHOOL ASBESTOS ABATEMENT PACKAGE":
      - 1) All work shown in this set of drawings is by this package.
  - 3. Unit Price #01 Asbestos abatement of thermal insulation, at locations requested by the Construction Manager, which are not shown or called to be removed in the bid documents: Trade Contractor shall include all of the following, but not limited to, as part of the contract:
    - a. Unit Price Quantity: 3,000 LF
    - b. Unit price includes all necessary material, removal and disposal of asbestoscontaining materials, insurance, overhead, and profit to remove a linear foot of asbestos containing thermal insulation according to project requirements. Thermal insulation unit pricing also includes abatement of thermal insulation on pipe fittings and shall be measured as one (1) linear foot for each pipe fitting.
    - c. Owner reserves the right to reject Contractor's measurements of additional work in locations shown as base bid work and to have this work measured, at the Owner's expense, by an independent surveyor acceptable to the Contractor.
  - 4. **Unit Price #02** Asbestos abatement of floor tile and mastic, at locations requested by the Construction Manager, which are not shown or called to be removed in the bid documents: Trade Contractor shall include all of the following, but not limited to, as part of the contract:
    - a. Unit Price Quantity: 1,400 SF
    - b. Unit price includes all necessary material, removal and disposal of asbestoscontaining materials, insurance, overhead, and profit to remove a square foot of asbestos containing floor tile and/or mastic according to project requirements.
    - c. Owner reserves the right to reject Contractor's measurements of additional work in locations shown as base bid work and to have this work measured, at the Owner's expense, by an independent surveyor acceptable to the Contractor.

- 5. **Unit Price #03** Asbestos abatement of plaster ceilings, at locations requested by the Construction Manager, which are not shown or called to be removed in the bid documents: Trade Contractor shall include all of the following, but not limited to, as part of the contract:
  - a. Unit Price Quantity: 460 SF
  - b. Unit price includes all necessary material, removal and disposal of asbestoscontaining materials, insurance, overhead, and profit to remove a square foot of drywall or plaster walls or ceilings according to project requirements.
  - c. Owner reserves the right to reject Contractor's measurements of additional work in locations shown as base bid work and to have this work measured, at the Owner's expense, by an independent surveyor acceptable to the Contractor.
- 6. **Unit Price #04** Asbestos abatement of drywall walls and ceilings, at locations requested by the Construction Manager, which are not shown or called to be removed in the bid documents: Trade Contractor shall include all of the following, but not limited to, as part of the contract:
  - a. Unit Price Quantity: 2,000 SF
  - b. Unit price includes all necessary material, removal and disposal of asbestoscontaining materials, insurance, overhead, and profit to remove a square foot of drywall or plaster walls or ceilings according to project requirements.
  - c. Owner reserves the right to reject Contractor's measurements of additional work in locations shown as base bid work and to have this work measured, at the Owner's expense, by an independent surveyor acceptable to the Contractor.
- 7. **Unit Price #05** Asbestos spot abatement of plaster walls and ceilings, at locations requested by the Construction Manager, which are not shown or called to be removed in the bid documents: Trade Contractor shall include all of the following, but not limited to, as part of the contract:
  - a. Unit Price Quantity: 12 EA.
  - b. Unit price includes all necessary material, removal and disposal of asbestoscontaining materials, insurance, overhead, and profit to remove a square foot of drywall or plaster walls or ceilings according to project requirements.
  - c. Owner reserves the right to reject Contractor's measurements of additional work in locations shown as base bid work and to have this work measured, at the Owner's expense, by an independent surveyor acceptable to the Contractor.
- 8. **Unit Price #06** –Site remobilization for abatement as requested by the Construction Manager for additional unit price work not shown or called to be removed in the bid documents: Trade Contractor shall include all of the following, but not limited to, as part of the contract:
  - a. Unit Price Quantity: 7 EA.
  - b. Unit price includes all necessary material, engineering controls, cleaning all surfaces, personal air monitoring, final cleaning, insurance, overhead, and profit to remobilize to the site for additional unit price abatement work not included in the base bid.
  - c. Owner reserves the right to reject Contractor's measurements of additional work in locations shown as base bid work and to have this work measured, at the Owner's expense, by an independent surveyor acceptable to the Contractor.

- B. **Bid Package #09-1** Framing, drywall, painting, ceilings and doors: Trade Contractor shall include all of the following, but not limited to, as part of the contract:
  - 1. Specifications:
    - a. Division 00 Procurement and Contracting Requirements
    - b. Division 01 General Requirements
    - c. Division 02 Existing Conditions
      - 1) Specification 02 4100 Demolition. Complete demo for new openings from Division 08 completed by BP #09-1.
    - d. Division 05 Metals
      - 1) Specification 05 1200 Structural Steel Framing.
      - 2) Specification 05 5116 Metal Floor Plate Stairs.
      - 3) Specification 05 5213 Pipe and Tube Railings.
    - e. Division 06 Wood, Plastics and Composites
      - 1) Complete.
    - f. Division 07 Thermal and Moisture Protection
      - Specification 07 8400 Firestopping for adjacent work completed by BP 09-1.
      - Specifications 07 9200 Joint Sealants for adjacent work completed by BP 09-1.
    - g. Division 08 Openings
      - 1) Complete. BP #09-1 to complete demo and/or preparation for new openings.
    - h. Division 09 Finishes
      - 1) Complete.
  - 2. Drawings:
    - a. Drawing set titled, "ELDORA STATE TRAINING SCHOOL DECENTRALIZATION BUILDING PACKAGE".
  - 3. **Allowance #01** Wall Patching Allowance: BP #09-1 shall include all of the following as part of the contract:
    - a. Include \$80,000 Owner wall patching allowance in Base Bid. Work will be completed on a T&M or proposal basis.
  - 4. **Alternate #01** Bulkheads in Cottages 5, 7, 8 and Receiving: BP #09-1 shall include all of the following, but not limited to, as part of the contract:
    - a. Construct gypsum wall board bulkheads in the Locker Rooms as indicated on sheets 03-A1.02 and 04-A1.02.
    - b. Coordination: Revise or adjust affected adjacent work as necessary to completely integrate work of the alternate into Project.
    - c. Include as part of each alternate, miscellaneous devices, accessory objects, and similar items incidental to or required for a complete installation whether or not indicated as part of alternate.
    - d. Execute accepted alternates under the same conditions as other work of the Contract.

- 5. Alternate #03 Sensory Room Buildouts:
  - a. Buildouts include (5) five sensory rooms with one sensory room to be located in each of the following locations: Cottage 3, Cottage 4, Cottage 5, Receiving and Cottage 7.
    - 1) BP #09-1 shall include all of the following, but not limited to, as part of the contract:
      - a) All work included in BP #09-1 scope of work associated with the Sensory Room Buildouts.
  - b. Coordination: Revise or adjust affected adjacent work as necessary to completely integrate work of the alternate into Project.
  - c. Include as part of each alternate, miscellaneous devices, accessory objects, and similar items incidental to or required for a complete installation whether or not indicated as part of alternate.
  - d. Execute accepted alternates under the same conditions as other work of the Contract.
- C. **Bid Package #23-1** Mechanical, plumbing, demo, concrete and masonry: Trade Contractor shall include all of the following, but not limited to, as part of the contract:
  - 1. Specifications:
    - a. Division 00 Procurement and Contracting Requirements
    - b. Division 01 General Requirements
    - c. Division 02 Existing Conditions
      - Specification 02 4100 Complete all mass and spot demo work except specifically for new openings noted in Specification Division 8. The demo for new openings will be completed by BP #09-1.
    - d. Division 03 Concrete
      - 1) Complete.
    - e. Division 04 Masonry
      - 1) Complete.
    - f. Division 05 Metals
      - 1) Specification 05 5000 Metal Fabrications.
    - g. Division 07 Thermal and Moisture Protection
      - Specification 07 8400 Firestopping for adjacent work completed by BP 23-1.
      - Specifications 07 9200 Joint Sealants for adjacent work completed by BP 23-1.
    - h. Division 21 Fire Suppression
      - 1) Complete.
    - i. Division 22 Plumbing
      - 1) Complete.
    - j. Division 23 Heating Ventilating and Air Conditioning
      - 1) Complete.
  - 2. Drawings:
    - a. Drawing set titled, "ELDORA STATE TRAINING SCHOOL DECENTRALIZATION BUILDING PACKAGE".

- 3. **Allowance #02** Masonry Wall Patching Allowance: BP #09-1 shall include all of the following as part of the contract:
  - a. Include \$20,000 Owner Masonry wall patching allowance in base bid. Work will be completed on a T&M or proposal basis.
- 4. **Alternate #02** Ductwork Cleaning in Cottages: BP #23-1 shall include all of the following, but not limited to, as part of the contract:
  - a. The cleaning of all existing ductwork in Cottage 1, Cottage 2, Cottage 3, Cottage 4, Cottage 5, Receiving, Cottage 7 and Cottage 8.
  - b. The removal of visible surface contaminants and deposits from within the HVAC system. The HVAC system includes any interior surface of the air distribution system for conditioned spaces. This includes the entire heating and air-conditioning system from where the air enters the system to where the air discharges the system.
  - c. All service openings created for cleaning shall be sealed according to NFPA and SMACNA Standards.
  - d. Coordination: Revise or adjust affected adjacent work as necessary to completely integrate work of the alternate into Project.
  - e. Include as part of each alternate, miscellaneous devices, accessory objects, and similar items incidental to or required for a complete installation whether or not indicated as part of alternate.
  - f. Execute accepted alternates under the same conditions as other work of the Contract.
- 5. **Alternate #03** Sensory Room Buildouts:
  - a. Buildouts include (5) five sensory rooms with one sensory room to be located in each of the following locations: Cottage 3, Cottage 4, Cottage 5, Receiving and Cottage 7.
    - 1) BP #23-1 shall include all of the following, but not limited to, as part of the contract:
      - a) All work included in BP #23-1 scope of work associated with the Sensory Room Buildouts.
  - b. Coordination: Revise or adjust affected adjacent work as necessary to completely integrate work of the alternate into Project.
  - c. Include as part of each alternate, miscellaneous devices, accessory objects, and similar items incidental to or required for a complete installation whether or not indicated as part of alternate.
  - d. Execute accepted alternates under the same conditions as other work of the Contract.
- D. **Bid Package #26-1** Electrical and man-down system: Trade Contractor shall include all of the following, but not limited to, as part of the contract:
  - 1. Specifications:
    - a. Division 00 Procurement and Contracting Requirements
    - b. Division 01 General Requirements
    - c. Division 02 Demolition
      - 1) Complete demolition as related to BP #26-1 scope of work.
    - d. Division 07 Thermal and Moisture Protection
      - Specification 07 8400 Firestopping for adjacent work completed by BP 23 1.

- Specifications 07 9200 Joint Sealants for adjacent work completed by BP 23-1.
- e. Division 26 Electrical
  - 1) Complete.
  - Division 27 Communications
  - 1) Complete.
- g. Division 28 Electronic Safety and Security
  - 1) Complete.
- 2. Drawings:

f.

- a. Drawing set titled, "ELDORA STATE TRAINING SCHOOL DECENTRALIZATION BUILDING PACKAGE".
- b. Drawing set titled, "ELDORA STATE TRAINING SCHOOL SECURITY SYSTEM".
- 3. Alternate #03 Sensory Room Buildouts:
  - a. Buildouts include (5) five sensory rooms with one sensory room to be located in each of the following locations: Cottage 3, Cottage 4, Cottage 5, Receiving and Cottage 7.
    - 1) BP #26-1 shall include all of the following. but not limited to, as part of the contract:
      - a) All work included in BP #26-1 scope or work associated with the Sensory Room Buildouts.
  - b. Coordination: Revise or adjust affected adjacent work as necessary to completely integrate work of the alternate into Project.
  - c. Include as part of each alternate, miscellaneous devices, accessory objects, and similar items incidental to or required for a complete installation whether or not indicated as part of alternate.
  - d. Execute accepted alternates under the same conditions as other work of the Contract.
- **4.** Alternate #04 Man Down Additional Hardware: BP #26-1 shall include all of the following, but not limited to, as part of the contract:
  - a. Furnish and install new receivers as shown on the floorplans to supplement the current Man down system. Include the cost to furnish and install new wiring to connect the devices to the base bid system. Refer to the drawings for the devices that are to be included in Alternate #4 Coordination: Revise or adjust affected adjacent work as necessary to completely integrate work of the alternate into Project.
  - b. Include as part of each alternate, miscellaneous devices, accessory objects, and similar items incidental to or required for a complete installation whether or not indicated as part of alternate.
  - c. Execute accepted alternates under the same conditions as other work of the Contract.
- 5. Alternate #05 Man Down Front-End Software Upgrade: BP #26-1 shall include all of the following, but not limited to, as part of the contract:
  - Furnish and install new central console control center for the Man down system.
     Provide complete graphical monitoring system, include software upgrade for the entire system. Printer shall be provided and installed by vendor.

- b. Coordination: Revise or adjust affected adjacent work as necessary to completely integrate work of the alternate into Project.
- c. Include as part of each alternate, miscellaneous devices, accessory objects, and similar items incidental to or required for a complete installation whether or not indicated as part of alternate.
- d. Execute accepted alternates under the same conditions as other work of the Contract.
- 6. **Unit Price #05** Security System Transponders: Trade Contractor shall include all of the following, but not limited to, as part of the contract:
  - a. Internal Receiver Transponder:
    - 1) Furnish and install new transponder and 50' of cable in  $\frac{3}{4}$ " conduit.
  - b. Unit prices include all necessary material, plus cost for delivery, installation, insurance, overhead, and profit.
  - c. Owner reserves the right to reject Contractor's measurements of work in place that involves use of established unit prices and to have this work measured, at the Owner's expense, by an independent surveyor acceptable to the Contractor.
- 7. **Unit Price #06** Internal Security System Receivers: Trade Contractor shall include all of the following, but not limited to, as part of the contract:
  - a. Internal Receiver:
    - 1) Furnish and install new internal receiver and 30' of cable in <sup>3</sup>/<sub>4</sub>" conduit.
  - b. Unit prices include all necessary material, plus cost for delivery, installation, insurance, overhead, and profit.
  - c. Owner reserves the right to reject Contractor's measurements of work in place that involves use of established unit prices and to have this work measured, at the Owner's expense, by an independent surveyor acceptable to the Contractor.
- 8. **Unit Price #07** External Security System Receivers: Trade Contractor shall include all of the following, but not limited to, as part of the contract:
  - a. External Receiver:
    - 1) Furnish and install new internal receiver and 50' of cable in  $\frac{3}{4}$ " conduit.
  - b. Unit prices include all necessary material, plus cost for delivery, installation, insurance, overhead, and profit.
  - c. Owner reserves the right to reject Contractor's measurements of work in place that involves use of established unit prices and to have this work measured, at the Owner's expense, by an independent surveyor acceptable to the Contractor.
- E. Work Performed by Owner or Construction Manager: The Owner or Construction Manager will perform the following work items:
  - 1. Relocate all moveable furniture, fixtures and equipment (FF&E), including window treatments; and personal materials from each sequenced work area prior to demolition and construction activities and after new construction is completed.
  - 2. Fire Watch when necessary.
  - 3. NPDES plan and permit and associated erosion control measures and inspections.
  - 4. Temporary tree dripline fencing (if necessary).
  - 5. Temporary granular surfacing for parking and laydown area.
  - 6. Temporary fencing for laydown area.

PART 2 - PRODUCTS – NOT USED

PART 3 - EXECUTION - NOT USED

END OF SECTION

# SECTION 23 2214 STEAM AND CONDENSATE HEATING SPECIALTIES

# PART 1 GENERAL

- 1.1 SECTION INCLUDES
  - A. Steam traps.
  - B. Boiler feed units.
  - C. Vacuum pumping units.
  - D. Steam safety valves.
- 1.2 RELATED REQUIREMENTS
- 1.3 REFERENCE STANDARDS
  - A. ASME B31.9 Building Services Piping; 2014.
  - B. ASTM A126 Standard Specification for Gray Iron Castings for Valves, Flanges, and Pipe Fittings; 2004 (Reapproved 2014).
  - C. NEMA 250 Enclosures for Electrical Equipment (1000 Volts Maximum); 2014.

# 1.4 SUBMITTALS

- A. See Section 01 3000 Administrative Requirements, for submittal procedures.
- B. Product Data:
  - 1. Provide for manufactured products and assemblies required for this project.
  - 2. Include product description, model, dimensions, component sizes, rough-in requirements, service sizes, and finishes.
  - 3. Submit schedule indicating manufacturer, model number, size, location, rated capacity, load served, and features for each specialty.
  - 4. Include electrical characteristics and connection requirements.
- C. Maintenance Materials: Furnish the following for Owner's use in maintenance of project.
  - 1. See Section 01 6000 Product Requirements, for additional provisions.
  - 2. Extra Pump Seals: One set for each type and size of pump.
  - 3. Steam Trap Service Kits: One for each type and size.

# 1.5 QUALITY ASSURANCE

- A. Perform Work in accordance with State of Iowa standard for installation of boilers and pressure vessels.
- B. Products Requiring Electrical Connection: Listed and classified by UL as suitable for the purpose indicated.

# STEAM AND CONDENSATE HEATING SPECIALTIES

### 1.6 DELIVERY, STORAGE, AND HANDLING

- A. Accept valves on site in shipping containers with labeling in place. Inspect for damage.
- B. Provide temporary end caps and closures on piping and fittings. Maintain in place until installation.
- C. Protect piping systems from entry of foreign materials by temporary covers, completing sections of the work, and isolating parts of completed system.

# PART 2 PRODUCTS

- 2.1 STEAM TRAPS
  - A. Manufacturers:
    - 1. Armstrong International, Inc: www.armstronginternational.com/#sle.
    - 2. Marshall Engineered Products Company: www.mepcollc.com/#sle.
    - 3. Spirax-Sarco: www.spiraxsarco.com/us/#sle.
  - B. Steam Trap Applications:
    - 1. Use Float and Thermostatic Traps for:
      - a. Unit heaters.
      - b. Main headers.
  - C. Steam Trap Performance:
    - 1. Select to handle minimum of two times maximum condensate load of apparatus served.
    - 2. Pressure Differentials:
      - a. Low Pressure Systems (15 psi maximum): 2 psi.
  - D. Float and Thermostatic Traps: ASTM A126 cast iron or semi-steel body and bolted cover, stainless steel or bronze bellows type air vent, stainless steel or copper float, stainless steel lever and valve assembly.
    - 1. Rating: 15 psi WSP.
    - 2. Features: Access to internal parts without disturbing piping, bottom drain plug.
    - 3. Accessories: Gauge glass with shut-off cocks.

# 2.2 LOW PRESSURE BOILER FEED UNITS

- A. Manufacturers:
  - 1. Bryan Steam Corporation: www.bryanboilers.com/#sle.
  - 2. Cleaver-Brooks: www.cleaver-brooks.com/#sle.
  - 3. Marshall Engineered Products Company: www.mepcollc.com/#sle.

STEAM AND CONDENSATE
HEATING SPECIALTIES
23 2214-2

- 4. Substitutions: See Section 01 6000 Product Requirements.
- B. Boiler Feed Units: Consist of receiver, inlet strainer, pumps, water make-up assembly, electric control components and accessories.
- C. Condensate Receiver: Cast iron, equipped with water level gauge, dial thermometer, pressure gauges on pump discharge, bronze isolation valves and strainer between pumps and receiver, and lifter eye bolts.
- D. Inlet Strainer: Cast iron, with vertical self-cleaning easily removable bronze screen and large dirt pocket, mounted on receiver.
- E. Water Make-Up Assembly: Level control switch and solenoid valve mounted on receiver.
  - 1. Valve: Packless, piston pilot operated type with cushioned closing and epoxy resin molded waterproof coil.
  - 2. Capacity: Equal to one boiler feed pump.
  - 3. With strainer, and manual bypass.
- F. Pumps: Vertical design, bronze fitted with stainless steel shaft, enclosed bronze impeller, renewable bronze case ring, mechanical shaft seal, close coupled to motor.

#### 2.3 VACUUM PUMPING UNITS

- A. Manufacturers:
  - 1. Bell & Gossett, a xylem brand: www.bellgossett.com/#sle.
  - 2. Marshall Engineered Products Company: www.mepcollc.com/#sle.
  - 3. Spirax-Sarco: www.spiraxsarco.com/us/#sle.
  - 4. Shipco.
  - 5. Substitutions: See Section 01 6000 Product Requirements.
- B. Vacuum Pumping Units: Consist of receiver on which are mounted inlet strainer, pumps, discharge valve assemblies, vacuum and float controls, electric controls and accessories.
- C. Receiver: Two compartment cast iron with multi-jet vacuum producers, centerline of inlet no higher than 8 inches from floor.
- D. Accessories: Vacuum gauge, thermometer, water level gauge, lifting eye bolts, and vacuum breaker.
- E. Inlet Strainer: Cast iron with vertical self-cleaning bronze screen and large dirt pocket, mounted on receiver. Screen shall be vertically removable for cleaning.
- F. Condensate Discharge: Control with hydraulically operated positive acting discharge valves with bronze bellows and float operated pilot valves.
- G. Pumps: Vertical design, flange mounted, bronze fitted with stainless steel shaft, enclosed bronze impeller, renewable bronze case ring, mechanical shaft seal, close coupled to motor.

STEAM AND CONDENSATE HEATING SPECIALTIES 23 2214-3

- H. The entire assembly shall be permanently aligned and dynamically balanced to deliver its full rated capacity of air and water at a test point of 5-1/2" Hg vacuum and 160°F in accordance to the latest ASHRAE Standard Code for Return Line Low Vaccum Heating Pumps.
- I. Control Cabinet:
  - 1. NEMA 250 enclosure with piano hinged door, grounding lug, terminal strip, and fusible control circuit transformer.
  - 2. Combination magnetic starters with overload relays, circuit breakers and cover interlock.
  - 3. Selector switches "off", "float only", "float & vacuum", "continuous".
  - 4. Electric alternator, test buttons.

# 2.4 SAFETY RELIEF VALVES

- A. Manufacturers:
  - 1. Armstrong International, Inc: www.armstronginternational.com/#sle.
  - 2. Cash Acme, a brand of Reliance Worldwide Corporation: www.cashacme.com/#sle.
  - 3. ITT McDonnell & Miller, a xylem brand: www.mcdonnellmiller.com/#sle.
  - 4. Spirax-Sarco: www.spiraxsarco.com/us/#sle.
  - 5. Substitutions: See Section 01 6000 Product Requirements.
- B. Valve: Bronze body, stainless steel valve spring, stem, and trim, direct pressure actuated, capacities ASME certified and labelled.
- C. Accessories: Drip pan elbow.

# PART 3 EXECUTION

- 3.1 INSTALLATION
  - A. Install steam and steam condensate piping and specialties in accordance with ASME B31.9.
  - B. Install specialties in accordance with manufacturer's instructions.
  - C. Steam Traps:
    - 1. Provide minimum 3/4 inch size on steam mains and branches.
    - 2. Install with union or flanged connections at both ends.
    - 3. Provide gate valve and strainer at inlet, and gate valve and check valve at discharge.
    - 4. Provide minimum 10 inch long, line size dirt pocket between apparatus and trap.
  - D. Terminate relief valves to outdoors. Provide drip pan elbow with drain connection to nearest floor drain.

# END OF SECTION

STEAM AND CONDENSATE HEATING SPECIALTIES 23 2214-4

# SECTION 26 2923 VARIABLE-FREQUENCY MOTOR CONTROLLERS

# PART 1 GENERAL

- 1.1 SECTION INCLUDES
  - A. Variable frequency controllers.

# 1.2 REFERENCE STANDARDS

- A. NEMA ICS 7.1 Safety Standards for Construction and Guide for Selection, Installation, and Operation of Adjustable-Speed Drive Systems; 2014.
- B. NEMA ICS 7 Industrial Control and Systems: Adjustable-Speed Drives; 2014.
- C. NEMA 250 Enclosures for Electrical Equipment (1000 Volts Maximum); 2014.
- D. NETA ATS Acceptance Testing Specifications for Electrical Power Equipment and Systems; 2013.
- E. NFPA 70 National Electrical Code; Most Recent Edition Adopted by Authority Having Jurisdiction, Including All Applicable Amendments and Supplements.

# 1.3 SUBMITTALS

A. Product Data: Provide catalog sheets showing voltage, controller size, ratings and size of switching and overcurrent protective devices, short circuit ratings, dimensions, and enclosure details.

# 1.4 QUALITY ASSURANCE

- A. Comply with requirements of NFPA 70.
- B. Manufacturer Qualifications: Company specializing in manufacturing the products specified in this section with minimum three years documented experience and with service facilities within 100 miles of Project.
- C. Products: Listed, classified, and labeled as suitable for the purpose intended.
- D. Product Listing Organization Qualifications: An organization recognized by OSHA as a Nationally Recognized Testing Laboratory (NRTL) and acceptable to authorities having jurisdiction.
- 1.5 DELIVERY, STORAGE, AND HANDLING
  - A. Store in a clean, dry space. Maintain factory wrapping or provide an additional heavy canvas or heavy plastic cover to protect units from dirt, water, construction debris, and traffic.
  - B. Handle in accordance with manufacturer's written instructions. Lift only with lugs provided for the purpose. Handle carefully to avoid damage to components, enclosure, and finish.

# PART 2 PRODUCTS

- 2.1 MANUFACTURERS
  - A. Variable Frequency Motor Controllers:
    - 1. ABB/GE www.geindustrial.com/#sle.

IA DAS - Eldora STS Decentralization Building Package Project # 417568-1 DAS Project # 8982.01

Issued for Addendum #01 02-06-2020 VARIABLE-FREQUENCY MOTOR CONTROLLERS

- 2. Danfoss: www.danfoss.com/#sle.
- 3. Eaton Corporation: www.eaton.com/#sle.
- 4. Rockwell Automation, Inc.; Allen-Bradley Products: ab.rockwellautomation.com/#sle.
- 5. Schneider Electric; Square D Products: www.schneider-electric.us/#sle.
- 6. Siemens Industry, Inc: www.usa.siemens.com/#sle.
- B. Source Limitations: Furnish variable frequency motor controllers and associated components produced by a single manufacturer and obtained from a single supplier.

#### 2.2 DESCRIPTION

- A. Variable Frequency Controllers: Enclosed controllers suitable for operating the indicated loads, in compliance with requirements of NEMA ICS 7. Select unspecified features and options in accordance with NEMA ICS 3.1.
  - 1. Employ microprocessor-based inverter logic isolated from power circuits.
  - 2. Employ pulse-width-modulated inverter system.
  - 3. Design for ability to operate controller with motor disconnected from output.
  - 4. Design to attempt five automatic restarts following fault condition before locking out and requiring manual restart.
- B. Enclosures: NEMA 250, Type 1, suitable for equipment application in places regularly open to the public.
- C. Finish: Manufacturer's standard enamel.

# 2.3 OPERATING REQUIREMENTS

- A. Rated Input Voltage: 208 volts, three phase, 60 Hertz.
- B. Motor Nameplate Voltage: 200 volts, three phase, 60 Hertz.
- C. Displacement Power Factor: Between 1.0 and 0.95, lagging, over entire range of operating speed and load.
- D. Operating Ambient: 0 degrees C to 40 degrees C.
- E. Volts Per Hertz Adjustment: Plus or minus 10 percent.
- F. Current Limit Adjustment: 60 to 110 percent of rated.
- G. Acceleration Rate Adjustment: 0.5 to 30 seconds.
- H. Deceleration Rate Adjustment: 1 to 30 seconds.
- I. Input Signal: 4 to 20 mA DC.

#### 2.4 COMPONENTS

A. Display: Provide integral digital display to indicate output voltage, output frequency, and output current.

- B. Status Indicators: Separate indicators for overcurrent, overvoltage, ground fault, overtemperature, and input power ON.
- C. Furnish HAND-OFF-AUTOMATIC selector switch and manual speed control.
- D. Include undervoltage release.
- E. Control Power Source: Separate circuit.
- F. Door Interlocks: Furnish mechanical means to prevent opening of equipment with power connected, or to disconnect power if door is opened; include means for defeating interlock by qualified persons.
- G. Safety Interlocks: Furnish terminals for remote contact to inhibit starting under both manual and automatic mode.
- H. Control Interlocks: Furnish terminals for remote contact to allow starting in automatic mode.
- I. Manual Bypass: Furnish contactor, motor running overload protection, and short circuit protection for full voltage, non-reversing operation of the motor. Include isolation switch to allow maintenance of inverter during bypass operation.
- J. Emergency Stop: Use dynamic brakes for emergency stop function.
- K. Disconnecting Means: Include integral fused disconnect switch on the line side of each controller.
- L. Wiring Terminations: Match conductor materials and sizes indicated.
- 2.5 SOURCE QUALITY CONTROL
  - A. Shop inspect and perform standard productions tests for each controller.

# PART 3 EXECUTION


- 3.1 EXAMINATION
  - A. Verify that surface is suitable for controller installation.
  - B. Do not install controller until building environment can be maintained within the service conditions required by the manufacturer.

# 3.2 INSTALLATION

- A. Install in accordance with NEMA ICS 7.1 and manufacturer's instructions.
- B. Provide required support and attachment in accordance with Section 26 0529.
- C. Tighten accessible connections and mechanical fasteners after placing controller.
- D. Provide fuses in fusible switches; refer to Section 26 2813 for product requirements.
- E. Select and install overload heater elements in motor controllers to match installed motor characteristics.
- F. Identify variable frequency controllers in accordance with Section 26 0553.

- 3.3 FIELD QUALITY CONTROL
  - A. Perform field inspection and testing in accordance with Section 01 4000.
  - B. Inspect and test in accordance with NETA ATS, except Section 4.
  - C. Perform inspections and tests listed in NETA ATS, Section 7.17. The insulation-resistance test on control wiring listed as optional is not required.
- 3.4 ADJUSTING
  - A. Make final adjustments to installed controller to assure proper operation of load system. Obtain performance requirements from installer of driven loads.
- 3.5 CLOSEOUT ACTIVITIES
  - A. Demonstrate operation of controllers in automatic and manual modes.
- 3.6 MAINTENANCE
  - A. Provide service and maintenance of controllers for one year from Date of Substantial Completion.

### END OF SECTION

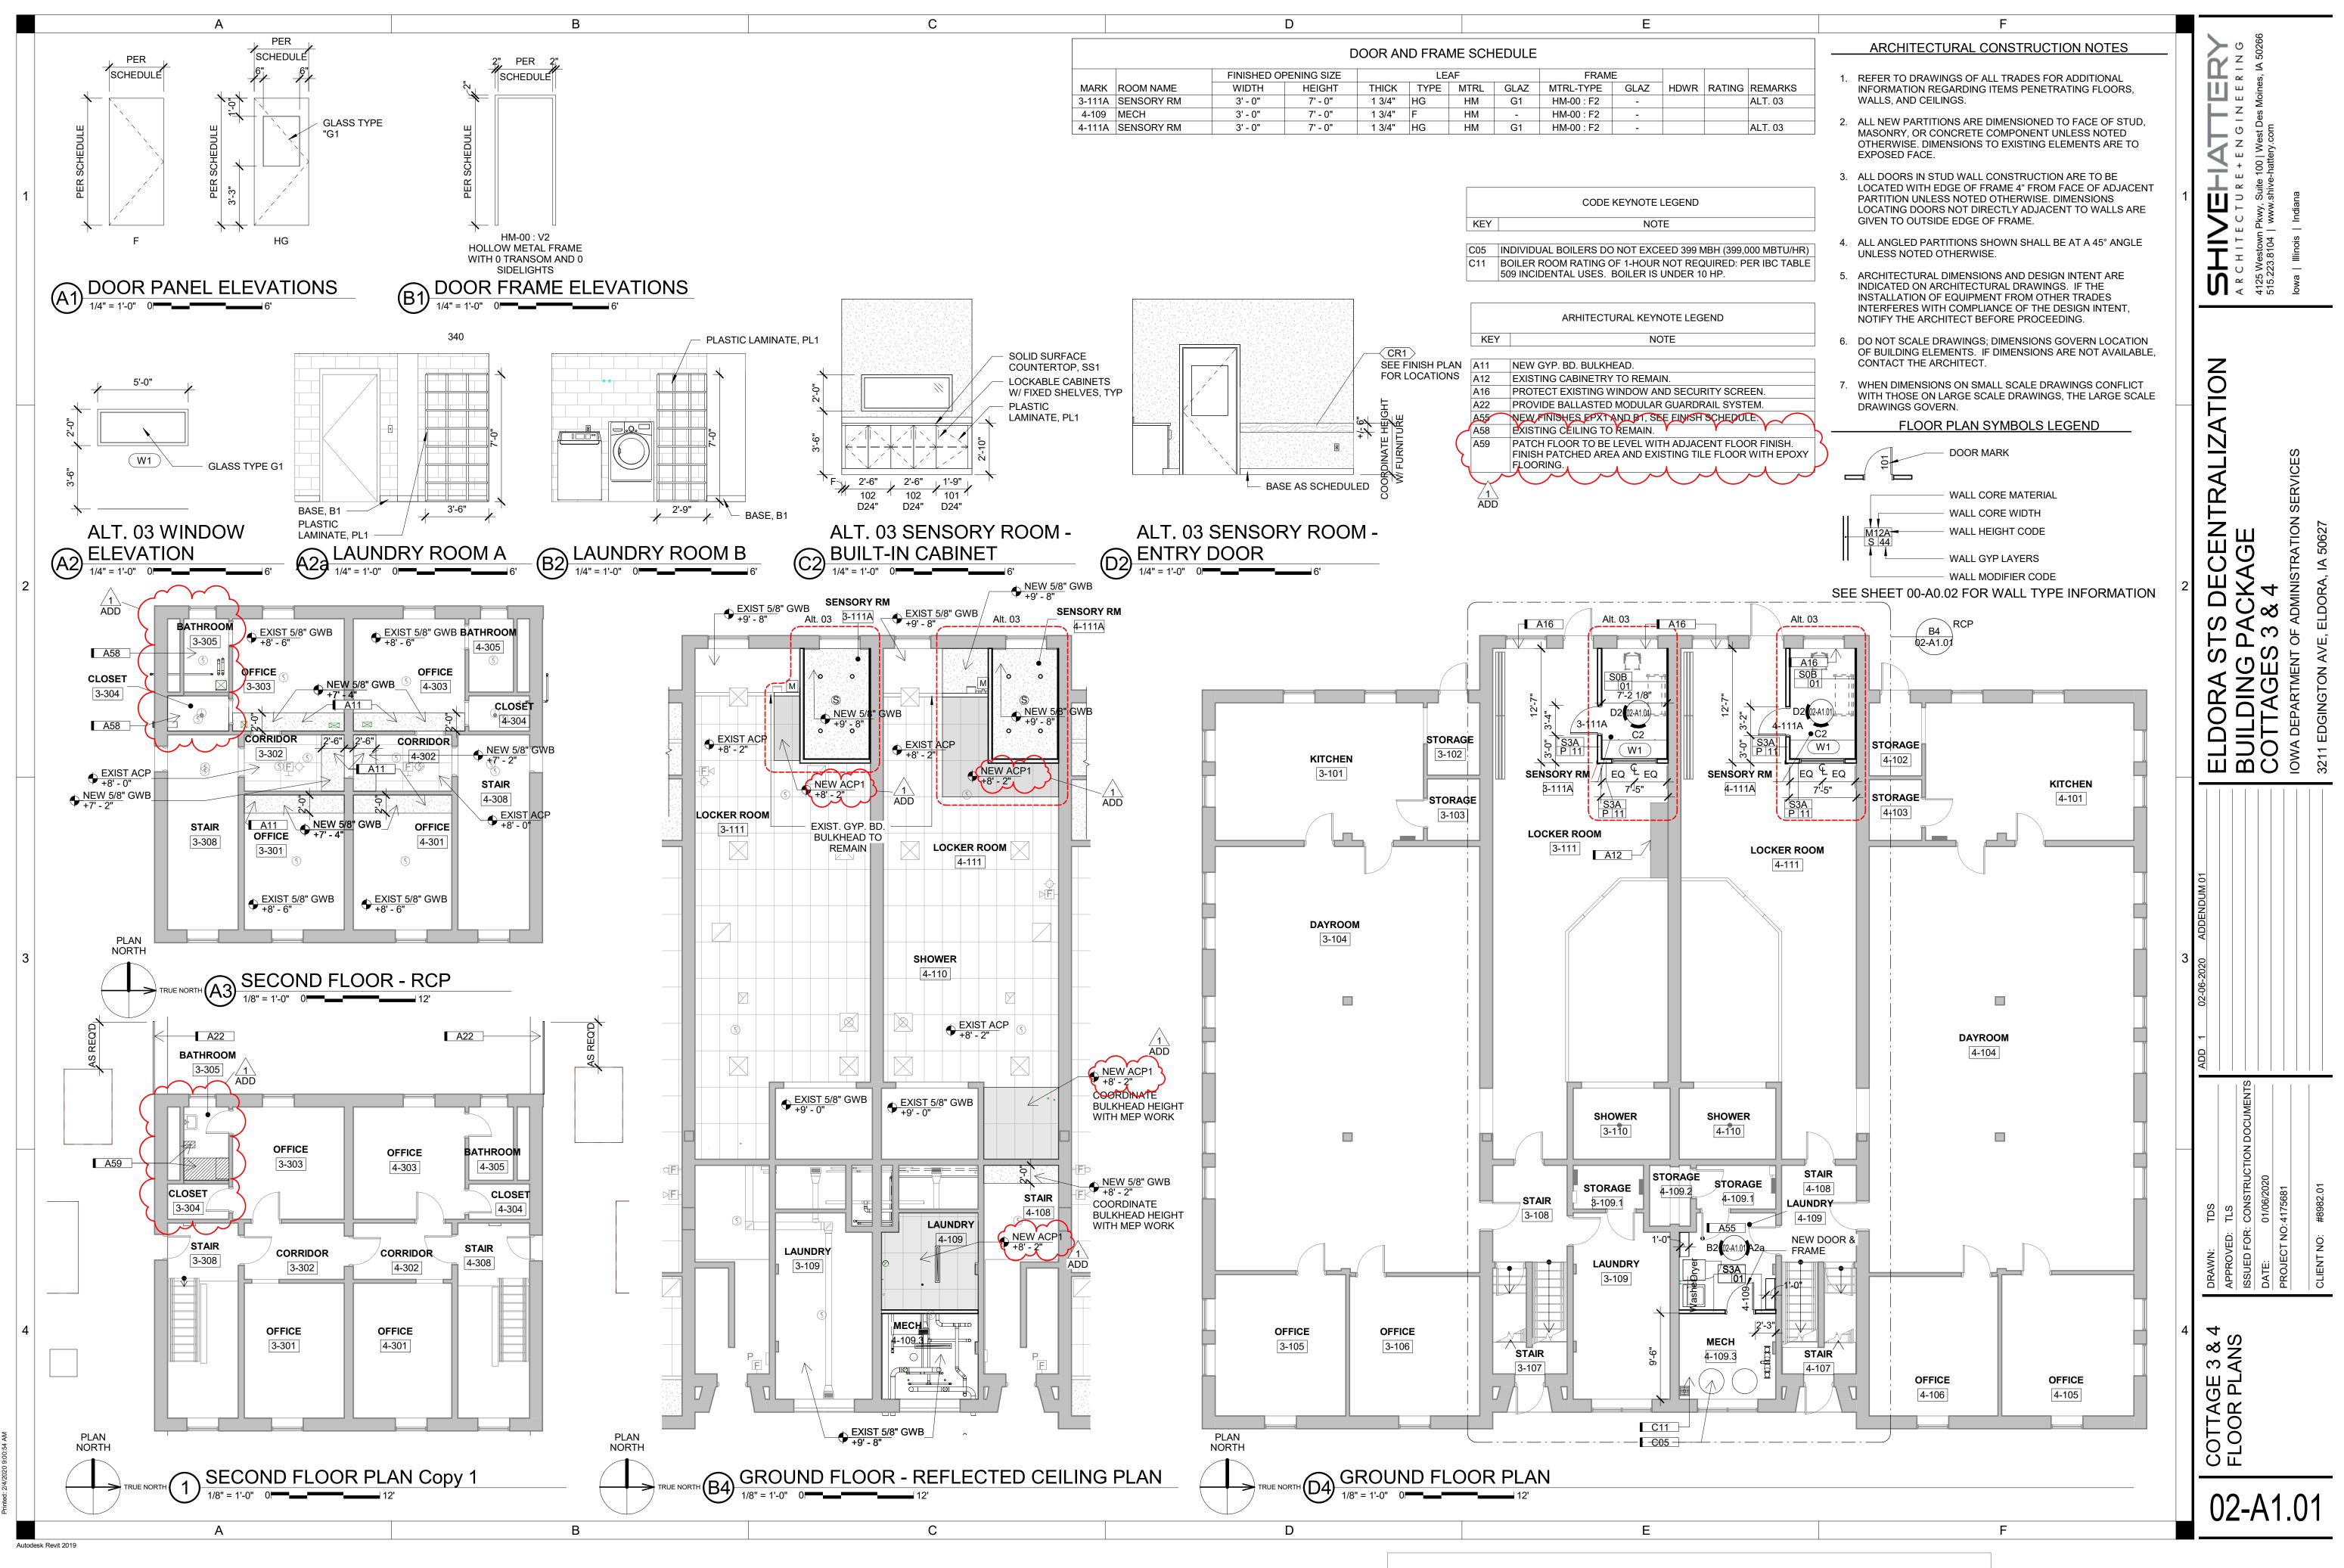

lshive\Revit\_Local\_2019\EldoraSTS-Cottage1-A-Cent\_tshtinar inted: 2/4/2020 9:00:54 AM


		Α		В	
	1				
	2				
	3				
	$\left  - \right $				
	4				
6 AM					
10					
0 9:00:5					
2/4/2020 9:00:5					
'rinted: 2/4/2020 9:00:5					
Printed: 2/4/2020 9:00:56 AM		A		B	1

### D

### ARCHITECTURAL DEMOLITION NOTES


- 1. FIELD VERIFY EXISTING CONDITIONS PRIOR TO START OF DEMOLITION WORK. NOTIFY ARCHITECT IN WRITING OF DISCREPANCIES BETWEEN WORK SHOWN IN THE DRAWINGS AND FIELD CONDITIONS ENCOUNTERED.
- 2. TO PROTECT OWNER AND CONTRACTOR, PHOTOGRAPHICALLY DOCUMENT EXISTING CONDITIONS TO REMAIN, PRIOR TO START OF DEMOLITION AND CONSTRUCTION ACTIVITIES. COPY ARCHITECT AND OWNER ON PHOTOGRAPHIC DOCUMENTATION.
- 3. OPEN FLAME EQUIPMENT IS NOT PERMITTED FOR REMOVAL OF EXISTING WORK WITHOUT SPECIFIC WRITTEN PERMISSION FROM THE OWNER.
- 4. COORDINATE WITH OWNER ANY ITEMS TO BE SALVAGED.
- 5. OWNER WILL REMOVE ALL NON-FIXED FURNISHINGS AND EQUIPMENT FROM THE CONSTRUCTION AREA PRIOR TO START OF CONSTRUCTION UNLESS NOTED OTHERWISE.
- 6. MAINTAIN BUILDING IN A WEATHER-TIGHT CONDITION. DO NOT PERFORM WORK ON EXTERIOR OPENINGS THAT CANNOT BE COMPLETED OR MADE WEATHER-TIGHT WHEN INCLEMENT WEATHER IS POSSIBLE.
- 7. REMOVE FLOOR MATERIALS TO THE EXTENT SHOWN OR DESCRIBED IN THE DRAWINGS. REMOVAL INCLUDES ADHESIVES, GROUTING BEDS, ANCHORING DEVICES, ASSOCIATED WALL BASE, ETC. CLEAN AND PREPARE SURFACES FOR INSTALLATION OF NEW FLOOR MATERIALS.
- 8. COORDINATE CUTTING AND PATCHING REQUIRED FOR DEMOLITION OR NEW CONSTRUCTION WITH OTHER TRADES.


	DEMO KEYNOTE LEGEND
KEY	NOTE
A09	COORDINATE WITH NEW MECHANICAL EQUIPMENT'S LOCATION AND SIZE. PATCH WALLS TO MATCH CONTIGUOUS CONSTRUCTIO AND FINISHES. PAINT WALLS. COORDINATE WITH MECHANICAL, ELECTRICAL, AND PLUMBING SCOPES.
A30	DEMO EXISTING CEILING TO ACCOMMODATE NEW MECHANICAL DUCTWORK.
A56	RELOCATE EXISTING EXIT SIGN TO FACE OF NEW BULKHEAD.
AD31	DEMOLISH EXISTING TUB. CAPLINES. SEE MECH FOR SCOPE.
AD32	PEMOLISH AXISTING SHELVES.
AD33	DEMOLISH EXISTING TOILET. CAP LINES AS REQUIRED.

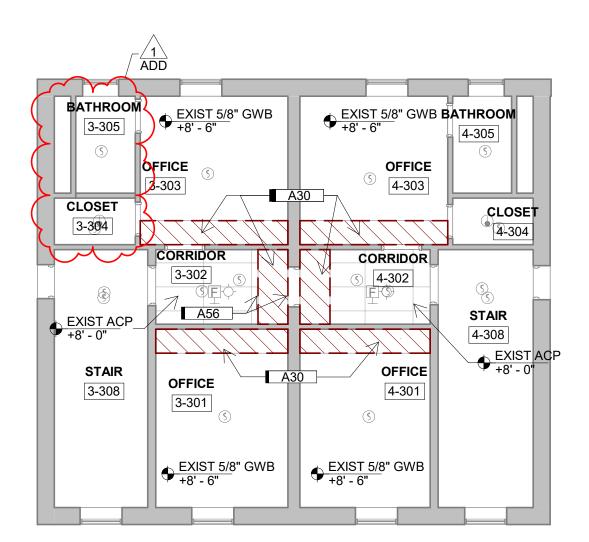

(4C) SECOND FLOOR - REFLECTED CEILING DEMO PLAN

D

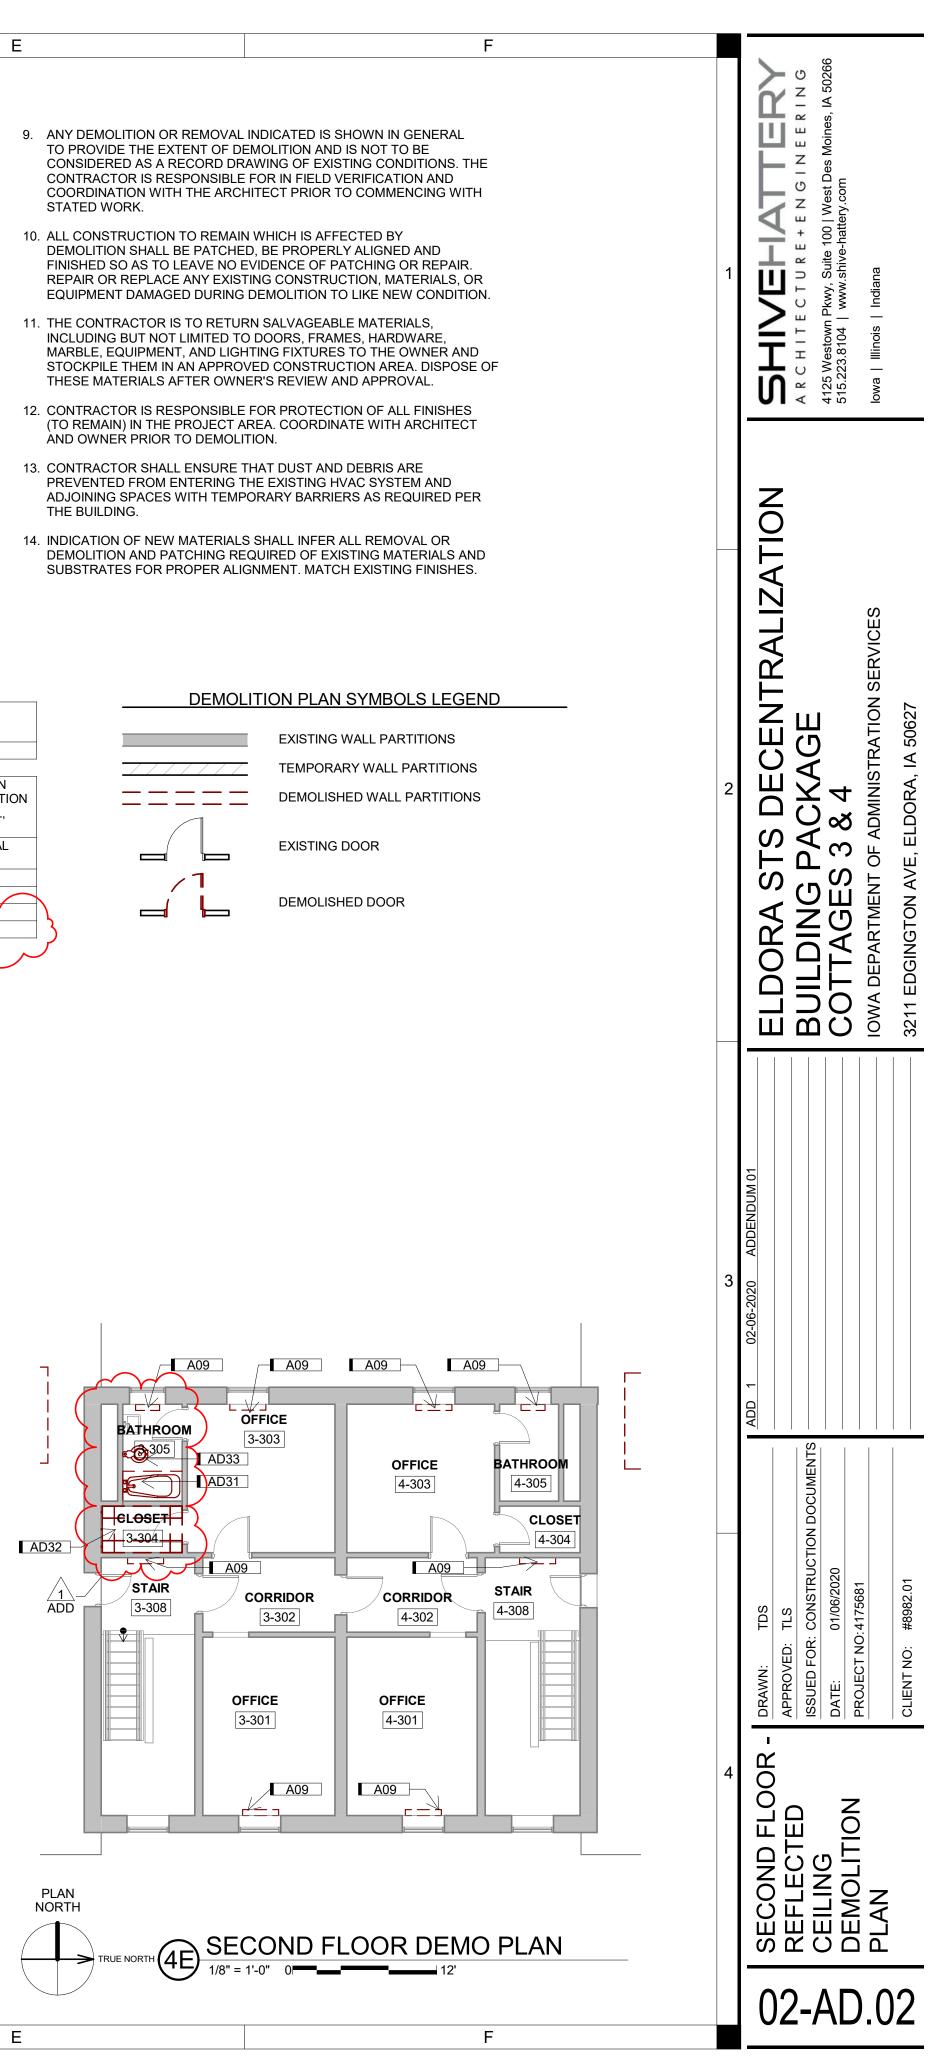

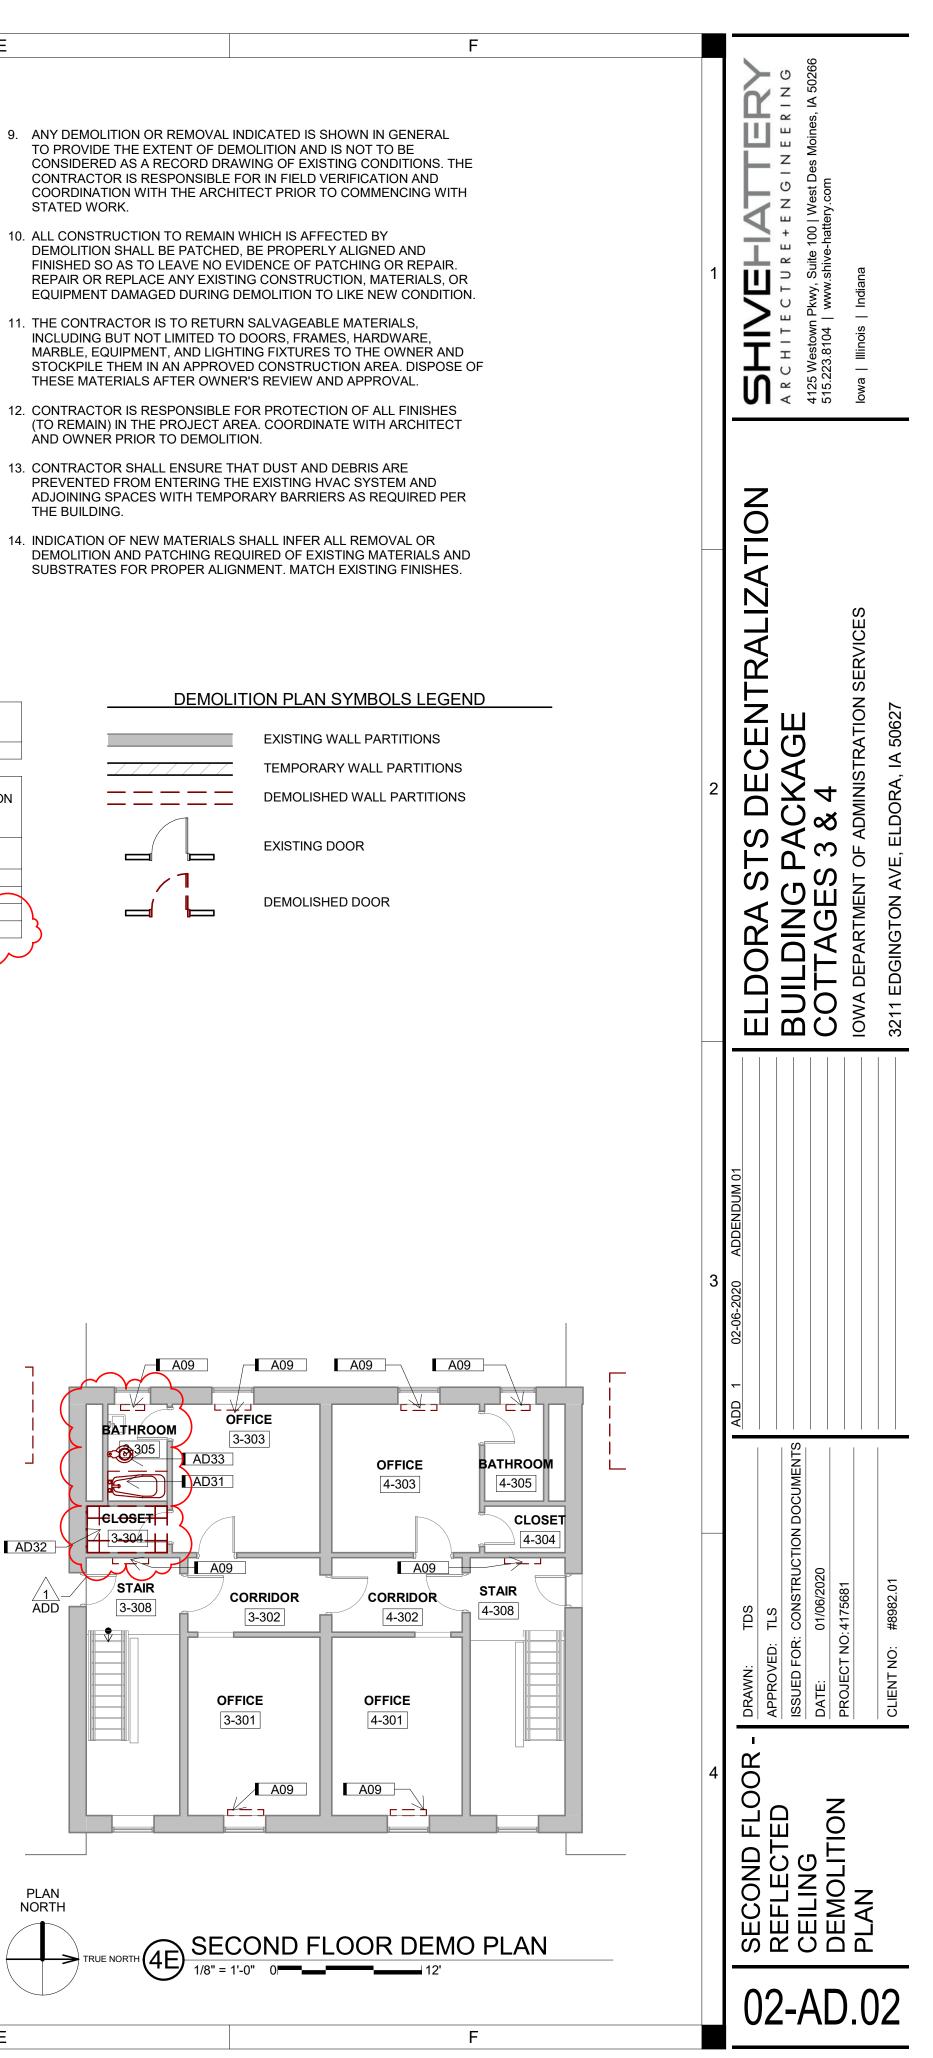

### С


RUE NORTH

PLAN NORTH




REFLECTED	CEILING PLAN SYMBOLS LEGEND
ACP-1 +8'-0"	<ul> <li>CEILING MATERIAL DESIGNATION</li> <li>CEILING HEIGHT</li> </ul>
	GYPSUM BOARD CEILING/ SOFFIT
	ACOUSTICAL CEILING PANEL SYSTEM
0	SURFACE LIGHT
$\oslash$	RECESSED LIGHT
0	SURFACE LIGHT
• • •	SUSPENDED OR PENDANT LIGHT
	RECESSED LIGHT
<b>⊢</b>	STRIP LIGHT
	COVE LIGHT
œ E	EXIT SIGN
	ACCESS PANEL
	RETURN AIR GRILLE
	SUPPLY AIR DIFFUSER
	EXHAUST AIR GRILLE
S	SPEAKER
<sup>(S)</sup> P	SMOKE DETECTOR

	CODE KEYNOTE LEGEND
KEY	NOTE
C11	BOILER ROOM RATING OF 1-HOUR NOT REQUIRED: PER I
CII	
	INCIDENTAL USES. BOILER IS UNDER 10 HP.
	INCIDENTAL USES. BOILER IS UNDER 10 HP.

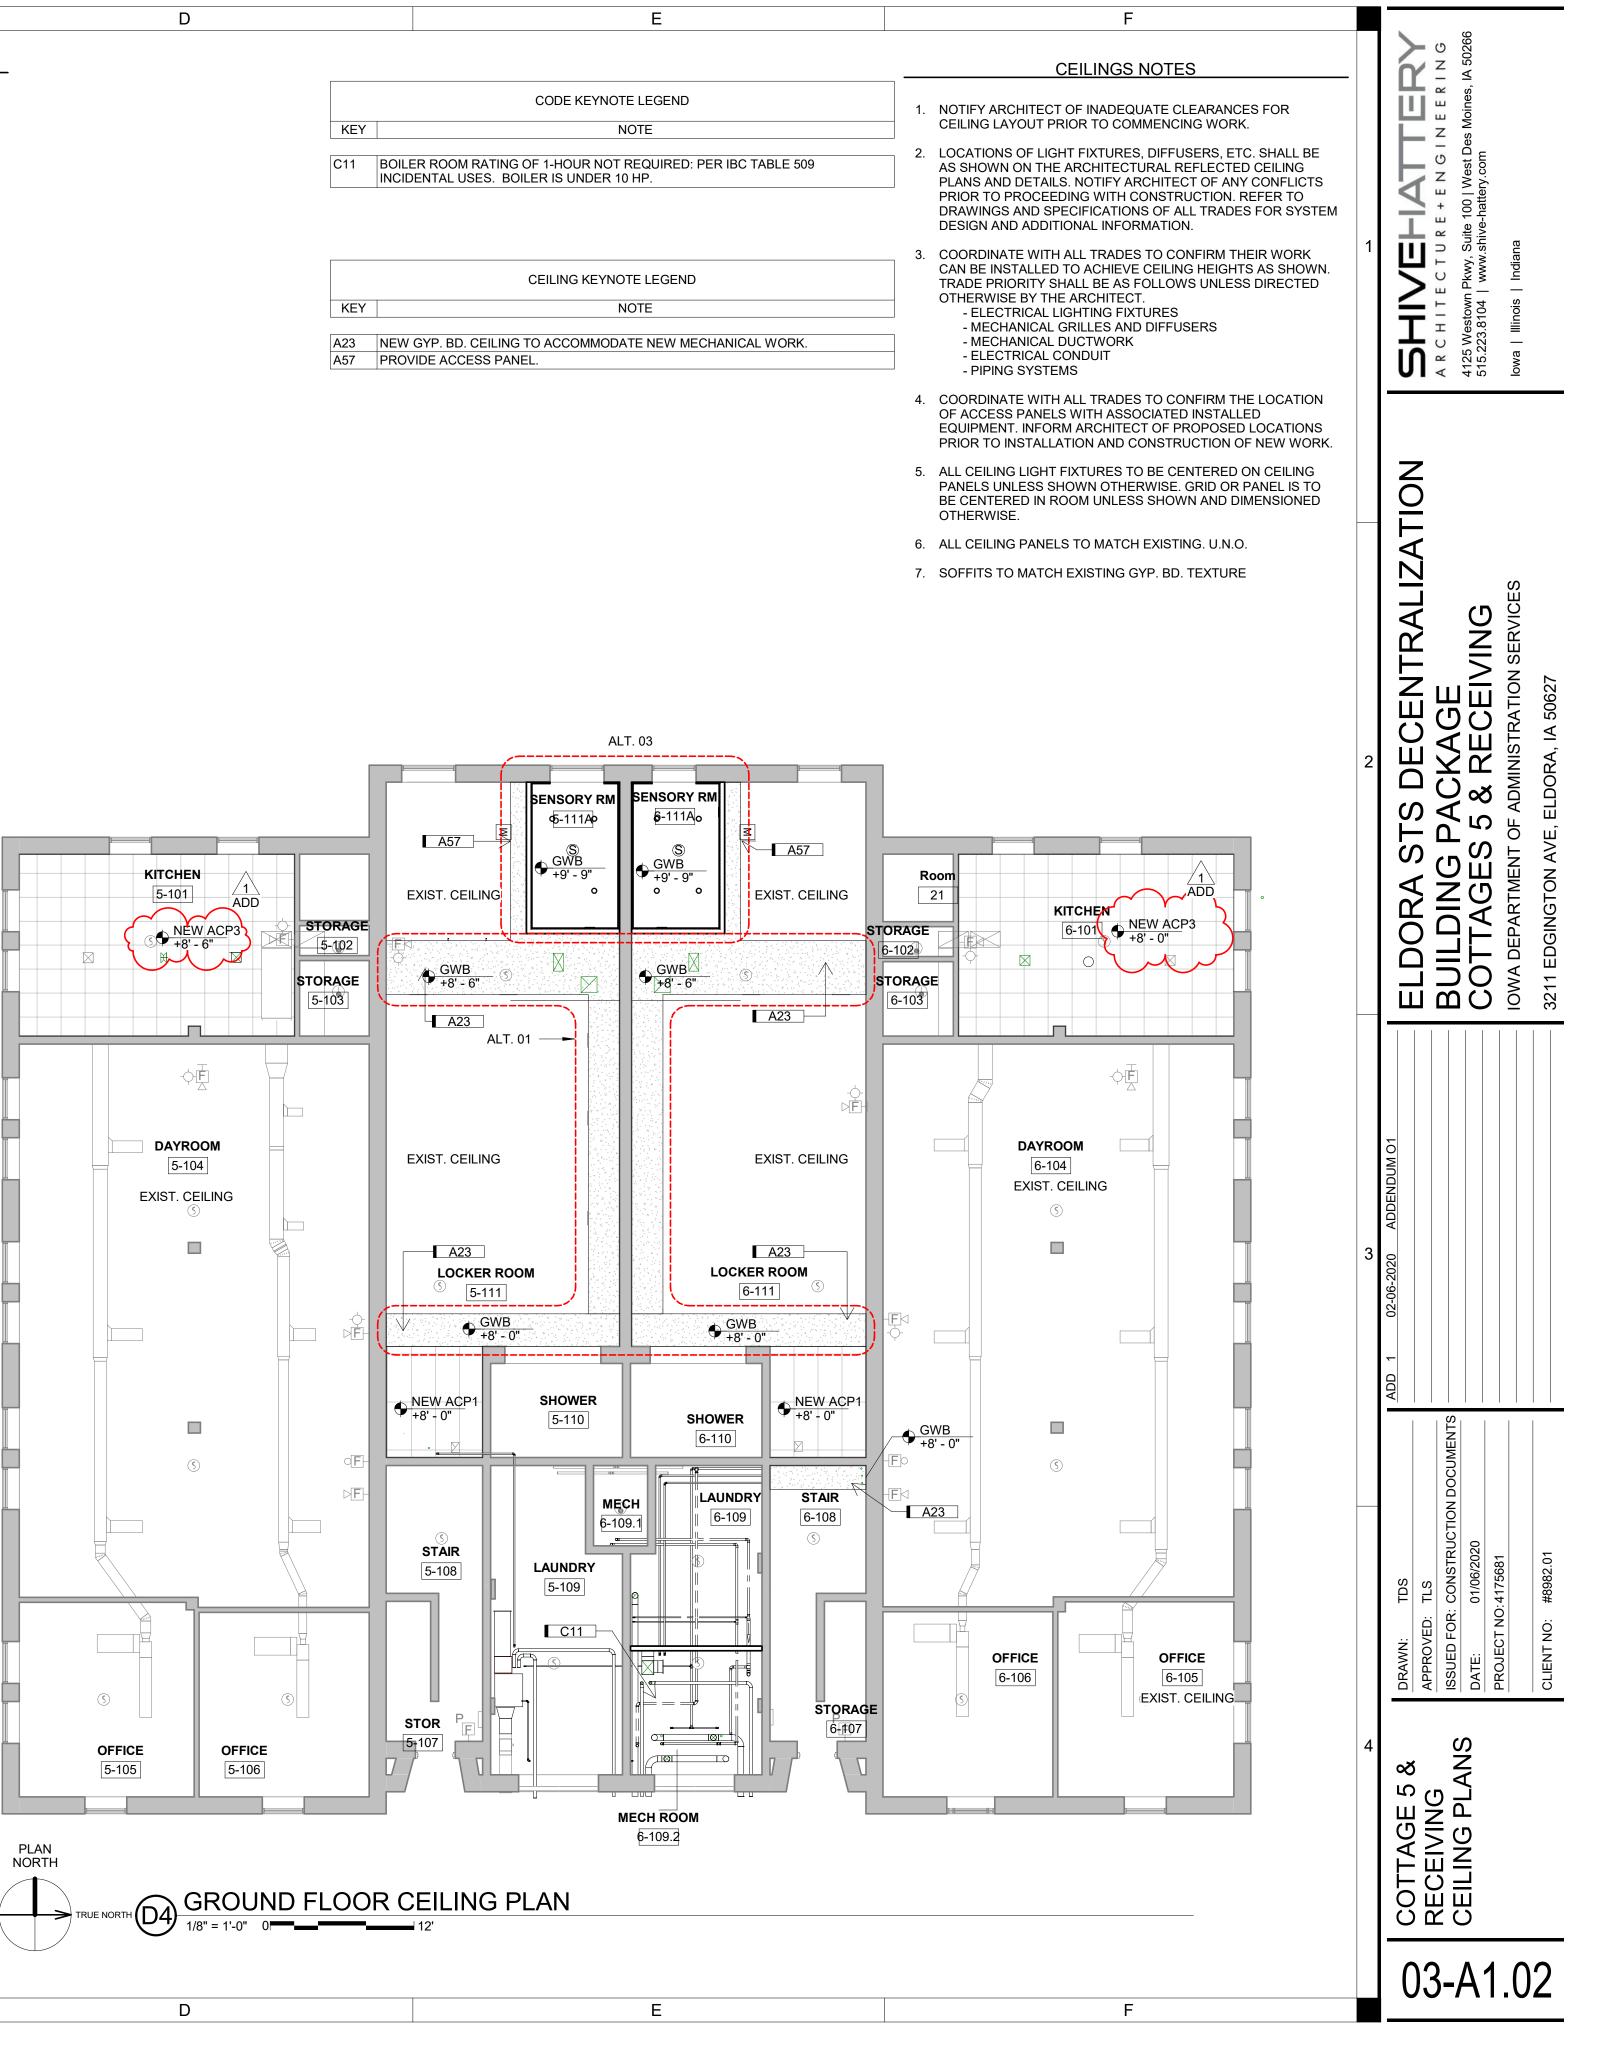







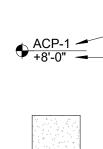


<b></b>	CEILING HEIGHT
	GYPSUM BOARD CEILING/ SOFFIT - SEE MATERIAL FINISH LEGEND
	ACOUSTICAL CEILING PANEL SYSTEM - SEE MATERIAL FINISH LEGEND
	SURFACE LIGHT
	RECESSED LIGHT
	SURFACE LIGHT
	SUSPENDED OR PENDANT LIGHT
	RECESSED LIGHT
	STRIP LIGHT
	COVE LIGHT
	EXIT SIGN
	ACCESS PANEL
	RETURN AIR GRILLE
	SUPPLY AIR DIFFUSER
	EXHAUST AIR GRILLE
	SPEAKER




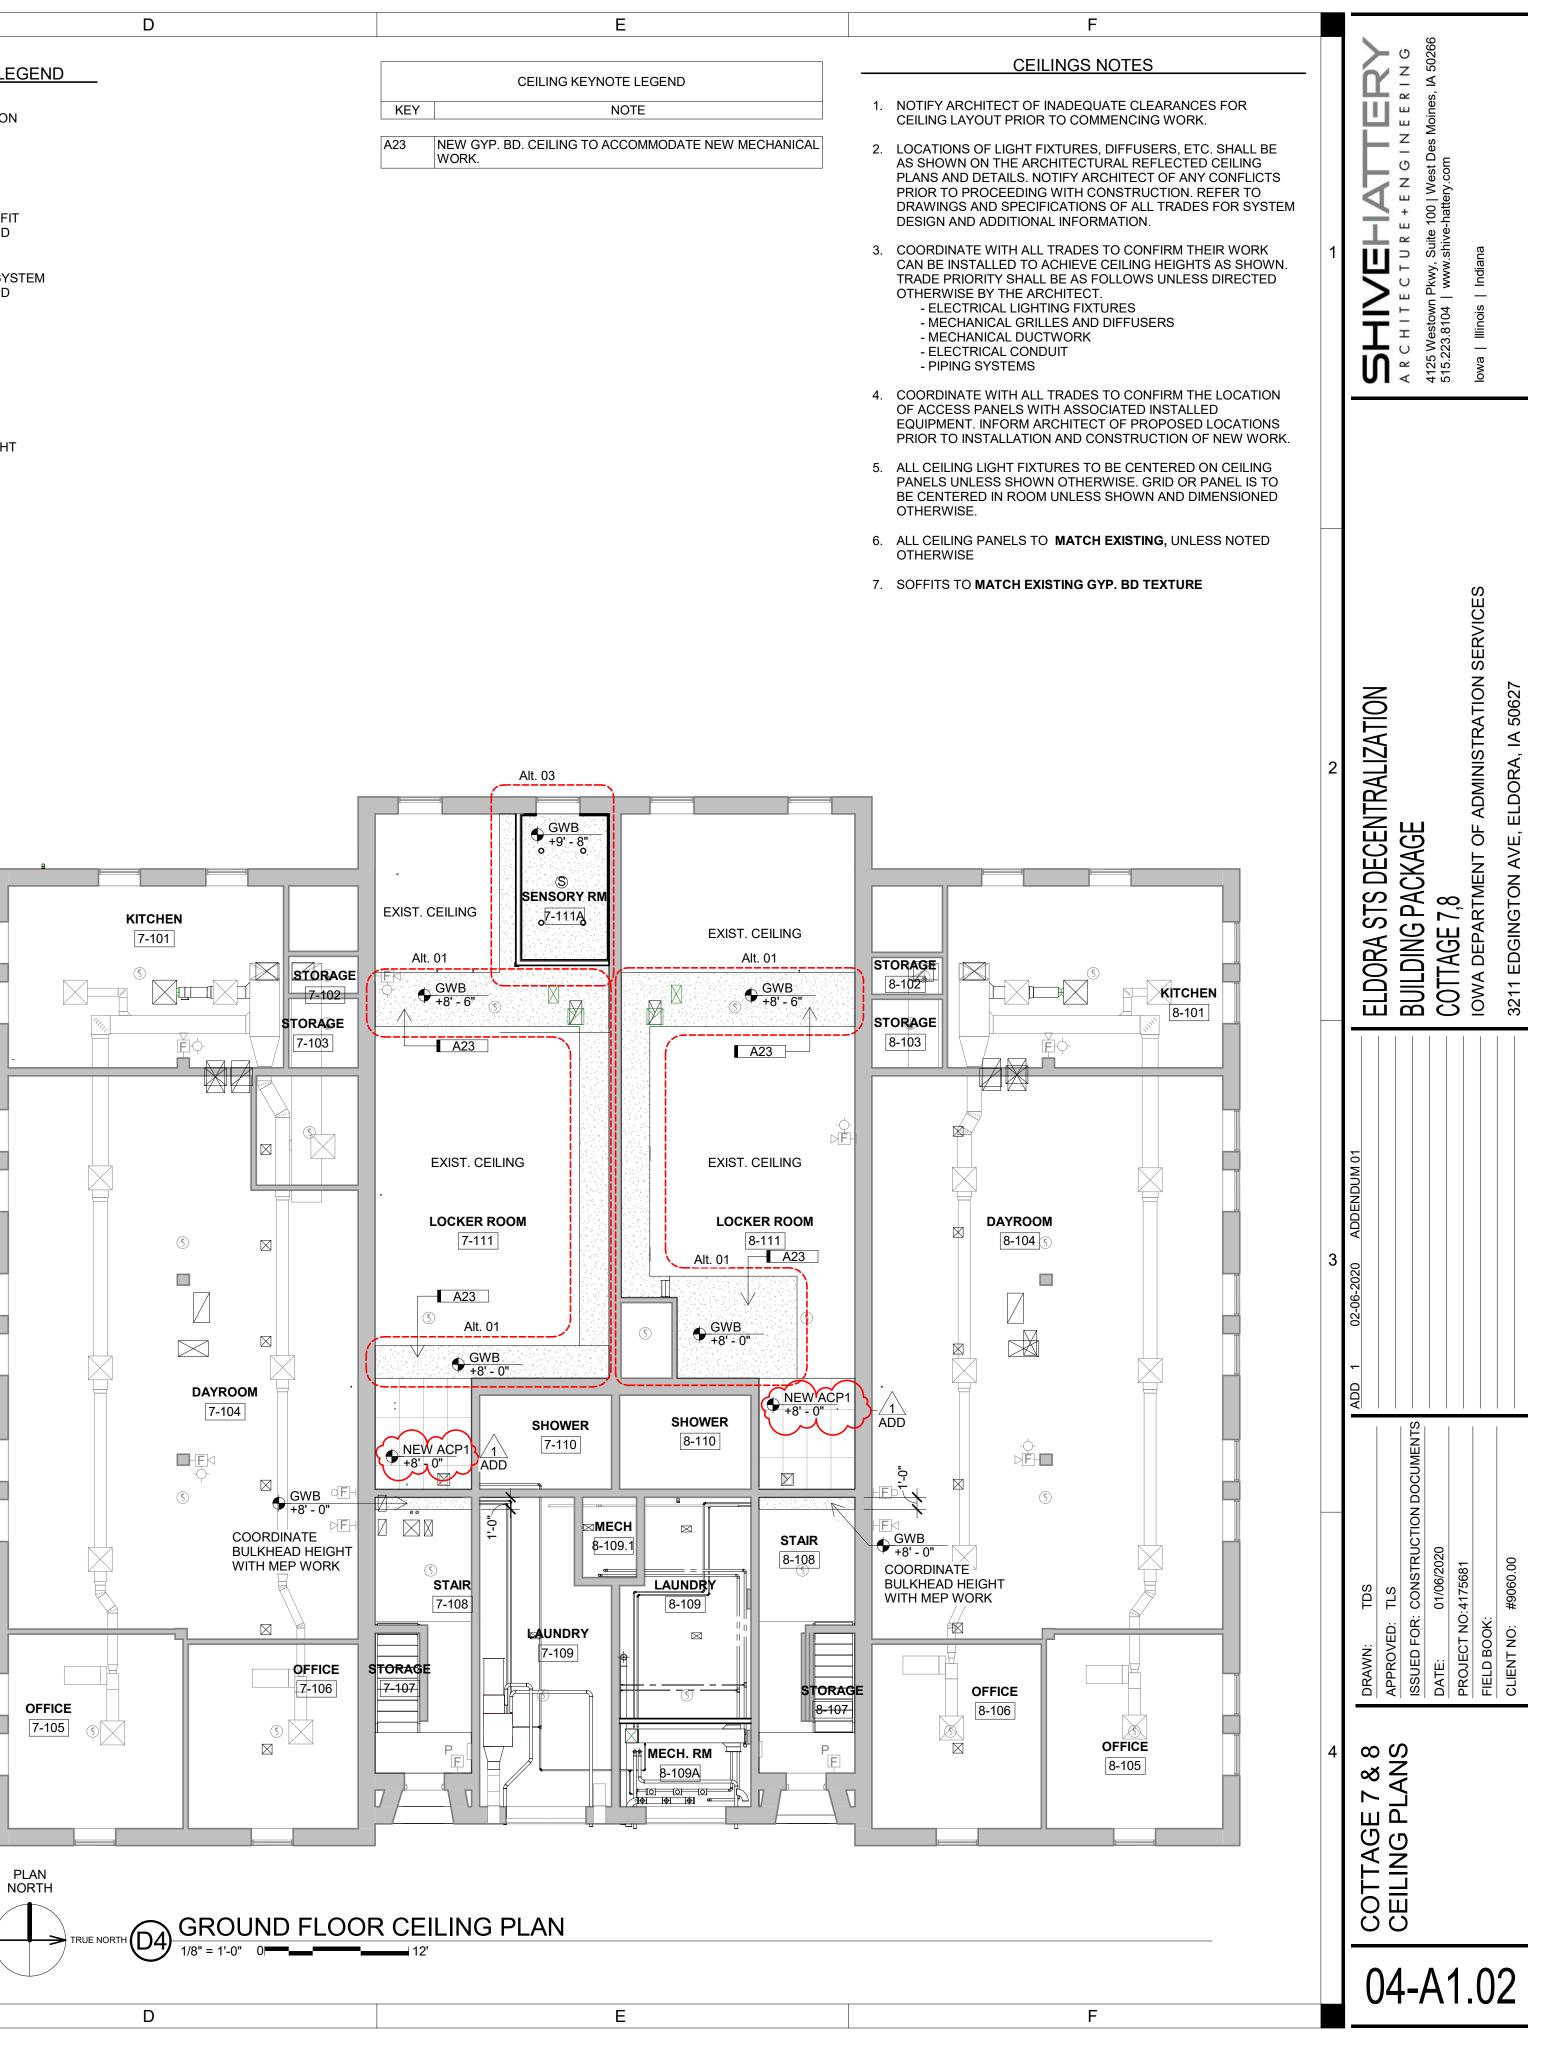


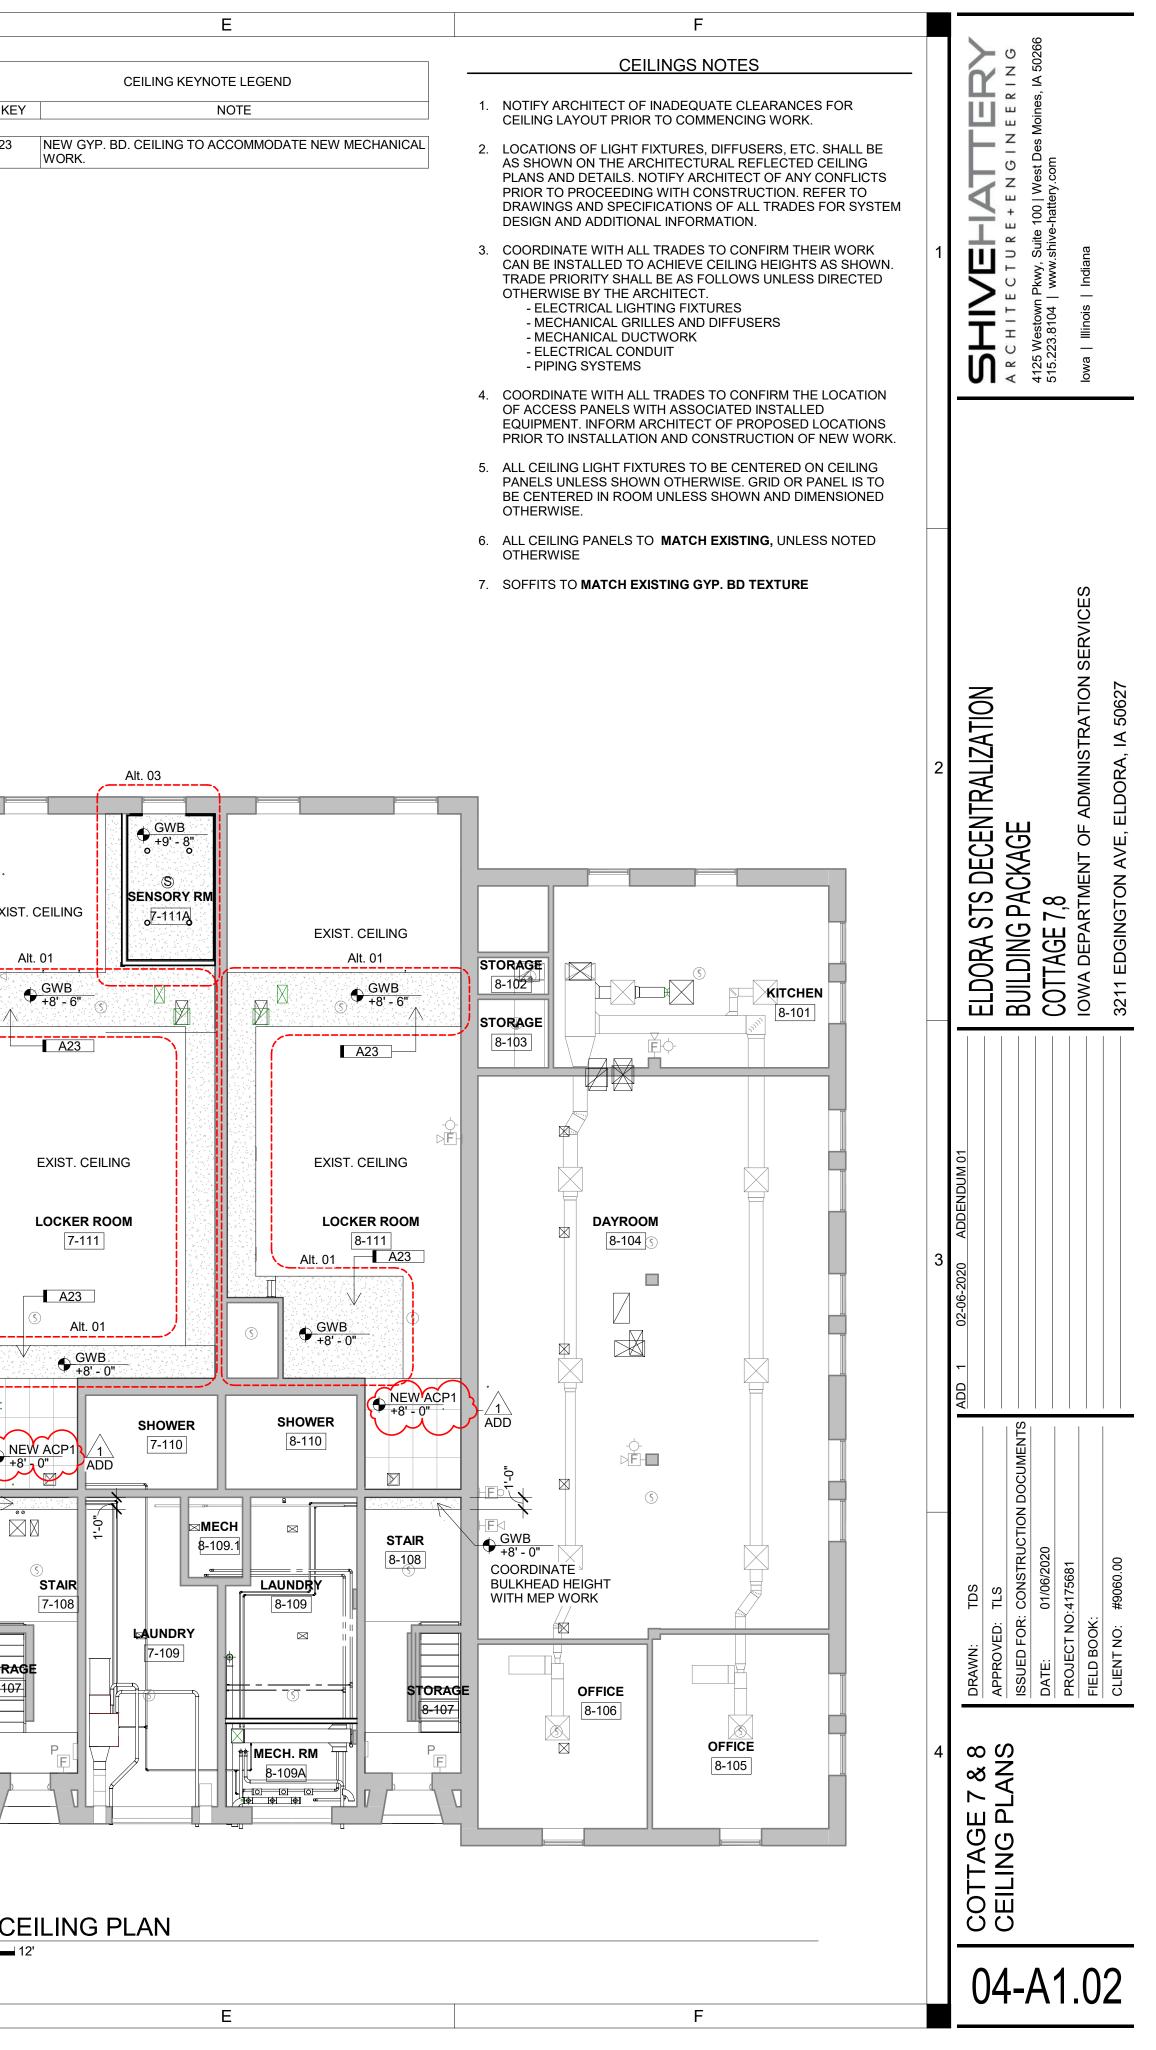


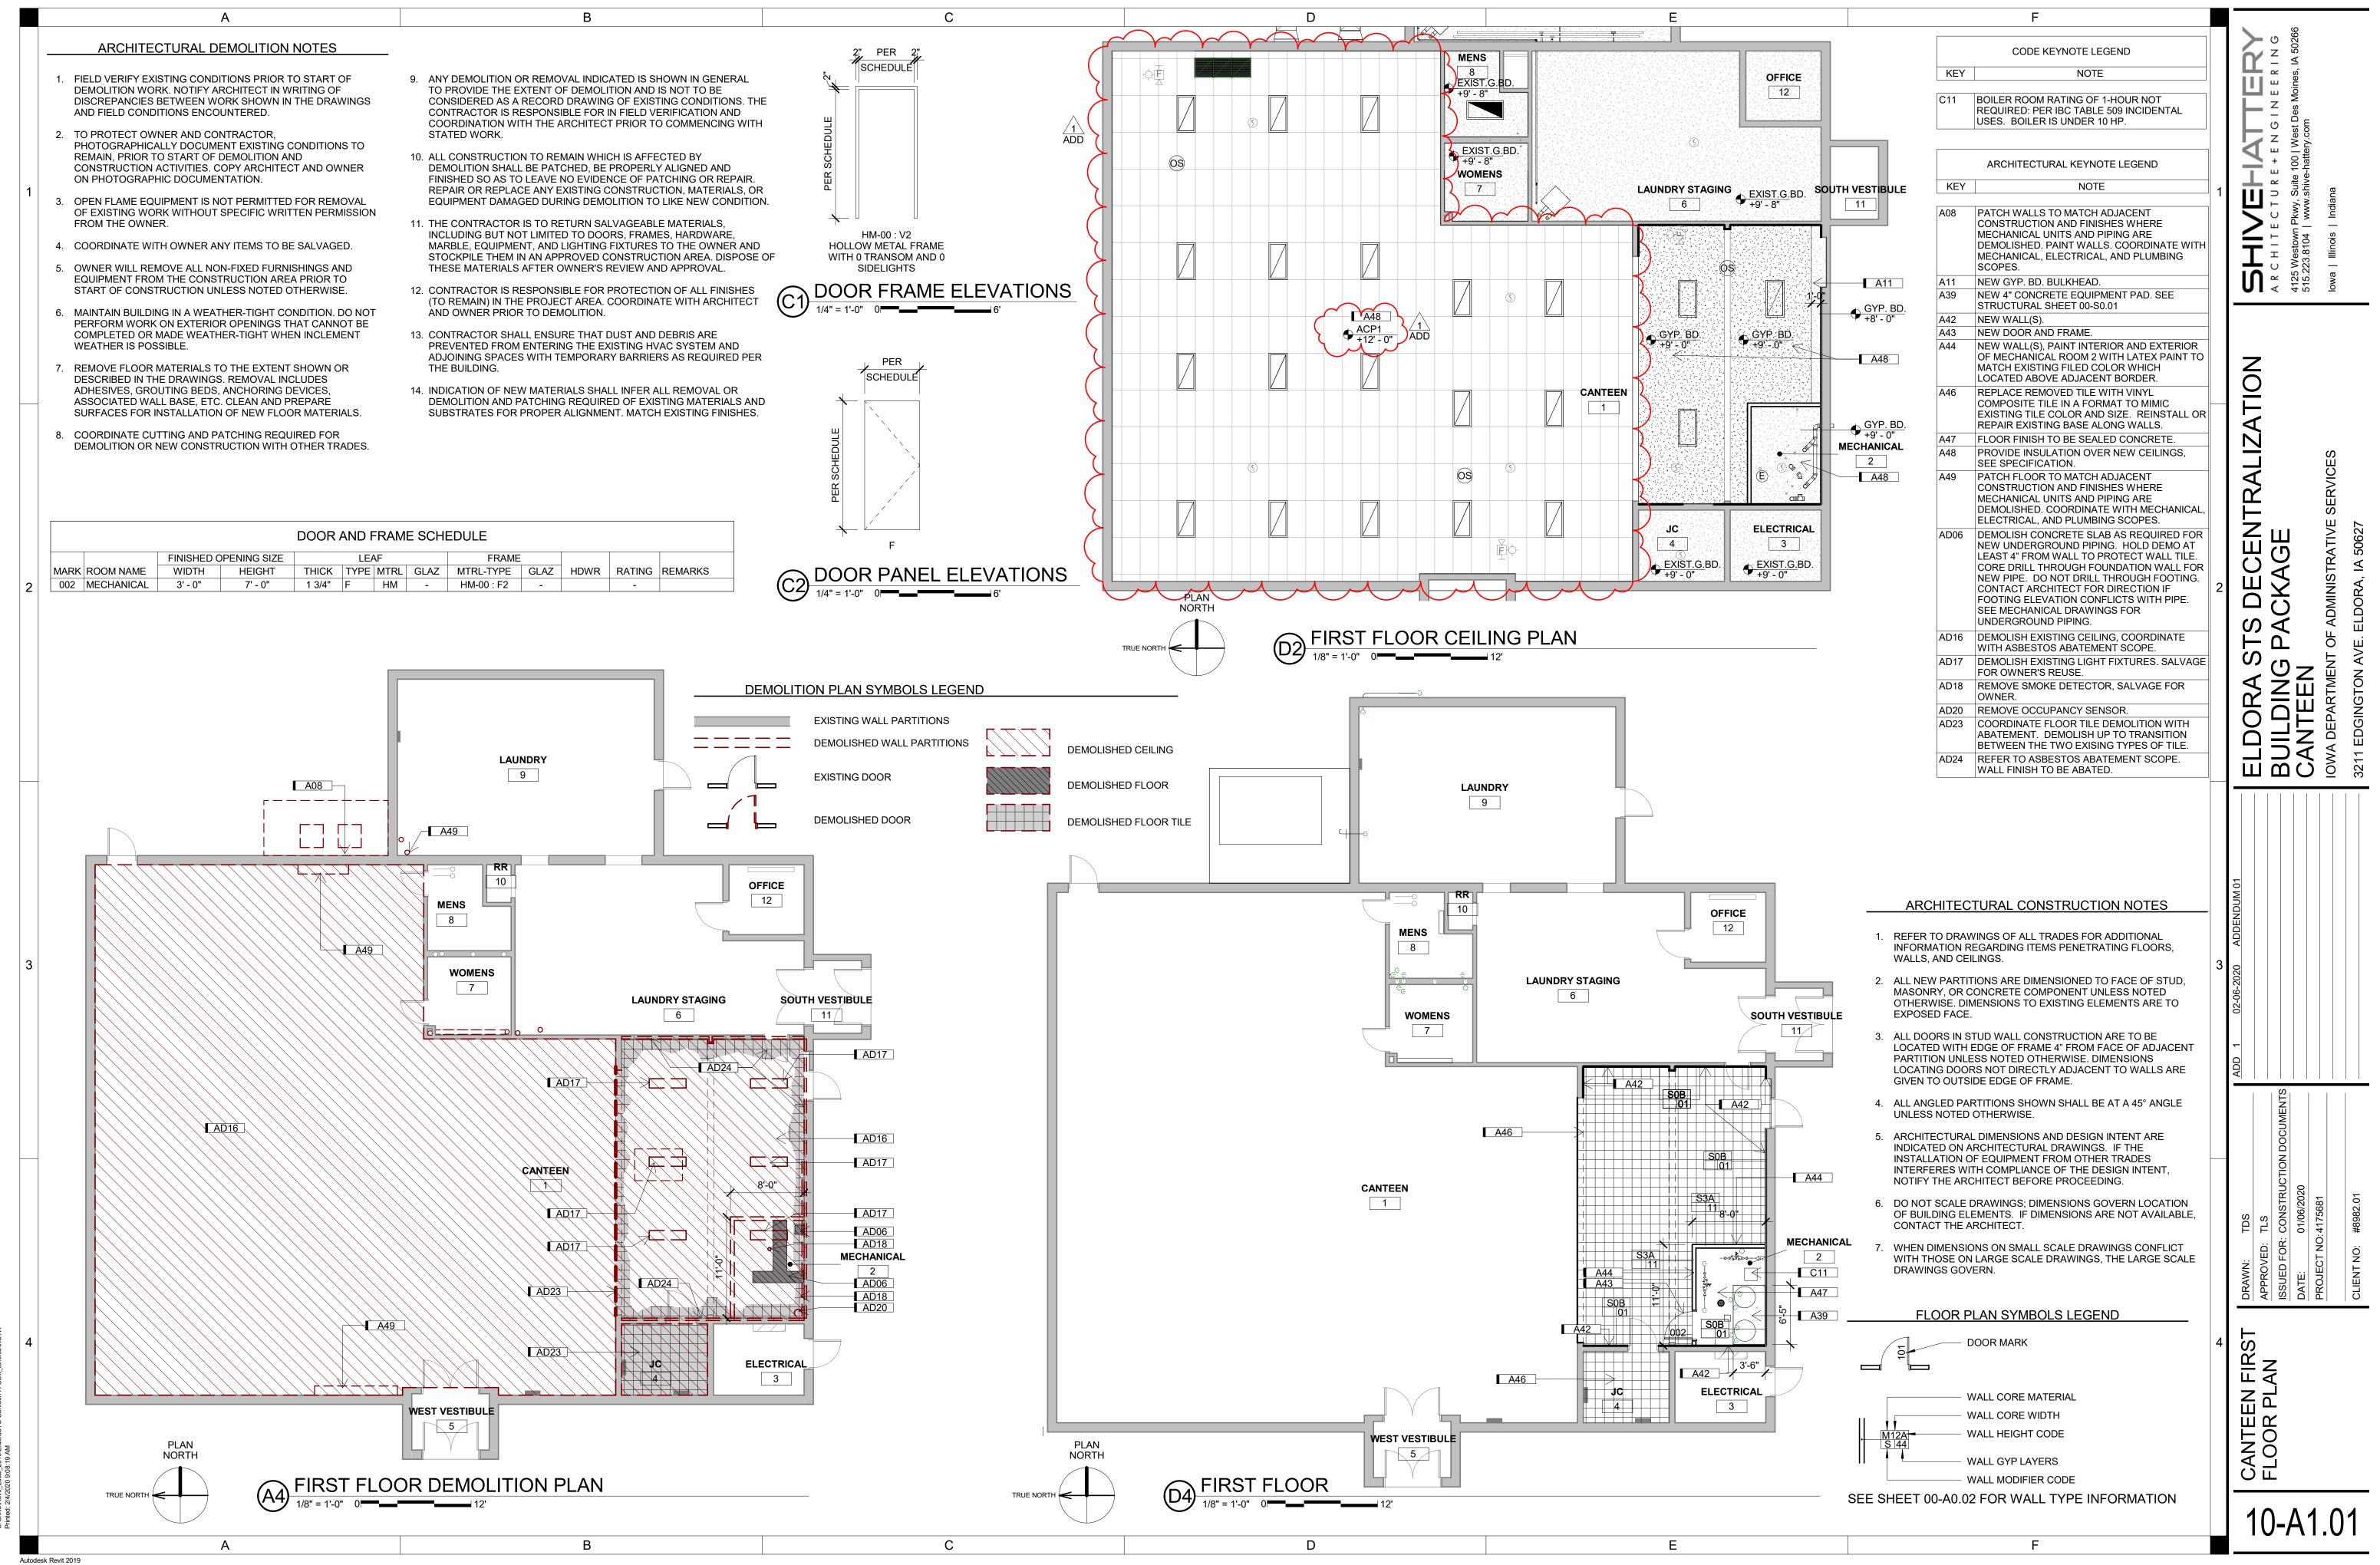

KEY	NOTE								
C11	BOILER ROOM RATING OF 1-HOUR NOT								
•••	REQUIRED: PER IBC TABLE 509 INCIDENTAL								
	USES. BOILER IS UNDER 10 HP.								
	ARCHITECTURAL KEYNOTE LEGEND								
KEY	NOTE								
A08	PATCH WALLS TO MATCH ADJACENT								
/100	CONSTRUCTION AND FINISHES WHERE								
	MECHANICAL UNITS AND PIPING ARE								
	DEMOLISHED. PAINT WALLS. COORDINATE WITH								
	MECHANICAL, ELECTRICAL, AND PLUMBING								
	SCOPES.								
A11	NEW GYP. BD. BULKHEAD.								
A39	NEW 4" CONCRETE EQUIPMENT PAD. SEE								
	STRUCTURAL SHEET 00-S0.01								
A42	NEW WALL(S).								
A43	NEW DOOR AND FRAME.								
A44	NEW WALL(S), PAINT INTERIOR AND EXTERIOR								
	OF MECHANICAL ROOM 2 WITH LATEX PAINT TO								
	MATCH EXISTING FILED COLOR WHICH								
	LOCATED ABOVE ADJACENT BORDER.								
A46	REPLACE REMOVED TILE WITH VINYL								
	COMPOSITE TILE IN A FORMAT TO MIMIC								
	EXISTING TILE COLOR AND SIZE. REINSTALL OF								
	REPAIR EXISTING BASE ALONG WALLS.								
A47	FLOOR FINISH TO BE SEALED CONCRETE.								
A48	PROVIDE INSULATION OVER NEW CEILINGS,								
	SEE SPECIFICATION.								
A49	PATCH FLOOR TO MATCH ADJACENT								
	CONSTRUCTION AND FINISHES WHERE								
	MECHANICAL UNITS AND PIPING ARE								
	DEMOLISHED. COORDINATE WITH MECHANICAL ELECTRICAL, AND PLUMBING SCOPES.								
	·								
AD06	DEMOLISH CONCRETE SLAB AS REQUIRED FOR								
	NEW UNDERGROUND PIPING. HOLD DEMO AT								
	LEAST 4" FROM WALL TO PROTECT WALL TILE. CORE DRILL THROUGH FOUNDATION WALL FOR								
	NEW PIPE. DO NOT DRILL THROUGH FOOTING.								
	CONTACT ARCHITECT FOR DIRECTION IF								
	FOOTING ELEVATION CONFLICTS WITH PIPE.								
	SEE MECHANICAL DRAWINGS FOR								
	UNDERGROUND PIPING.								
AD16	DEMOLISH EXISTING CEILING, COORDINATE								
-	WITH ASBESTOS ABATEMENT SCOPE.								
AD17	DEMOLISH EXISTING LIGHT FIXTURES. SALVAGE								
	FOR OWNER'S REUSE.								
AD18	REMOVE SMOKE DETECTOR, SALVAGE FOR								
	OWNER.								
AD20	REMOVE OCCUPANCY SENSOR.								
AD23	COORDINATE FLOOR TILE DEMOLITION WITH								
	ABATEMENT. DEMOLISH UP TO TRANSITION								
	BETWEEN THE TWO EXISING TYPES OF TILE.								
AD24	REFER TO ASBESTOS ABATEMENT SCOPE.								
	WALL FINISH TO BE ABATED.								

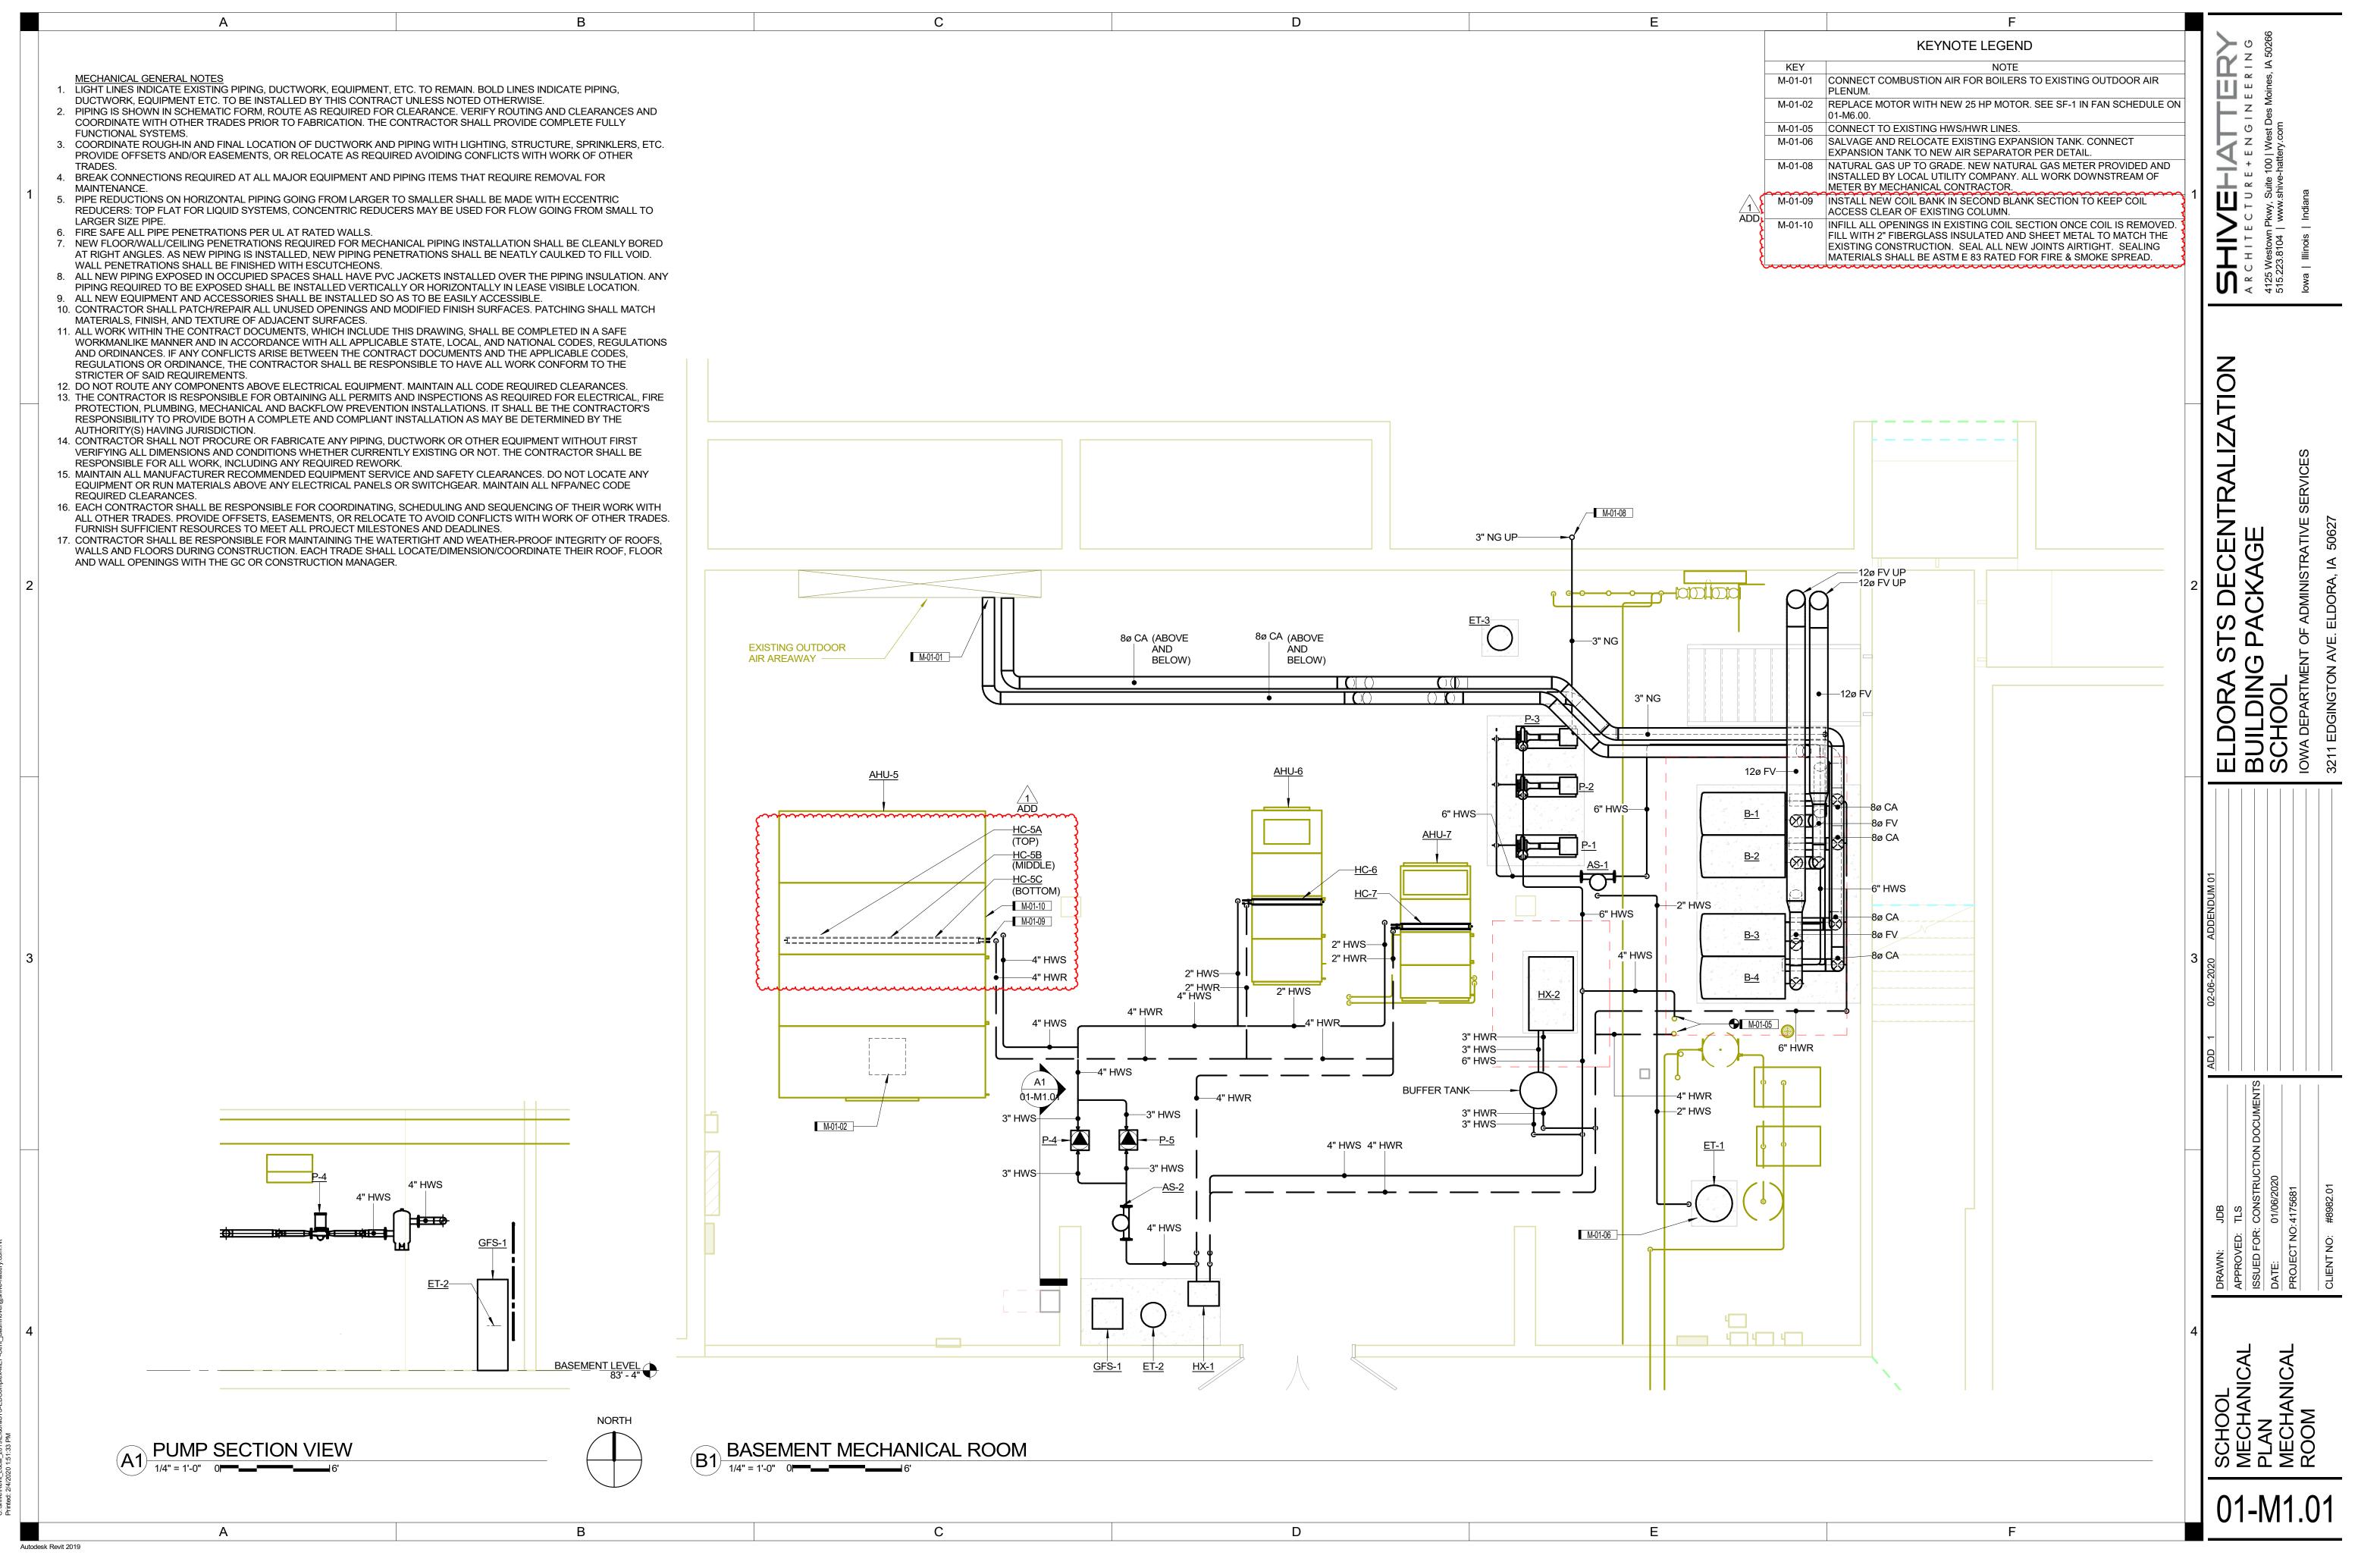

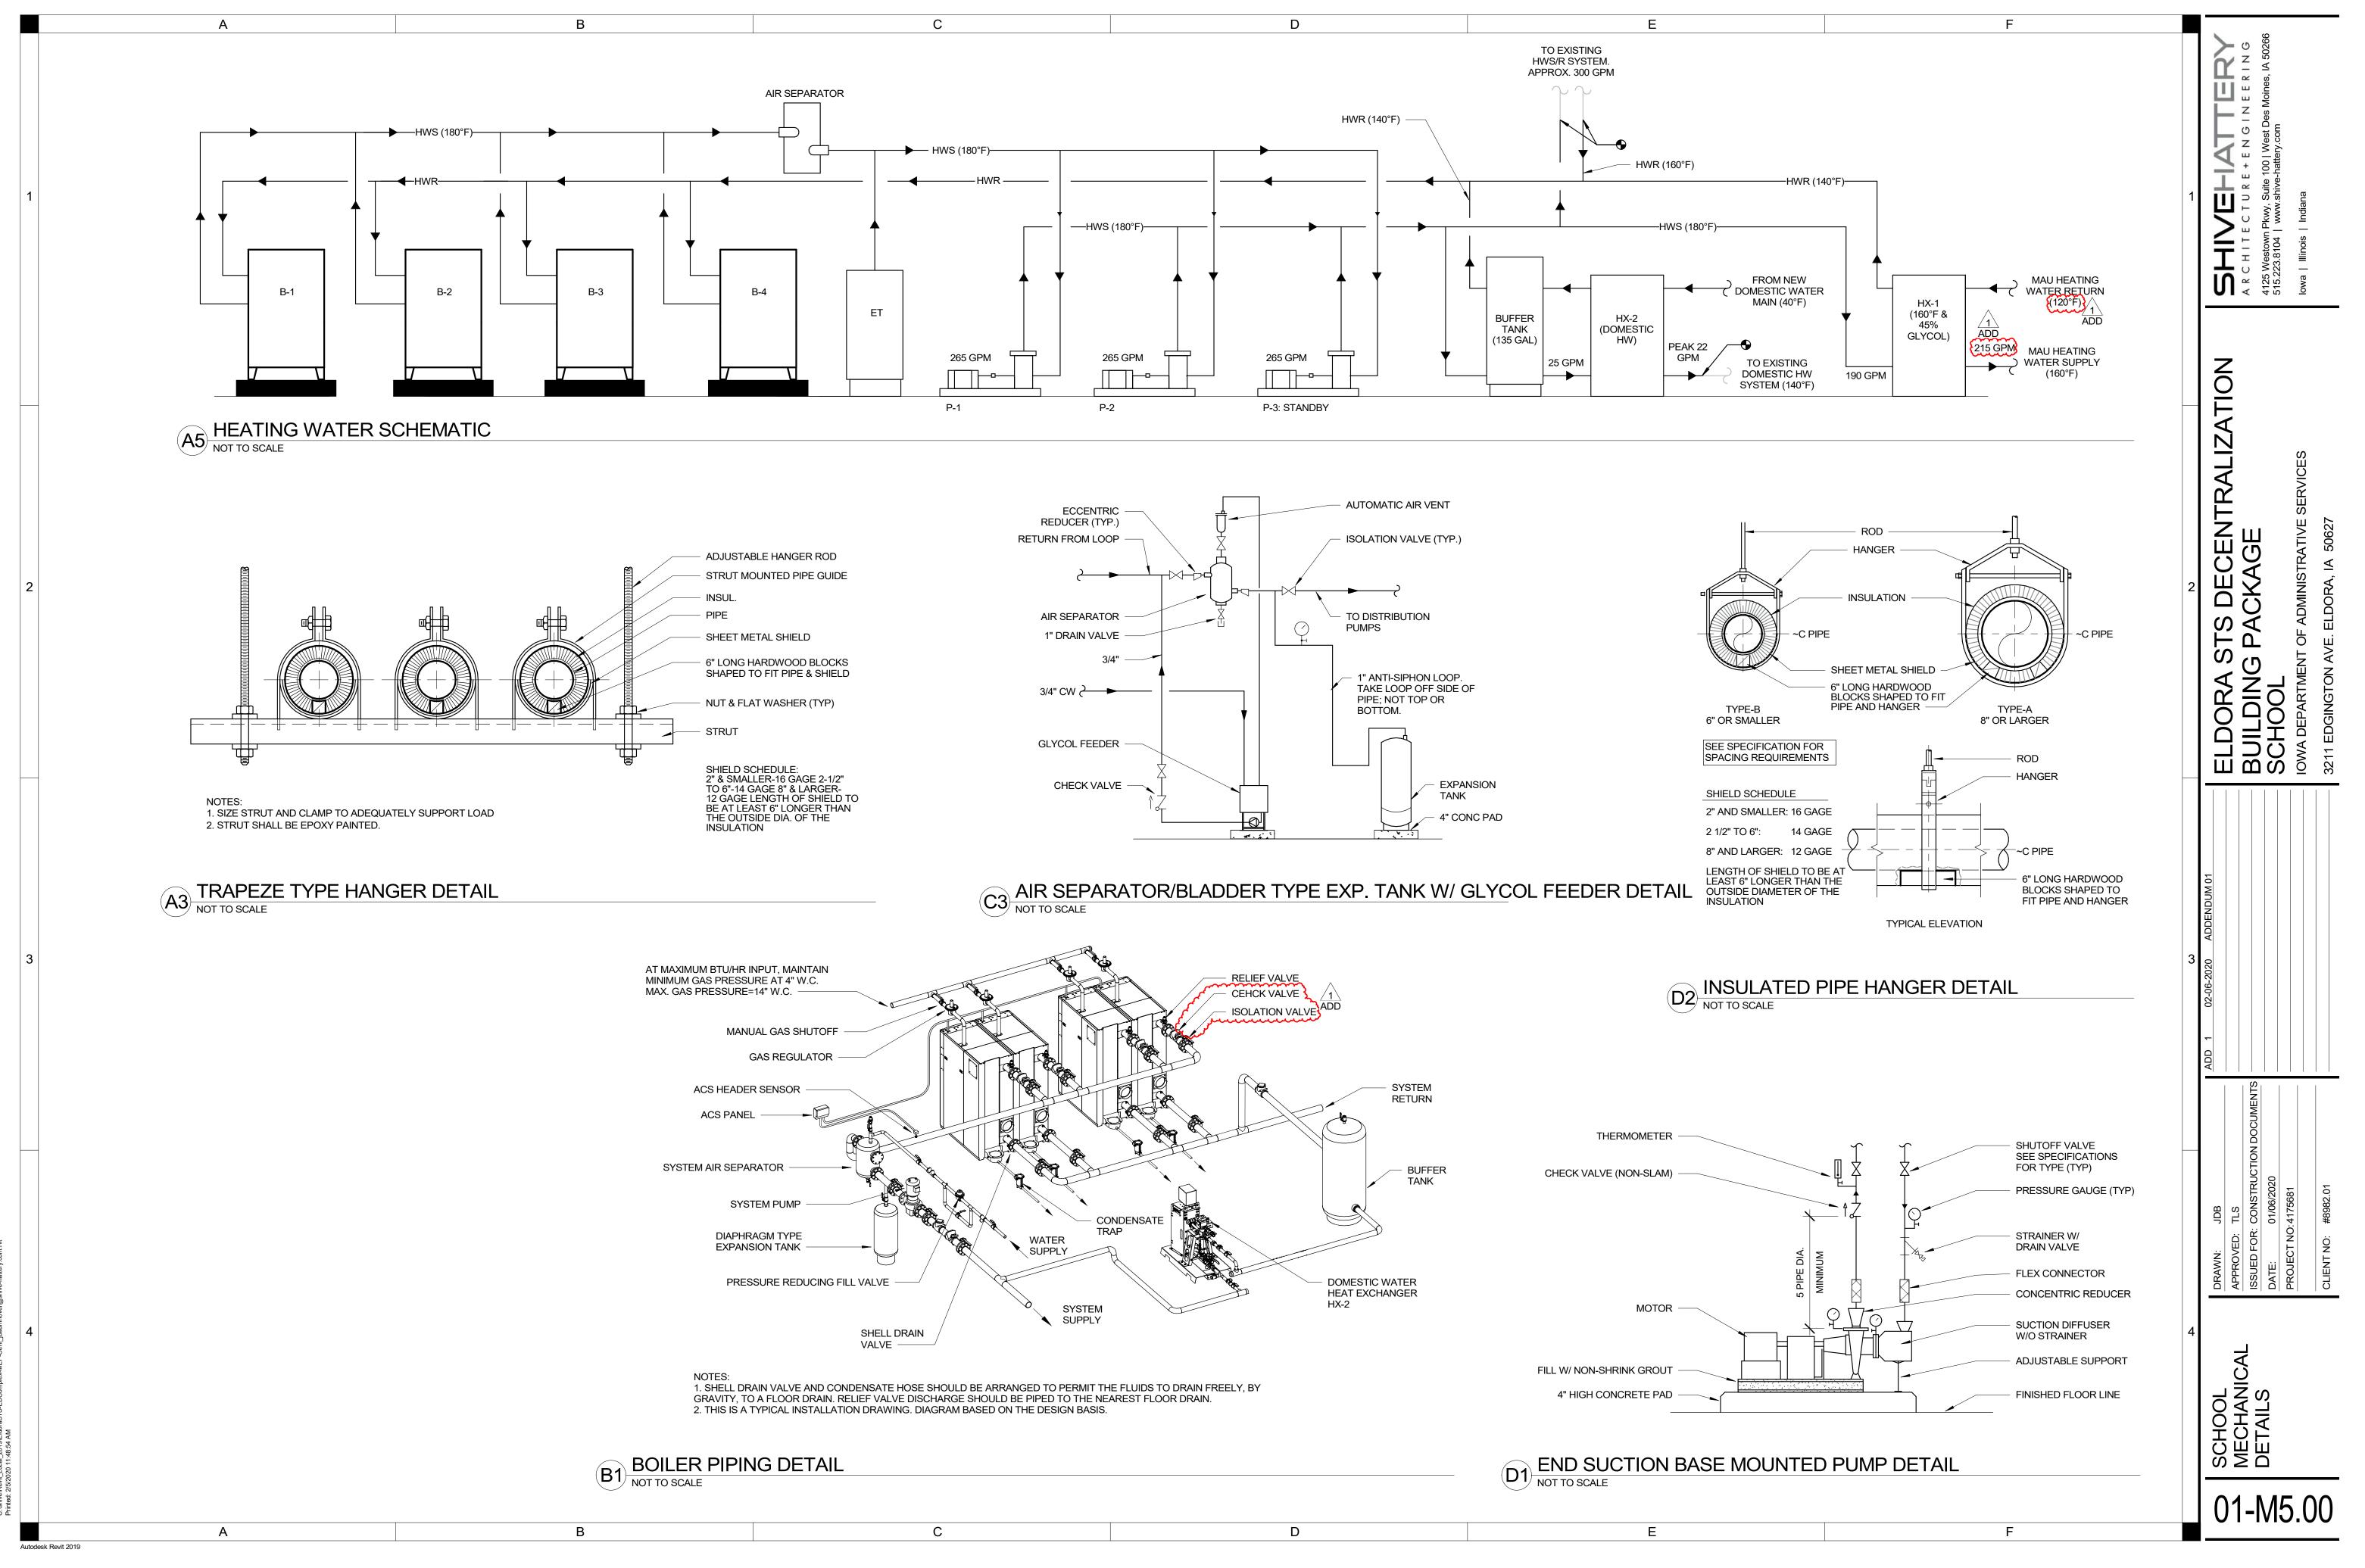

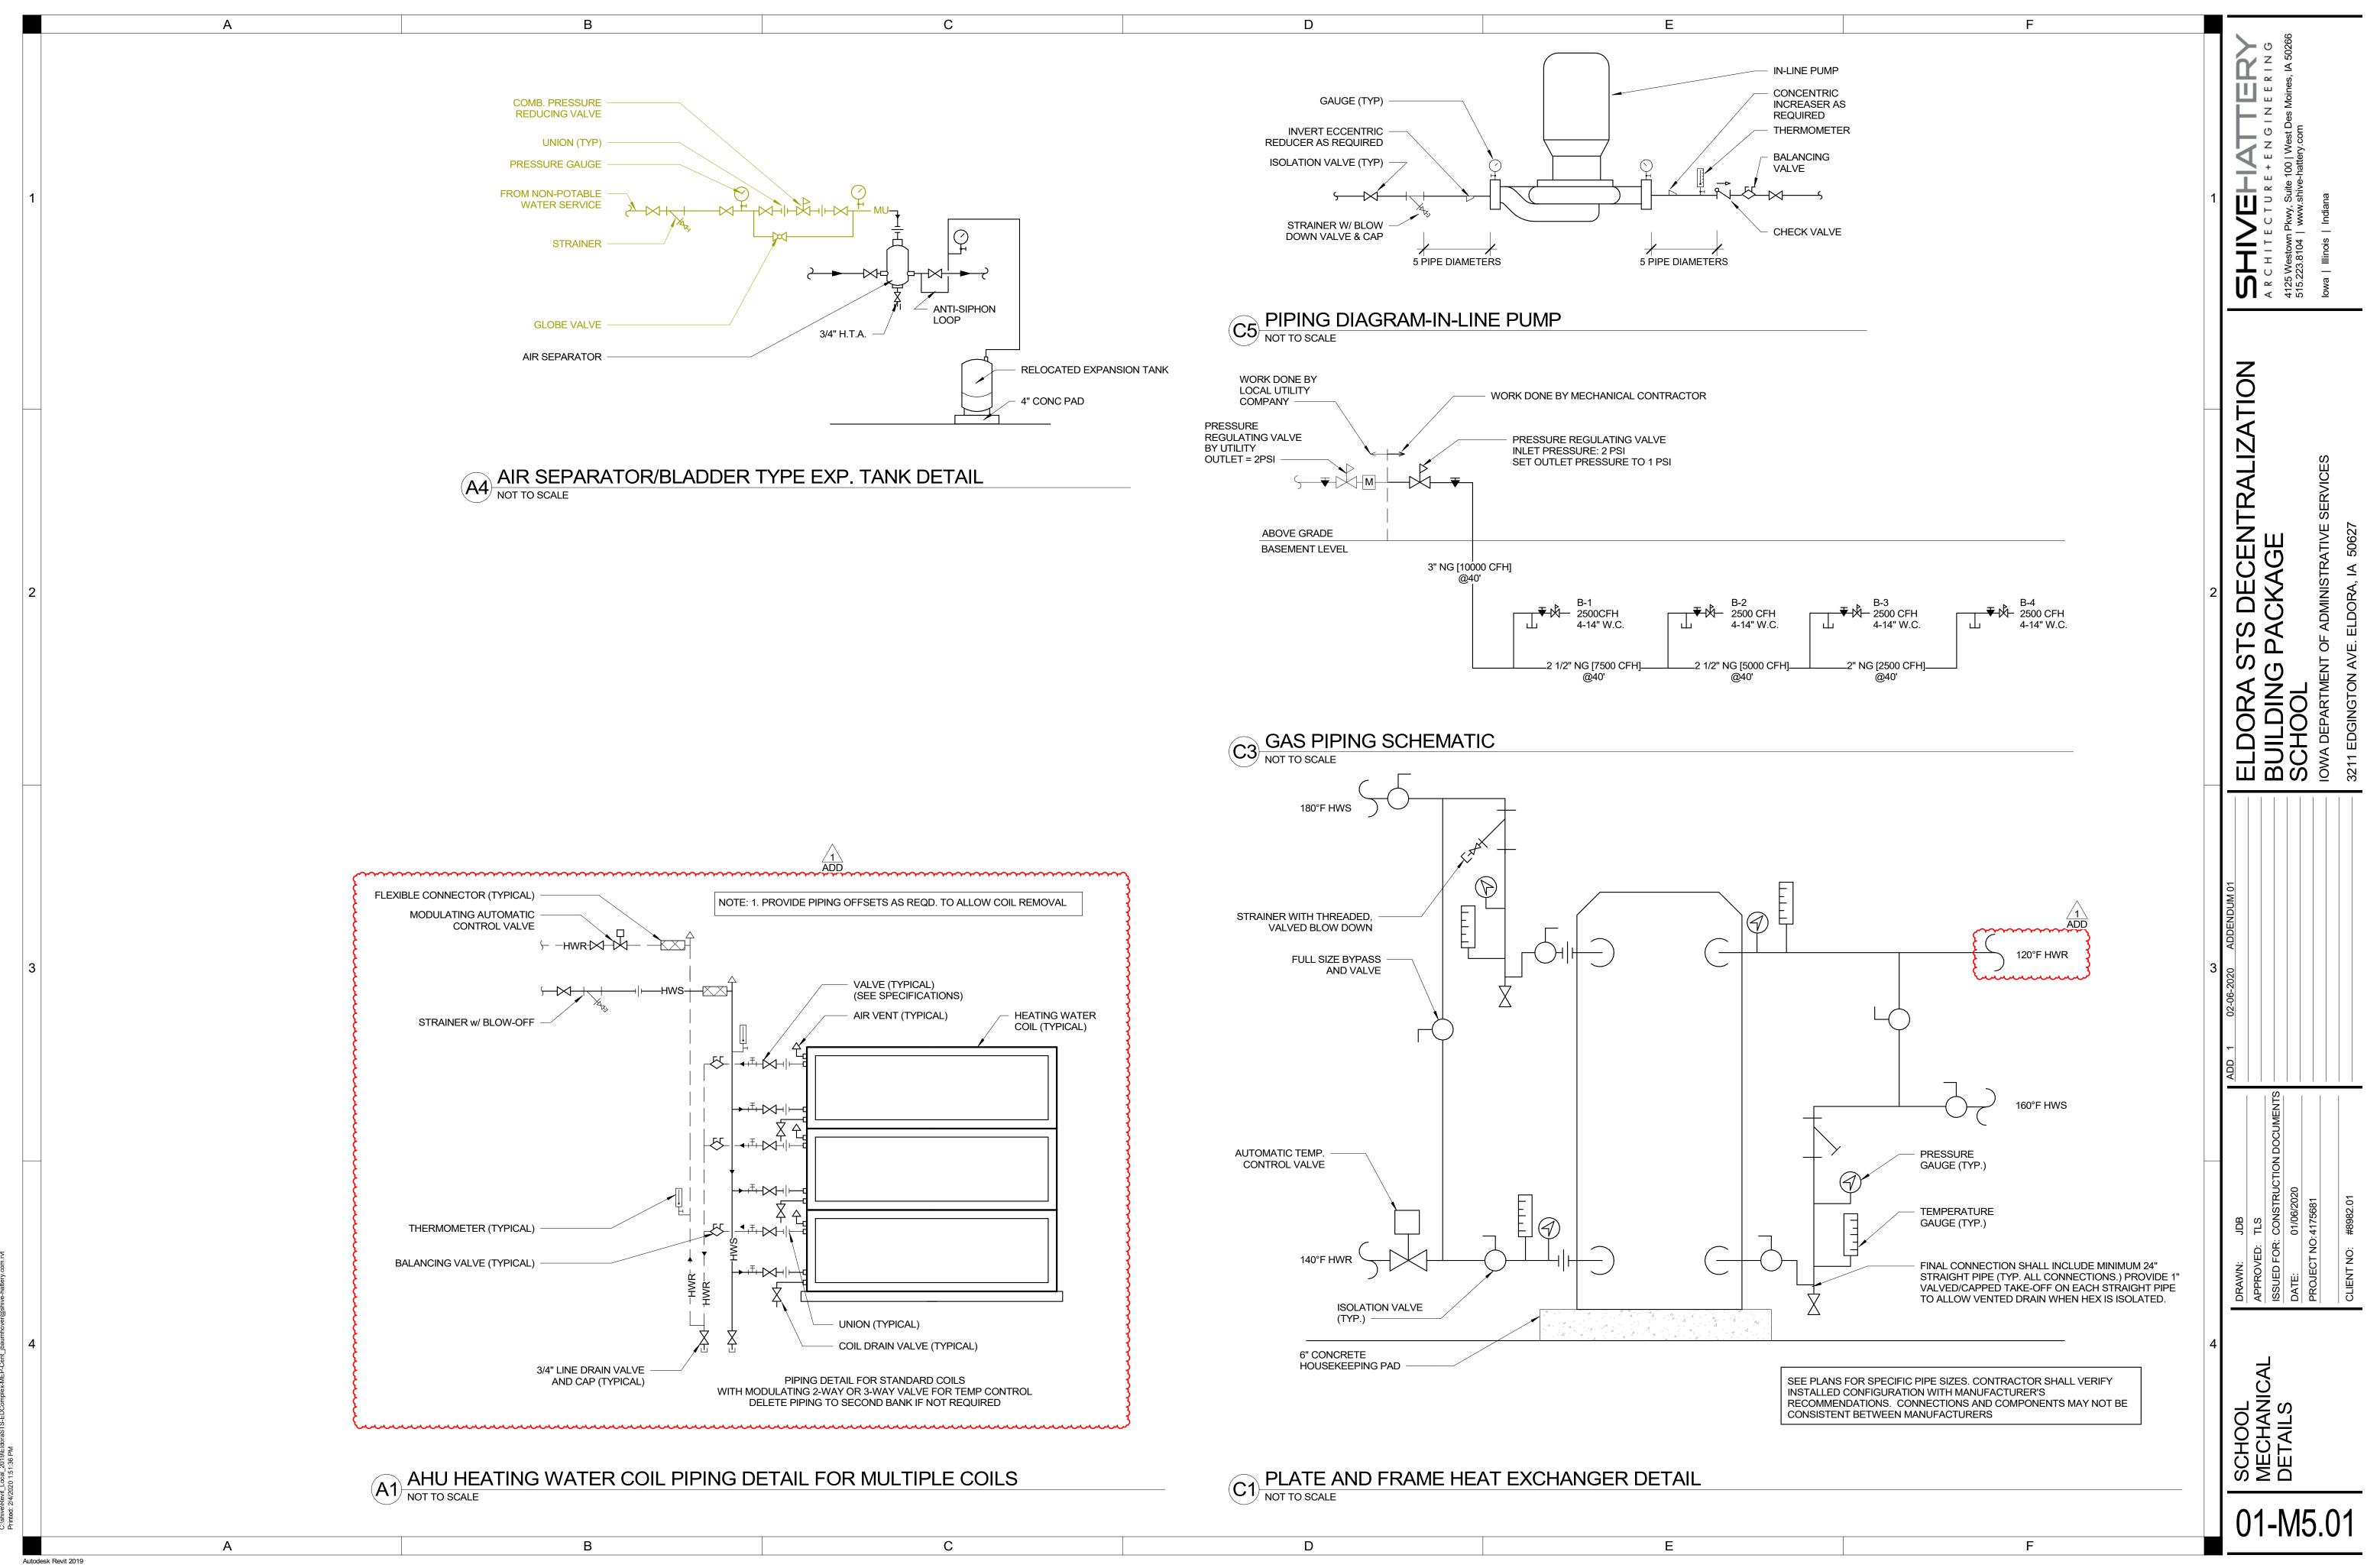

		А	В	
	1			
	2			
-				
	3			
-				
-				
	4			
	4			
	4			MADIZ
56 AM	4			MARK B-1
11:48:56 AM	4			B-1 B-2
'2020 11:48:56 AM	4			B-1 B-2 B-3
cd: 2/5/2020 11:48:56 AM	4			B-1 B-2
Printed: 2/5/2020 11:48:56 AM	4			B-1 B-2 B-3
Printed: 2/5/2020 11:48:56 AM	4	Α	Β	B-1 B-2 B-3

С	D     E     F       EQUIVALENT PRODUCTS BY MANUFACTURERS WHICH ARE NOT LISTED IN SCHEDULES OR IN SPECIFICATIONS MAY BE USED WITH PRE-APPROVAL FROM ENGINEER. SEE SPECIFICATIONS FOR SUBSTITUTION REQUEST INSTRUCTIONS.     SCHEDULES OR INSTRUCTIONS FOR SUBSTITUTION REQUEST INSTRUCTIONS.       FAN SCHEDULE       REMARKS: 1. PROVIDE NEW MOTOR. EXISTING FAN ASSEMBLY TO REMAIN. 2. COOINATE CONNECT WITH ELECTRICAL CONTRACTOR. 3. REBALANCE TO 30,000 CFM FAN AT FULL SPEED.       MARK       MOTOR DATA HP       WOTOR DATA HP	<b>BACHITECTURE+ENGINEERING</b> A R C H I T E C T U R E + E N G I N E E R I N G 4125 Westown Pkwy, Suite 100   West Des Moines, IA 50266 515.223.8104   www.shive-hattery.com lowa   Illinois   Indiana	
NOTES: 1. PROVIDE WI 2. FURNISH AN 3. SYSTEM VO MARK GFS-1	SF-5252083TRANE1.2AIR SEPARATOR SCHEDULEMARKSERVEDSIZE (IN)CAPACITY (GPM)STRAINER (VIN)MAX PD (FT)DESIGN BASISREMARKSAS-1HWS6"700Y3BELL AND GOSSETT R-FFSIZE (IN)CAPACITY (GPM)STRAINER (VIN)MAX PD (FT)DESIGN BASISREMARKSAS-2PPGHWS4"300Y2BELL AND GOSSETT R-FFSIZE (IN)CAPACITY (GPM)YYZBELL AND GOSSETT R-FFGLYCOL FEED SYSTEM SCHEDULETHREE MARED 50% PROPYLENE GLYCOL SOLUTION. NO FIELD MIXING SHALL BE ALLOWED. SEE SPEC.DISTAIL AL PUPP COTTROLS AND WINKIG.WINCE ON WINKIG.SYSTEM SCHEDULEMOTOR DATAVOLTSMOTOR DATANOLTSMOTOR DATASYSTEM SERVEDTYPETANK CAPACITY (GAL)REMARKSSUPER SERVEDTYPETANK CAPACITY (GAL)RELIFE VALVEMARK SYSTEM SERVEDTYPETANK CAPACITY (GAL)RELIFE VALVEMARK SYSTEM SERVEDTYPETANK CAPACITY (GAL)RELIFE VALVEMARK SYSTEM SERVEDTANK CAPACITY (GAL) <td colspan<="" th=""><th>LDORA STS DECENTRALIZATION LDORA STS DECENTRALIZATION JILDING PACKAGE CHOOL A DEPARTMENT OF ADMINISTRATIVE SERVICES 1 EDGINGTON AVE. ELDORA, IA 50627</th></td>	<th>LDORA STS DECENTRALIZATION LDORA STS DECENTRALIZATION JILDING PACKAGE CHOOL A DEPARTMENT OF ADMINISTRATIVE SERVICES 1 EDGINGTON AVE. ELDORA, IA 50627</th>	LDORA STS DECENTRALIZATION LDORA STS DECENTRALIZATION JILDING PACKAGE CHOOL A DEPARTMENT OF ADMINISTRATIVE SERVICES 1 EDGINGTON AVE. ELDORA, IA 50627
	NOTES: 1. VARIABLE FREQUENCY DRIVE AND DISCONNECT TO BE PROVIDED BY ELECTRICAL CONTRACTOR. 2. PERFORMANCE BASED ON 50% PROPYLENE GLYCOL. 3. PUMPS P-1, P-2, & P-3 SELECTED TO OPERATE WITH TWO PUMPS IN PARALLEL AND THE THIRD PUMP IN STAND-BY TO DELIVER A TOTAL OF 530 GPM AT 46 FEET OF HEAD PRESSURE. 4. PUMPS P-4 & P-5 SELECTED TO OPERATE WITH TWO PUMPS IN PARALLEL TO DELIVER A TOTAL OF 215 GPM AT 62 FEET OF HEAD PRESSURE. 1. PUMPS P-4 & P-5 SELECTED TO OPERATE WITH TWO PUMPS IN PARALLEL TO DELIVER A TOTAL OF 215 GPM AT 62 FEET OF HEAD PRESSURE. 1. PUMPS P-4 & P-5 SELECTED TO OPERATE WITH TWO PUMPS IN PARALLEL TO DELIVER A TOTAL OF 215 GPM AT 62 FEET OF HEAD PRESSURE.		
	How Provession       Head (FT)       Shutoff Head (FT)       BHP       HP       VOLTS       PHASE       RPM       DESIGN BASIS       REMARKS         P-1       HWS       END SUCTION       265       46.00       79.40       4.84       7.5       208       3       1800       B&G e1510 2BD       1,3         P-2       HWS       END SUCTION       265       46.00       79.40       4.84       7.5       208       3       1800       B&G e1510 2BD       1,3         P-3       HWS       END SUCTION       265       46.00       79.40       4.84       7.5       208       3       1800       B&G e1510 2BD       1,3         P-3       HWS       END SUCTION       265       46.00       79.40       4.84       7.5       208       3       1800       B&G e1510 2BD       1,3         P-4       MUA HWS       INLINE       110       62.00       68.10       2.2       3       208       3       3600       B&G e-90 2AAC       1,2,4         P-5       MUA HWS       INLINE       110       62.00       68.10       2.2       3       208       3       3600       B&G e-90 2AAC       1,2,4         ADD       ADD       <	2.06-2020 ADDENDUM 01	
	AIR HANDLING UNIT REPLACEMENT HEATING COIL - HOT WATER           NOTES:           1. INSTALLED AS & COIL BANK IN EXISTING AHU-5.           2. PERFORMANCE BASED ON 45% PROPYLENE GLYCOL.		
	MARK         HEATING COIL DATA         AIR TEMPERATURE         VELOCITY         APD (IN)         SIZE (INXIN)         DESIGN BASIS         REMARKS           HC-5A         10000         4         7.33         1084         58.33         10.74         160         119         -10         90         480         0.23         24 X 126         TRANE         1.2           HC-5B         10000         4         7.33         1084         58.33         10.74         160         119         -10         90         480         0.23         24 X 126         TRANE         1.2           HC-5C         10000         4         7.33         1084         58.33         10.74         160         119         -10         90         480         0.23         24 X 126         TRANE         1.2           HC-5C         10000         4         7.33         1084         58.33         10.74         160         119         -10         90         480         0.23         24 X 126         TRANE         1.2           HC-5C         10000         4         7.4         283.4         20.00         1.44         160         130         -10         90         460         0.24         23 X 36	JDB JDB TLS CONSTRUCTION DOCUMENTS 01/06/2020 01/06/2020 :4175681 :4175681 :4175681	
2. PROV	ORMANCE BASED ON 50% PROPYLENE GLYCOL ON COLD SIDE. 'IDE 135 GALLON BUFFER TANK ON THE HOT SIDE HX-2. RK SYSTEM SERVED GPM MAX PD (PSI) EWT (°F) LWT (°F) GPM	DRAWN: JDB APPROVED: TLS ISSUED FOR: CON DATE: 01/00 PROJECT NO: 4175 CLIENT NO: #898	
HX	-2         DOMESTIC HOT WATER         27         6.00         180         108         22         4.00         40         140         33.9         AERCO SPDW23         2           BOILER SCHEDULE - HOT WATER	AICAL JLES	

		E	REMARKS: 1. PROVIDE NE 2. COODINATE	WNS MAY BE USEE S FOR SUBSTITUT	FAN SCHE	ROVAL FROM NSTRUCTION EDULE BLY TO REMANNECT WITH			1	SHIVEHATTERY	A R C H I T E C T U R E + E N G I N E E R I N G 4125 Westown Pkwy, Suite 100   West Des Moines, IA 50266 515.223.8104   www.shive-hattery.com lowa   Illinois   Indiana	
MARK	SYSTEM SERVED S	ize (in)	MARK SF-5 AIR SEPA CAPACITY (GPM)	HP 25 RATOR SCHE STRAINER (Y/N)		PHASE 3 DESIG	DESIGN BASIS TRANE	REMARKS 1,2 REMARKS		ATION		
IALL BE ALLOW	CUT OUT ANGE(PSI) HP 20-60 1/3 MEC VED TYPE TER DIAPHRAGM	MOTOR VO 1 CHANICAL TANK CAP (GAL 68.0	R DATA DITS PHAS 15 1 PIPING EXPAN ACITY ACCEI ) ACCEI CAPAC 3	JL WINGEF	RT GL50 ELECTR		REMARKS DVIDE DUPLEX RE DESIGN BASIS B&G D-120V B&G D-40V	CEPTACLE	2	С S	JILDING PACKAGE HOOL A DEPARTMENT OF ADMINISTRATIVE SERVICES	3211 EDGINGTON AVE. ELDORA, IA 50627
N PARALLEL AN RALLEL TO DELI	MECHANICAL L CONTRACTOR. ID THE THIRD PUMP I IVER A TOTAL OF 215 HUTOFF HEAD (FT) 79.40 79.40 79.40		O DELIVER A TOT	AL OF 530 GPM AT SSURE 1 1 ADD MOTOR DATA VOLTS 208 208 208	PHASE 3 3 3	AD PRESSURE RPM 1800 1800 1800	E. DESIGN BASIS B&G e1510 2BD B&G e1510 2BD B&G e1510 2BD	REMARKS 1,3 1,3 1,3 1,3				3211
62.00 62.00	08.10 68.10 UNIT REPLACEN	2.2 2.2 /IENT HEAT	3 3 ADD		3	3600	B&G e-90 2AAC B&G e-90 2AAC	1,2,4 1,2,4	3			
.33     10.       .33     10.       .33     10.       .33     10.       .00     1.       .00     1.	D (FT) EWT (°F) 0.74 160 0.74 160 000 0.74 160 00000000000000000000000000000000000	LWT (°F) 119 119 119 130 130 AND FRAM	EAT °F LAT ° -10 90 -10 90 -10 90 -10 90 -10 90 -10 90 E SCHEDULE	480 480 480 480 460		SIZE (INXIN) 24 X 126 24 X 126 24 X 126 23 X 36 23 X 36	DESIGN BASIS TRANE TRANE TRANE TRANE UW TRANE UW	REMARKS 1,2 1,2 1,2 2 2		JDB TLS	DR: CONSTRUCTION DOCUMENTS 01/06/2020 NO:4175681	#8982.01
(°F) LWT ) 13i ) 10i	8 215	C MAX PD (P 9.89 4.00	OLD SIDE SI) EWT (°F) 120 40	LWT (°F) 160 140	HEATING SURF (SQ. FT.) 214.7 33.9		ESIGN BASIS SPX APV RCO SPDW23	REMARKS	4	DRAWN: APPROVED:	ESUED FOR: DATE: PROJECT NO:	CLIENT NO:
E - HOT WA	TER											

F

С

	D     E     F       EQUIVALENT PRODUCTS BY MANUFACTURERS WHICH ARE NOT LISTED IN SCHEDULES OR IN SPECIFICATIONS MAY BE USED WITH PRE-APPROVAL FROM ENGINEER. SEE SPECIFICATIONS FOR SUBSTITUTION REQUEST INSTRUCTIONS.     SHEDISTRUCTIONS       FAN SCHEDULE     REMARKS:     1. PROVIDE NEW MOTOR. EXISTING FAN ASSEMBLY TO REMAIN.     2. COODINATE CONNECTION TO VFD AND DISCONDECT WITH ELECTRICAL CONTRACTOR.       3. REBALARCE TO 30,000 CFM FAN AT FULL SPEED.     MOTOR DATA MARK     MOTOR DATA HP     VOLTS     PHASE     DESIGN BASIS     REMARKS	<b>SHAPATTERY</b> <b>A</b> R C H I T E C T U R E + E N G I N E E R I N G 4125 Westown Pkwy, Suite 100   West Des Moines, IA 50266 515.223.8104   www.shive-hattery.com
NOTES: 1. PROVIDE WI 2. FURNISH AN	AIR SEPARATOR SCHEDULE         MARK       SYSTEM       SIZE (IN)       CAPACITY (GPM)       STRAINER (Y/N)       MAX PD (FT)       DESIGN BASIS       REMARKS         AS-1       HWS       6"       700       Y       3       BELL AND GOSSETT R-6F         AS-2       PPG HWS       4"       300       Y       2       BELL AND GOSSETT R-4F         GLYCOL FEED SYSTEM SCHEDULE	ENTRALIZATION GE ATIVE SERVICES
MARK GFS-1	DINSTALL ALL PUMP CONTROLS AND WIRING.         IMME CAPACITY       GPM @       CUT OUT       MOTOR DATA         SYSTEM SERVED       TANK CAPACITY       GPM @       CUT IN RANGE (PSI)       HP       VOLTS       PHASE       DESIGN BASIS       REMARKS         HEATING WATER       50       1.5       10-40       20-60       1/3       115       1       JL WINGERT GL50       ELECTRICAL TO PROVIDE DUPLEX RECEPTACLE         MECHANICAL PIPING EXPANSION TANK SCHEDULE         MARK       SYSTEM SERVED       TYPE       TANK CAPACITY       ACCEPTANCE       RELIEF VALVE         MARK       SYSTEM SERVED       TYPE       TANK CAPACITY       ACCEPTANCE       RELIEF VALVE       DESIGN BASIS       REMARKS         ET-1       HEATING WATER       DIAPHRAGM       68.0       34.0       125.00       12.00       B&G D-120V       EXISTING         ET-2       HEATING WATER       DIAPHRAGM       21.7       11.3       125.00       12.00       B&G D-40V       EXISTING	DORA STS DEC DORA STS DEC IILDING PACKA HOOL N DEPARTMENT OF ADMINISTE EDGINGTON AVE. ELDORA, IA
	NOTES: 1. VARIABLE FREQUENCY DRIVE AND DISCONNECT TO BE PROVIDED BY ELECTRICAL CONTRACTOR. 2. PERFORMANCE BASED ON 50% PROPYLENE GLYCOL. 3. PUMPS P-1, P-2, & P-3 SELECTED TO OPERATE WITH TWO PUMPS IN PARALLEL AND THE THIRD PUMP IN STAND-BY TO DELIVER A TOTAL OF 530. GPM AT 46 FEET OF HEAD PRESSURE. 4. PUMPS P-4 & P-5 SELECTED TO OPERATE WITH TWO PUMPS IN PARALLEL TO DELIVER A TOTAL OF 215 GPM AT 62 FEET OF HEAD PRESSURE. 4. PUMPS P-4 & P-5 SELECTED TO OPERATE WITH TWO PUMPS IN PARALLEL TO DELIVER A TOTAL OF 215 GPM AT 62 FEET OF HEAD PRESSURE. 4. PUMPS P-4 & P-5 SELECTED TO OPERATE WITH TWO PUMPS IN PARALLEL TO DELIVER A TOTAL OF 215 GPM AT 62 FEET OF HEAD PRESSURE. 4. PUMPS P-4 & P-5 SELECTED TO OPERATE WITH TWO PUMPS IN PARALLEL TO DELIVER A TOTAL OF 215 GPM AT 62 FEET OF HEAD PRESSURE. 4. PUMPS P-4 & P-5 SELECTED TO OPERATE WITH TWO PUMPS IN PARALLEL TO DELIVER A TOTAL OF 215 GPM AT 62 FEET OF HEAD PRESSURE. SYSTEM SERVED         TYPE         GPM         HEAD (FT)         SHUTOFF HEAD (FT)         BHP         HP         VOLTS         PHASE         RPM         DESIGN BASIS         REMARKS           P-1         HWS         END SUCTION         265         46.00         79.40         4.84         7.5         208         3         1800         B&G e1510 2BD         1,3           P-2         HWS         END SUCTION         265         46.00         79.40         4.84         7.5         208         3         1800         B&G e1510 2BD         1,3           P-3         HWS         END SUCTION         265         46.00         79.40         4.84         7.5         208         3         1800         B&G e1510 2BD         1,3           P-3         HWS         END SUCTION         265         46.00         79.40         4.84         7.5         208         3         1800         B&G e1510 2BD         1,3           P-4         MUA HWS         INLINE         110         62.00         68.10         2.2         3         208         3         3600         B&G e-90 2AAC         1,2,4           P-5         MUA HWS         INLINE         110         62.00         6	2020 ADDENDUM 01
	AIR HANDLING UNIT REPLACEMENT HEATING COIL - HOT WATER	<b>3</b> 03-06-2020
	NOTES: 1. INSTALLED AS A COIL BANK IN EXISTING AHU-5 2. PERFORMANCE BASED ON 45% PROPYLENE GLYCOL.	ADD 1
ADD	MARK         HEATING CEM         MBH         GPM         WPD (FT)         EWT (°F)         LWT (°F)         EAT °F         VELOCITY (FPM)         APD (IN)         SIZE (INXIN)         DESIGN BASIS         REMARKS           HC-5A         10000         4         7.33         1084         58.33         10.74         160         119         -10         90         480         0.23         24 X 126         TRANE         1,2           HC-5B         10000         4         7.33         1084         58.33         10.74         160         119         -10         90         480         0.23         24 X 126         TRANE         1,2           HC-5C         10000         4         7.33         1084         58.33         10.74         160         119         -10         90         480         0.23         24 X 126         TRANE         1,2           HC-5C         10000         4         7.33         1084         58.33         10.74         160         119         -10         90         480         0.23         24 X 126         TRANE         1,2           HC-6         2700         4         7.4         283.4         20.00         1.44         160         130	RUCTION DOCUMENTS
	ORMANCE BASED ON 50% PROPYLENE GLYCOL ON COLD SIDE. /IDE 135 GALLON BUFFER TANK ON THE HOT SIDE HX-2.	NO:
ADD HX	-1 MAKEUP AIR HEATING 190 6.84 180 180 138 215 9.89 120 120 160 214.7 SPX APV 1 1 1	APPROV ISSUED DATE: PROJEC
	BOILER SCHEDULE - HOT WATER	

			IN SPE SPECI REM 1. PF 2. CO 3. RE	ARKS: ROVIDE NEW MOTOR. EX DODINATE CONNECTION BALANCE TO 30,000 CF	JSED WITH PRE-A ITUTION REQUES FAN SC STAN SC	PPROVAL FROM T INSTRUCTION HEDULE EMBLY TO REMA CONNECT WITH PEED.	M ENGINEER. SEE		1	<b>SHAPATTERY</b> A R C H I T E C T U R E + E N G I N E E R I N G 4125 Westown Pkwy, Suite 100   West Des Moines, IA 50266 515.223.8104   www.shive-hattery.com
	MARK AS-1 AS-2	SYSTEM SERVED SIZ HWS PPG HWS	A ZE (IN) CAPACIT 6" 70 4" 30	0 Y		BELL AND	TRANE GN BASIS GOSSETT R-6F GOSSETT R-4F	1,2 REMARKS		RALIZATION
IO FIELD MIXING SHA	ALL BE ALLOWE	JT OUT NGE(PSI) HP 20-60 1/3 MEC	MOTOR DATA VOLTS 115	1 JL WIN			REMARKS OVIDE DUPLEX RE	CEPTACLE	2	ELDORA STS DECENTRALI BUILDING PACKAGE SCHOOL IOWA DEPARTMENT OF ADMINISTRATIVE SERVICES
ET-2		ER DIAPHRAGM	68.0 21.7 PUMP SCHEDUL		125.00 125.00	HEAD PRESSUR	B&G D-120V B&G D-40V	EXISTING		
GPM HE 265 265 265 110 110	EAD (FT) SHU 46.00 46.00 46.00 62.00 62.00	UTOFF HEAD (FT) 79.40 79.40 68.10 68.10	BHP 4.84 4.84 2.2 2.2 2.2 1 ADD	TERA TOTAL OF 530 GPNTEAD PRESSURE1ADDMOTOR DATAHPVOLTS7.52087.5208320832083208OIL - HOT WATER	PHASE         3         3         3         3         3         3         3         3	RPM 1800 1800 1800 3600 3600	DESIGN BASIS B&G e1510 2BD B&G e1510 2BD B&G e1510 2BD B&G e-90 2AAC B&G e-90 2AAC	REMARKS         1,3         1,3         1,3         1,2,4         1,2,4	3	ADD 1 02-06-2020 ADDENDUM 01
MBH GPI	33         10.7           33         10.7           33         10.7           33         10.7           30         10.7	'4     160       '4     160       '4     160       '4     160       4     160	AIR TEN           LWT (°F)         EAT °F           119         -10           119         -10           119         -10           130         -10           130         -10	MPERATURE         VELOC           LAT °F         (FPI           90         480           90         480           90         480           90         480           90         480           90         480           90         480           90         480           90         480           90         480           90         460           90         460	M) APD (IN) 0 0.23 0 0.23 0 0.23 0 0.23 0 0.24	SIZE (INXIN) 24 X 126 24 X 126 24 X 126 23 X 36 23 X 36 23 X 36	DESIGN BASIS TRANE TRANE TRANE TRANE UW TRANE UW	REMARKS 1,2 1,2 1,2 2 2		20 20
1084     58.3       1084     58.3       1084     58.3       1084     58.3       283.4     20.0       283.4     20.0			AND FRAME SCH							JDB TLS CONSTRU 01/06/2020 4175681 #8982.01

D	E		F	I N E R I N G es Moines, IA 50266
	IN S	JIVALENT PRODUCTS BY MANUFACTURERS PECIFICATIONS MAY BE USED WITH PRE-AP ECIFICATIONS FOR SUBSTITUTION REQUEST	PROVAL FROM ENGINEER. SEE	uite 100
	1. 2.	FAN SCH EMARKS: PROVIDE NEW MOTOR. EXISTING FAN ASSEM COODINATE CONNECTION TO VFD AND DISC REBALANCE TO 30,000 CFM FAN AT FULL SPI MOTOR DATA MARK HP VOLTS	MBLY TO REMAIN. ONNECT WITH ELECTRICAL CONTRA EED.	A L L C T H I T E C T lestown Pkwy, 3.8104   www.
	SYSTEM	SF-5 25 208 AIR SEPARATOR SCHEDULE	3 TRANE	
	AS-1 HWS 6"	CITY (GPM)         STRAINER (Y/N)         MAX PD (FT           700         Y         3           300         Y         2	DESIGN BASIS     RE       BELL AND GOSSETT R-6F     BELL AND GOSSETT R-4F	
	GLYCOL FEED SYSTEM SCHEDULE			SERVICES
I PRE-MIXED 50% PROPYLENE GLYCOL SOLUTION. NO FIELD MIXING S INSTALL ALL PUMP CONTROLS AND WIRING. ME APPROXIMATELY 150 GALLONS. TANK CAPACITY GPM @ SYSTEM SERVED (GAL) 100 PSI CUT IN RAN HEATING WATER 50 1.5 10-4	CUT OUT NGE (PSI) RANGE(PSI) HP VOLTS	PHASE DESIGN BASIS	REMARKS TRICAL TO PROVIDE DUPLEX RECEF	
	MECHANICAL PIPI	NG EXPANSION TANK SCHEDULE		≶ <u>ב</u> ת (י)
MARK ET-1 ET-2	SYSTEM SERVEDTYPETANK CAPACITY (GAL)HEATING WATERDIAPHRAGM68.0HEATING WATERDIAPHRAGM21.7	ACCEPTANCERELIEF VA CAPACITY (GAL)34.0125.0011.3125.00	FILL AT (PSI) DESIGN BASIS RE	
NOTES: 1. VARIABLE FREQUENCY DRIVE AND DISCONNECT TO BE PROVIDED 2. PERFORMANCE BASED ON 50% PROPYLENE GLYCOL. 3. PUMPS P-1, P-2, & P-3 SELECTED TO OPERATE WITH TWO PUMPS 4. PUMPS P-4 & P-5 SELECTED TO OPERATE WITH TWO PUMPS IN PA		LIVER A TOTAL OF 530 GPM AT 46 FEET OF HE	EAD PRESSURE.	
P-1HWSEND SUCTION265P-2HWSEND SUCTION265P-3HWSEND SUCTION265	HEAD (FT)         SHUTOFF HEAD (FT)         BHP           46.00         79.40         4.84           46.00         79.40         4.84           46.00         79.40         4.84	ADD           MOTOR DATA           HP         VOLTS         PHASE           7.5         208         3           7.5         208         3           7.5         208         3           7.5         208         3	1800         B&G e1510 2BD           1800         B&G e1510 2BD           1800         B&G e1510 2BD           1800         B&G e1510 2BD	REMARKS         1,3           1,3         1,3           1,3         1,3           1,3         1,2
P-4MUA HWSINLINE110P-5MUA HWSINLINE110		3         208         3           3         208         3	3600         B&G e-90 2AAC           3600         B&G e-90 2AAC	1.2.4
				3 02-06-2020
NOTES:				
	NG COIL DATA AIR T	EMPERATURE		
	EPM WPD (FT) EWT (°F) LWT (°F) EAT 8.33 10.74 160 119 -10		SIZE (INXIN) DESIGN BASIS RE 24 X 126 TRANE	EMARKS 1,2 1,2 1,2 1,2 1,2 1,2 1,2
HC-5B1000047.3310845HC-5C1000047.3310845	8.3310.74160119-108.3310.74160119-10	90         480         0.23           90         480         0.23	24 X 126         TRANE           24 X 126         TRANE	
	0.00 1.44 160 130 -10 0.00 1.44 160 130 -10		23 X 36 TRANE UW 23 X 36 TRANE UW	
RMANCE BASED ON 50% PROPYLENE GLYCOL ON COLD SIDE. E 135 GALLON BUFFER TANK ON THE HOT SIDE HX-2.	HEAT EXCHANGER - PLATE AND FRAME SC	CHEDULE		DRAWN:     JDB     2       DRAWN:     JDB       APPROVED:     TLS       APPROVED:     TLS       ISSUED FOR:     01/06/2020       PROJECT NO:     175681       PROJECT NO:     #8982.01
KSYSTEM SERVEDGPMMAX PD (PSI)EWTMAKEUP AIR HEATING1906.8418DOMESTIC HOT WATER276.0018	30 138 215 9.89	SIDE         HEATING SUF           EWT (°F)         LWT (°F)         (SQ. FT           120         160         214.7           40         140         33.9		The second secon
BOILER SCHEDU	LE - HOT WATER			


D E F	G I N E E R I N G st Des Moines, IA 50266
EQUIVALENT PRODUCTS BY MANUFACTURERS WHICH ARE NOT LISTED IN SCHEDULES OR IN SPECIFICATIONS MAY BE USED WITH PRE-APPROVAL FROM ENGINEER. SEE SPECIFICATIONS FOR SUBSTITUTION REQUEST INSTRUCTIONS.	L L R E + E N Suite 100   Wes shive-hattery.co
FAN SCHEDULEREMARKS: 1. PROVIDE NEW MOTOR. EXISITING FAN ASSEMBLY TO REMAIN. 2. COODINATE CONNECTION TO VFD AND DISCONNECT WITH ELECTRICAL CONTRACTOR. 3. REBALANCE TO 30,000 CFM FAN AT FULL SPEED.MOTOR DATA MARKMOTOR DATA HPVOLTSPHASE DESIGN BASIS REMARKSSF-5252083TRANE1,2	A R C H I T E C T L A R C H I T E C T L 4125 Westown Pkwy, S 515.223.8104   www.s lowa   Illinois   Indian
AIR SEPARATOR SCHEDULEMARKSYSTEM SERVEDSIZE (IN)CAPACITY (GPM)STRAINER (Y/N)MAX PD (FT)DESIGN BASISREMARKSAS-1HWS6"700Y3BELL AND GOSSETT R-6FAS-2PPG HWS4"300Y2BELL AND GOSSETT R-4F	LIZATION
GLYCOL FEED SYSTEM SCHEDULE	<b>FRALI</b> SERVICES
E WITH PRE-MIXED 50% PROPYLENE GLYCOL SOLUTION. NO FIELD MIXING SHALL BE ALLOWED. SEE SPEC. HAND INSTALL, ALL PUMP CONTROLS AND WIRING. AVOLUME APPROXIMATELY 150 GALLONS AVOLUME APPROXIMATELY 150 GALLONS AVOLUM	DECEN STS DECEN B PACKAGE VT OF ADMINISTRATIVE AVE. ELDORA, IA 50627
MECHANICAL PIPING EXPANSION TANK SCHEDULEMARKSYSTEM SERVEDTYPETANK CAPACITY (GAL)ACCEPTANCE CAPACITY (GAL)RELIEF VALVE RELIEF AT (PSI)Ising wasis Fill AT (PSI)RemarksET-1HEATING WATERDIAPHRAGM68.034.0125.0012.00B&G D-120VEXISTINGET-2HEATING WATERDIAPHRAGM21.711.3125.0012.00B&G D-40VT	LDORA UILDINO CHOOL MA DEPARTMEI
NOTES: 1. VARIABLE FREQUENCY DRIVE AND DISCONNECT TO BE PROVIDED BY ELECTRICAL CONTRACTOR. 2. PERFORMANCE BASED ON 50% PROPYLENE GLYCOL. 3. PUMPS P-1, P-2, & P-3 SELECTED TO OPERATE WITH TWO PUMPS IN PARALLEL AND THE THIRD PUMP IN STAND-BY TO DELIVER A TOTAL OF 530 GPM AT 46 FEET OF HEAD PRESSURE. 4. PUMPS P-4 & P-5 SELECTED TO OPERATE WITH TWO PUMPS IN PARALLEL TO DELIVER A TOTAL OF 215 GPM AT 62 FEET OF HEAD PRESSURE.	<u>— Ш Ф Ф ё ў</u>
MARK         SYSTEM SERVED         TYPE         GPM         HEAD (FT)         SHUTOFF HEAD (FT)         BHP         HP         VOLTS         PHASE         RPM         DESIGN BASIS         REMARKS           P-1         HWS         END SUCTION         265         46.00         79.40         4.84         7.5         208         3         1800         B&G e1510 2BD         1,3           P-2         HWS         END SUCTION         265         46.00         79.40         4.84         7.5         208         3         1800         B&G e1510 2BD         1,3           P-3         HWS         END SUCTION         265         46.00         79.40         4.84         7.5         208         3         1800         B&G e1510 2BD         1,3           P-3         HWS         END SUCTION         265         46.00         79.40         4.84         7.5         208         3         1800         B&G e1510 2BD         1,3           P-4         MUA HWS         INLINE         110         62.00         68.10         2.2         3         208         3         3600         B&G e-90 2AAC         1,2,4           P-5         MUA HWS         INLINE         110         62.00         6	2020 ADDENDUM 01
AIR HANDLING UNIT REPLACEMENT HEATING COIL - HOT WATER	02-06-2020
NOTES: 1. INSTAILED AS A COIL BANK IN EXISTING AHU-5 ADD 2. PERFORMANCE BASED ON 45% PROPYLENE GLYCOL. HEATING COIL DATA AIR TEMPERATURE	ADD 1
MARK         HEATING CFM         ROWS         FINS PER INCH         MBH         GPM         WPD (FT)         EWT (°F)         LWT (°F)         EAT °F         LAT °F         VELOCITY (FPM)         APD (IN)         SIZE (INXIN)         DESIGN BASIS         REMARKS           ADD         HC-5A         10000         4         7.33         1084         58.33         10.74         160         119         -10         90         480         0.23         24 X 126         TRANE         1,2           HC-5B         10000         4         7.33         1084         58.33         10.74         160         119         -10         90         480         0.23         24 X 126         TRANE         1,2           HC-5C         10000         4         7.33         1084         58.33         10.74         160         119         -10         90         480         0.23         24 X 126         TRANE         1,2           HC-5C         100000         4         7.4         283.4         20.00         1.44         160         130         -10         90         480         0.24         23 X 36         TRANE         1,2           HC-6         2700         4         7.4         283.4	UCTION DOCUMENTS
HEAT EXCHANGER - PLATE AND FRAME SCHEDULE MARKS: PERFORMANCE BASED ON 50% PROPYLENE GLYCOL ON COLD SIDE. PROVIDE 135 GALLON BUFFER TANK ON THE HOT SIDE HX-2.	N: JDB VED: TLS D FOR: CONSTRI 01/06/202 ECT NO: 4175681 F NO: #8982.01
MARKSYSTEM SERVEDGPMMAX PD (PSI)EWT (°F)LWT (°F)GPMMAX PD (PSI)EWT (°F)LWT (°F)LWT (°F)DESIGN BASISREMARKSHX-1MAKEUP AIR HEATING1906.841801382159.89120160214.7SPX APV1HX-2DOMESTIC HOT WATER276.00180108224.004014033.9AERCO SPDW232	APPRO DRAW ISSUEI PROJE
BOILER SCHEDULE - HOT WATER	


Е


D     E     F       Equivalent products by manufacturers which are not listed in schedules in specifications may be used with pre-approval from engineer, see specifications for substitution request instructions.     FAN SCHEDULE       REMARKS:	Indiana Indian
AIR SEPARATOR SCHEDULE         MARK       SYSTEM SERVED       SIZE (IN)       CAPACITY (GPM)       STRAINER (Y/N)       MAX PD (FT)       DESIGN BASIS       REMAR         AS-1       HWS       6"       700       Y       3       BELL AND GOSSETT R-6F         AS-2       PPG HWS       4"       300       Y       2       BELL AND GOSSETT R-4F	SALIZ/
GLYCOL FEED SYSTEM SCHEDULE         NOTES:         1. PROVIDE WITH PRE-MIXED 50% PROPYLENE GLYCOL SOLUTION. NO FIELD MIXING SHALL BE ALLOWED. SEE SPEC.	S S S S S S S S S S S S S S S S S S S
2. FURNISH AND INSTALL ALL PUMP CONTROLS AND WIRING. 3. SYSTEM VOLUME APPROXIMATELY 150 GALLONS MARK SYSTEM SERVED GALO (GAL) 100 PSI CUT IN RANGE (PSI) RANGE(PSI) HP VOLTS PHASE DESIGN BASIS REMARKS GFS-1 HEATING WATER 50 1.5 10-40 20-60 1/3 115 1 JL WINGERT GL50 ELECTRICAL TO PROVIDE DUPLEX RECEPTAD MECHANICAL PIPING EXPANSION TANK SCHEDULE	
MARK       SYSTEM SERVED       TYPE       TANK CAPACITY (GAL)       ACCEPTANCE CAPACITY (GAL)       RELIEF VALVE       ACCEPTANCE         ET-1       HEATING WATER       DIAPHRAGM       68.0       34.0       125.00       12.00       B&G D-120V       EXIST	
ET-2         HEATING WATER         DIAPHRAGM         21.7         11.3         125.00         12.00         B&G D-40V	
NOTES: 1. VARIABLE FREQUENCY DRIVE AND DISCONNECT TO BE PROVIDED BY ELECTRICAL CONTRACTOR. 2. PERFORMANCE BASED ON 50% PROPYLENE GLYCOL. 3. PUMPS P-1, P-2, & P-3 SELECTED TO OPERATE WITH TWO PUMPS IN PARALLEL AND THE THIRD PUMP IN STAND-BY TO DELIVER A TOTAL OF 530 GPM AT 46 FEET OF HEAD PRESSURE. 4. PUMPS P-4 & P-5 SELECTED TO OPERATE WITH TWO PUMPS IN PARALLEL TO DELIVER A TOTAL OF 215 GPM AT 62 FEET OF HEAD PRESSURE.	
ADD MOTOR DATA	
P-1         HWS         END SUCTION         265         46.00         79.40         4.84         7.5         208         3         1800         B&G e1510 2BD         1           P-2         HWS         END SUCTION         265         46.00         79.40         4.84         7.5         208         3         1800         B&G e1510 2BD         1           P-3         HWS         END SUCTION         265         46.00         79.40         4.84         7.5         208         3         1800         B&G e1510 2BD         1	1,3     0       1,3     0       1,3     0       1,3     0
	24
AIR HANDLING UNIT REPLACEMENT HEATING COIL - HOT WATER	
NOTES: 1. INSTAILLED AS A COIL BANK IN EXISTING AHU-5 ADD 2. PERFORMANCE BASED ON 45% PROPYLENE GLYCOL.	ADD 1
HEATING COIL DATA         AIR TEMPERATURE           FINS PER         VELOCITY	
MARK         HEATING CFM         ROWS         INCH         MBH         CPM         WPD (FT)         EWT (°F)         LWT (°F)         EAT °F         LAT °F         (FPM)         APD (IN)         SIZE (INXIN)         DESIGN BASIS         REMA           ADD         HC-5A         10000         4         7.33         1084         58.33         10.74         160         119         -10         90         480         0.23         24 X 126         TRANE         1,2           HC-5B         10000         4         7.33         1084         58.33         10.74         160         119         -10         90         480         0.23         24 X 126         TRANE         1,2           HC-5C         10000         4         7.33         1084         58.33         10.74         160         119         -10         90         480         0.23         24 X 126         TRANE         1,2           HC-5C         10000         4         7.33         1084         58.33         10.74         160         119         -10         90         480         0.23         24 X 126         TRANE         1,2	
HEAT EXCHANGER - PLATE AND FRAME SCHEDULE REMARKS: 1. PERFORMANCE BASED ON 50% PROPYLENE GLYCOL ON COLD SIDE. 2. PROVIDE 135 GALLON BUFFER TANK ON THE HOT SIDE HX-2.	DRAWN: JDB APPROVED: TLS APPROVED: TLS ISSUED FOR: CONSTRUCTION DATE: 01/06/2020 DATE: 01/06/2020 PROJECT NO:4175681 CLIENT NO: #8982.01
MARK         SYSTEM SERVED         GPM         MAX PD (PSI)         EWT (°F)         LWT (°F)         GPM         MAX PD (PSI)         EWT (°F)         LWT (°F)	RKS
	4 √S
BOILER SCHEDULE - HOT WATER	


### BOILER SCHEDULE - HOT WATER


DOILER SCHEDULE - HOT WATER																	
		MIN GAS									ELECTRICAL DATA						
	OUTPUT	PRESSURE							INLET FUEL	TURNDOWN							
INPUT (MBH)	(MBH)	REQUIRED(IN)	EFFICIENCY	EWT (°F)	LWT (°F)	GPM	MAX PD (FT)	FUEL TYPE	PRESSURE	RATIO	VOLTS	PHASE	FLA	MCA	MOCP	DESIGN BASIS	REMARKS
2500	2175	4	87	160	180	350	7.00	NATURAL GAS	4.00	1:15	208	3	10	13	20	AERCO BMK 2500	
2500	2175	4	87	160	180	350	7.00	NATURAL GAS	4.00	1:15	208	3	10	13	20	AERCO BMK 2500	
2500	2175	4	87	160	180	350	7.00	NATURAL GAS	4.00	1:15	208	3	10	13	20	AERCO BMK 2500	
2500	2175	4	87	160	180	350	7.00	NATURAL GAS	4.00	1:15	208	3	10	13	20	AERCO BMK 2500	

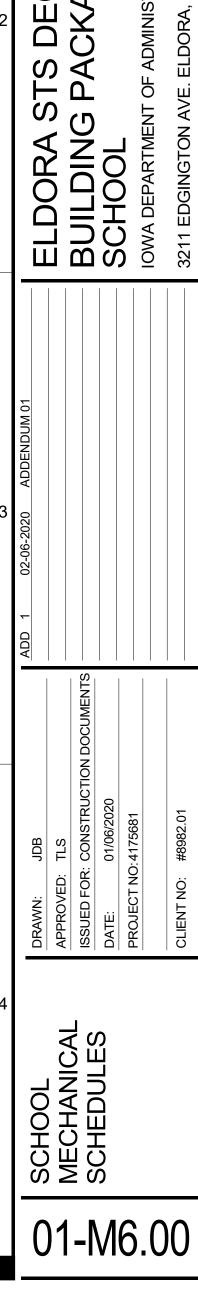

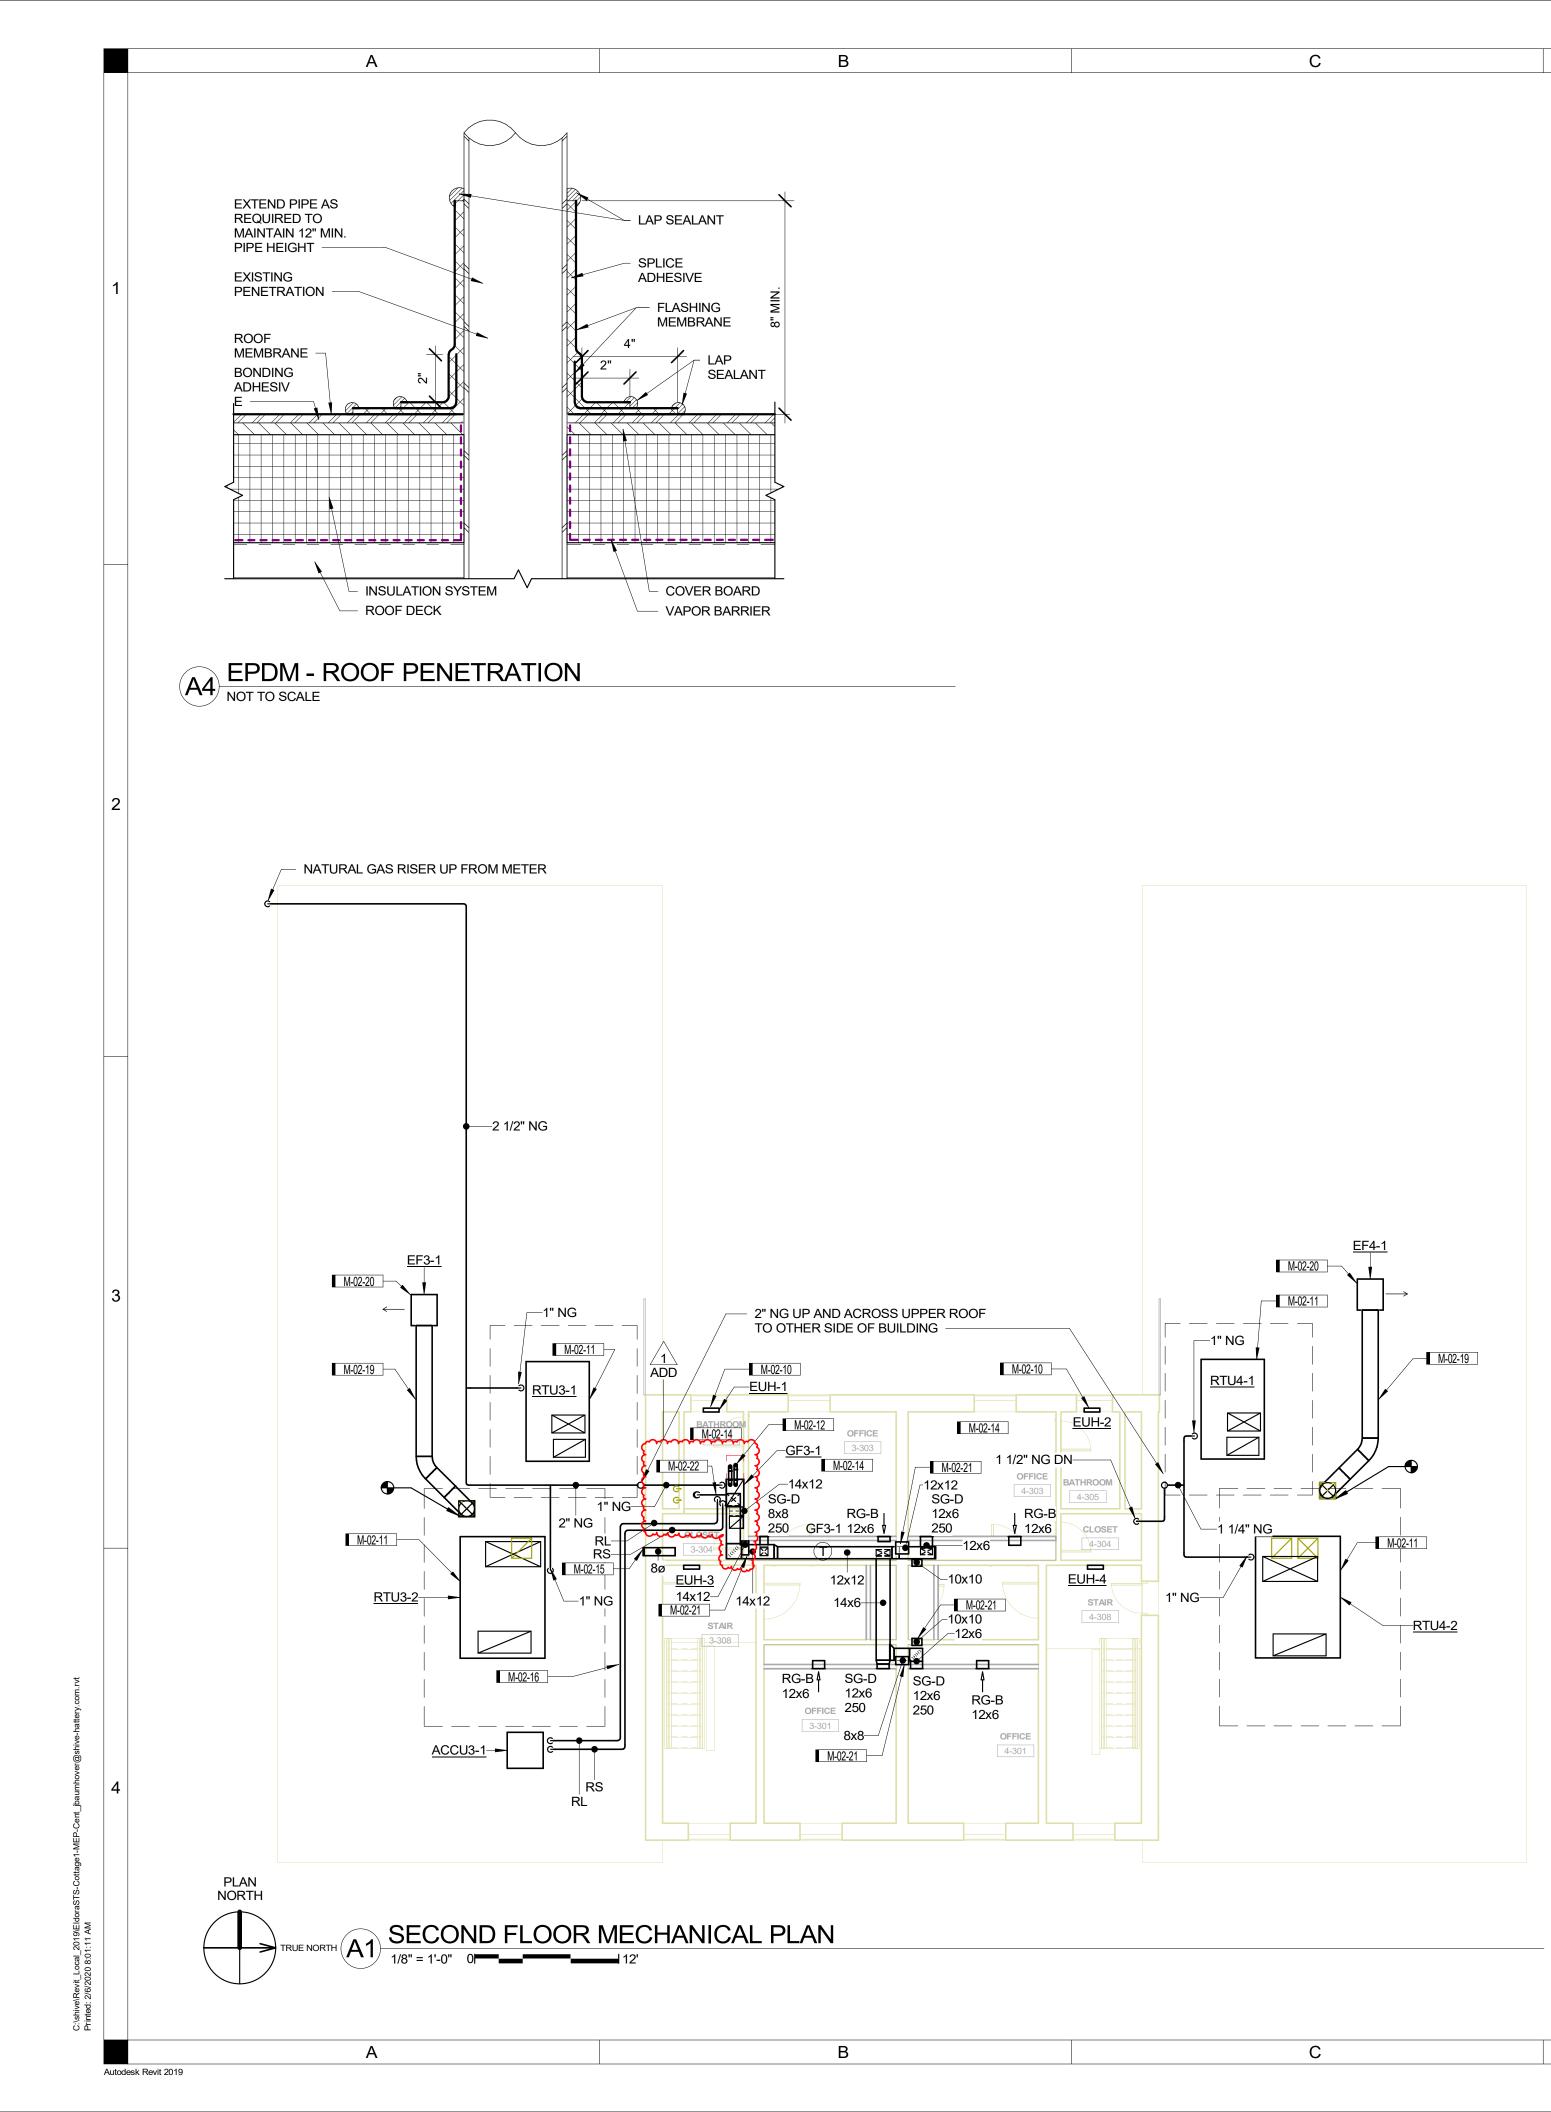


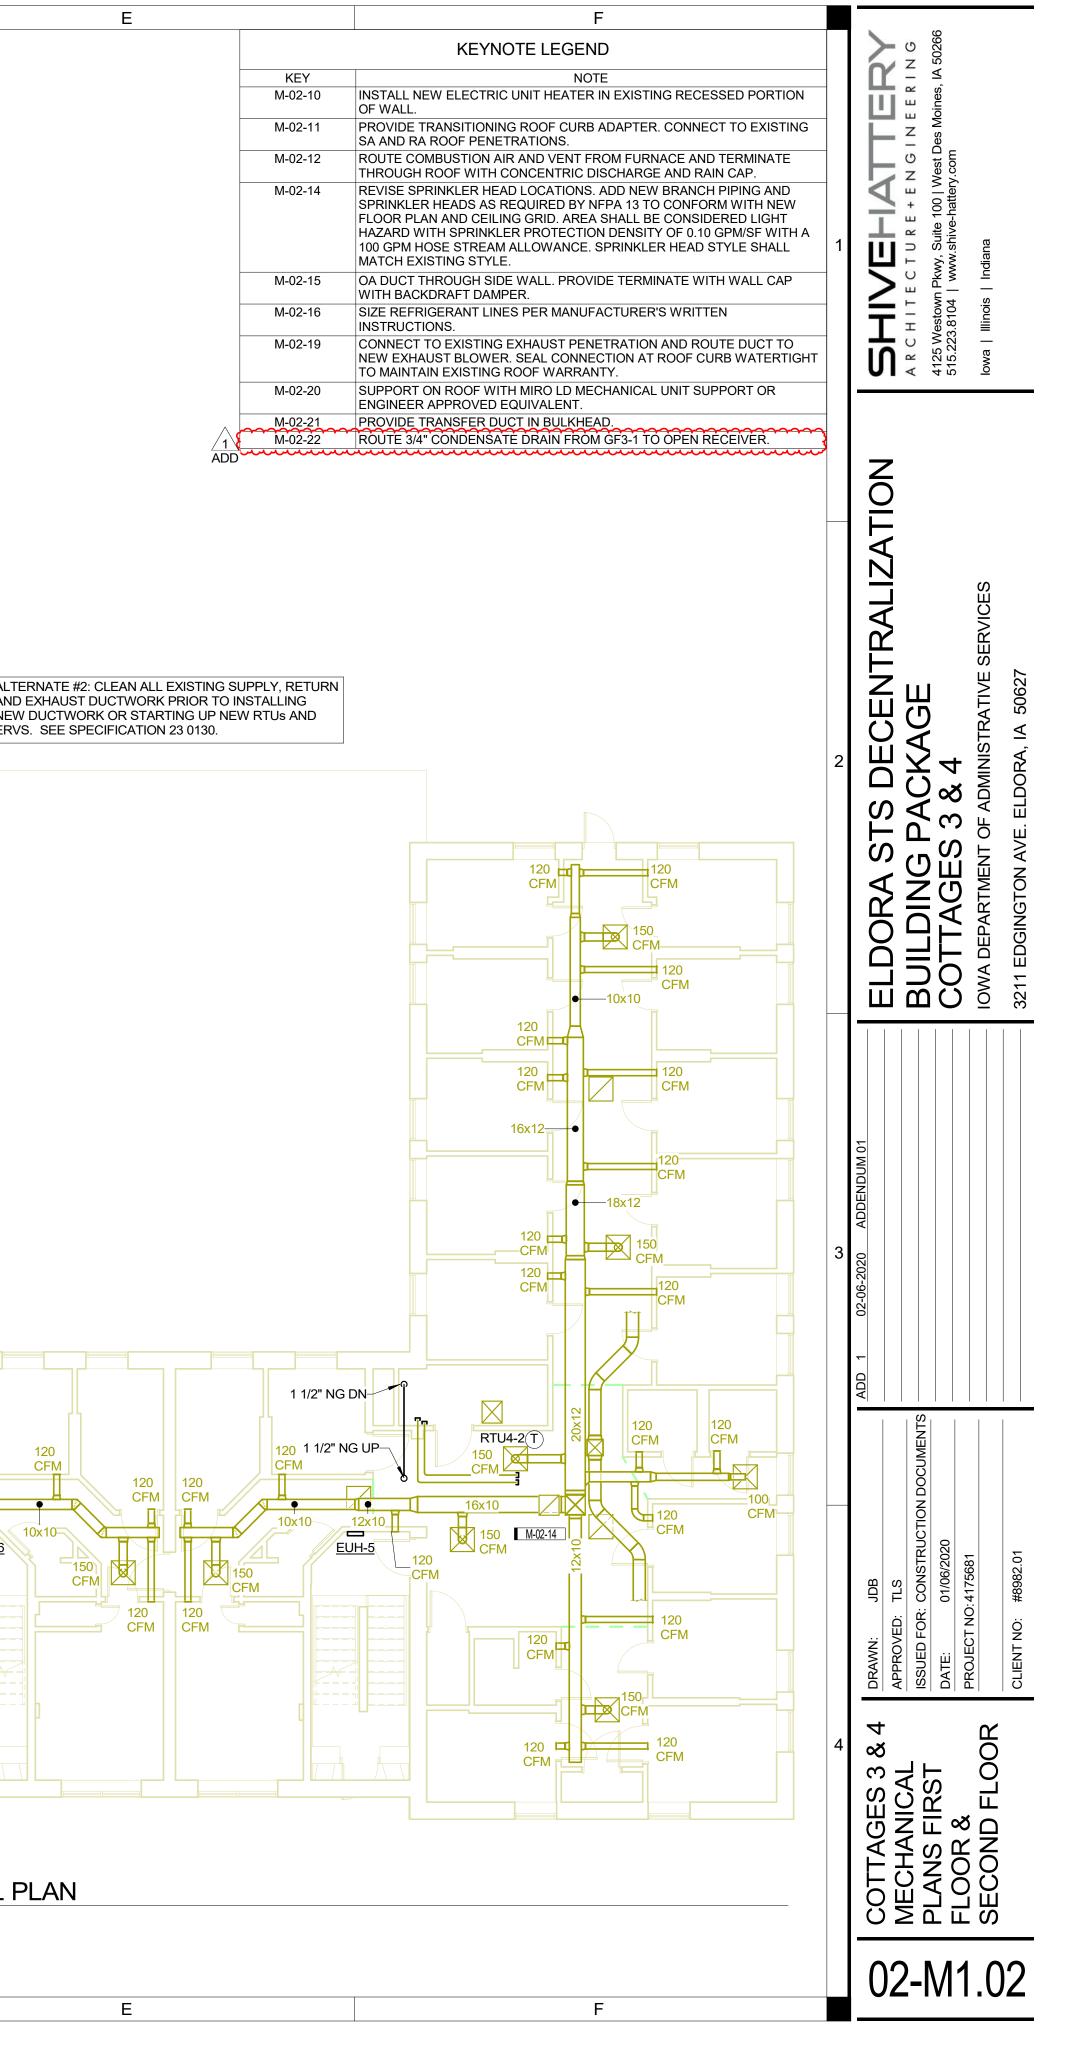

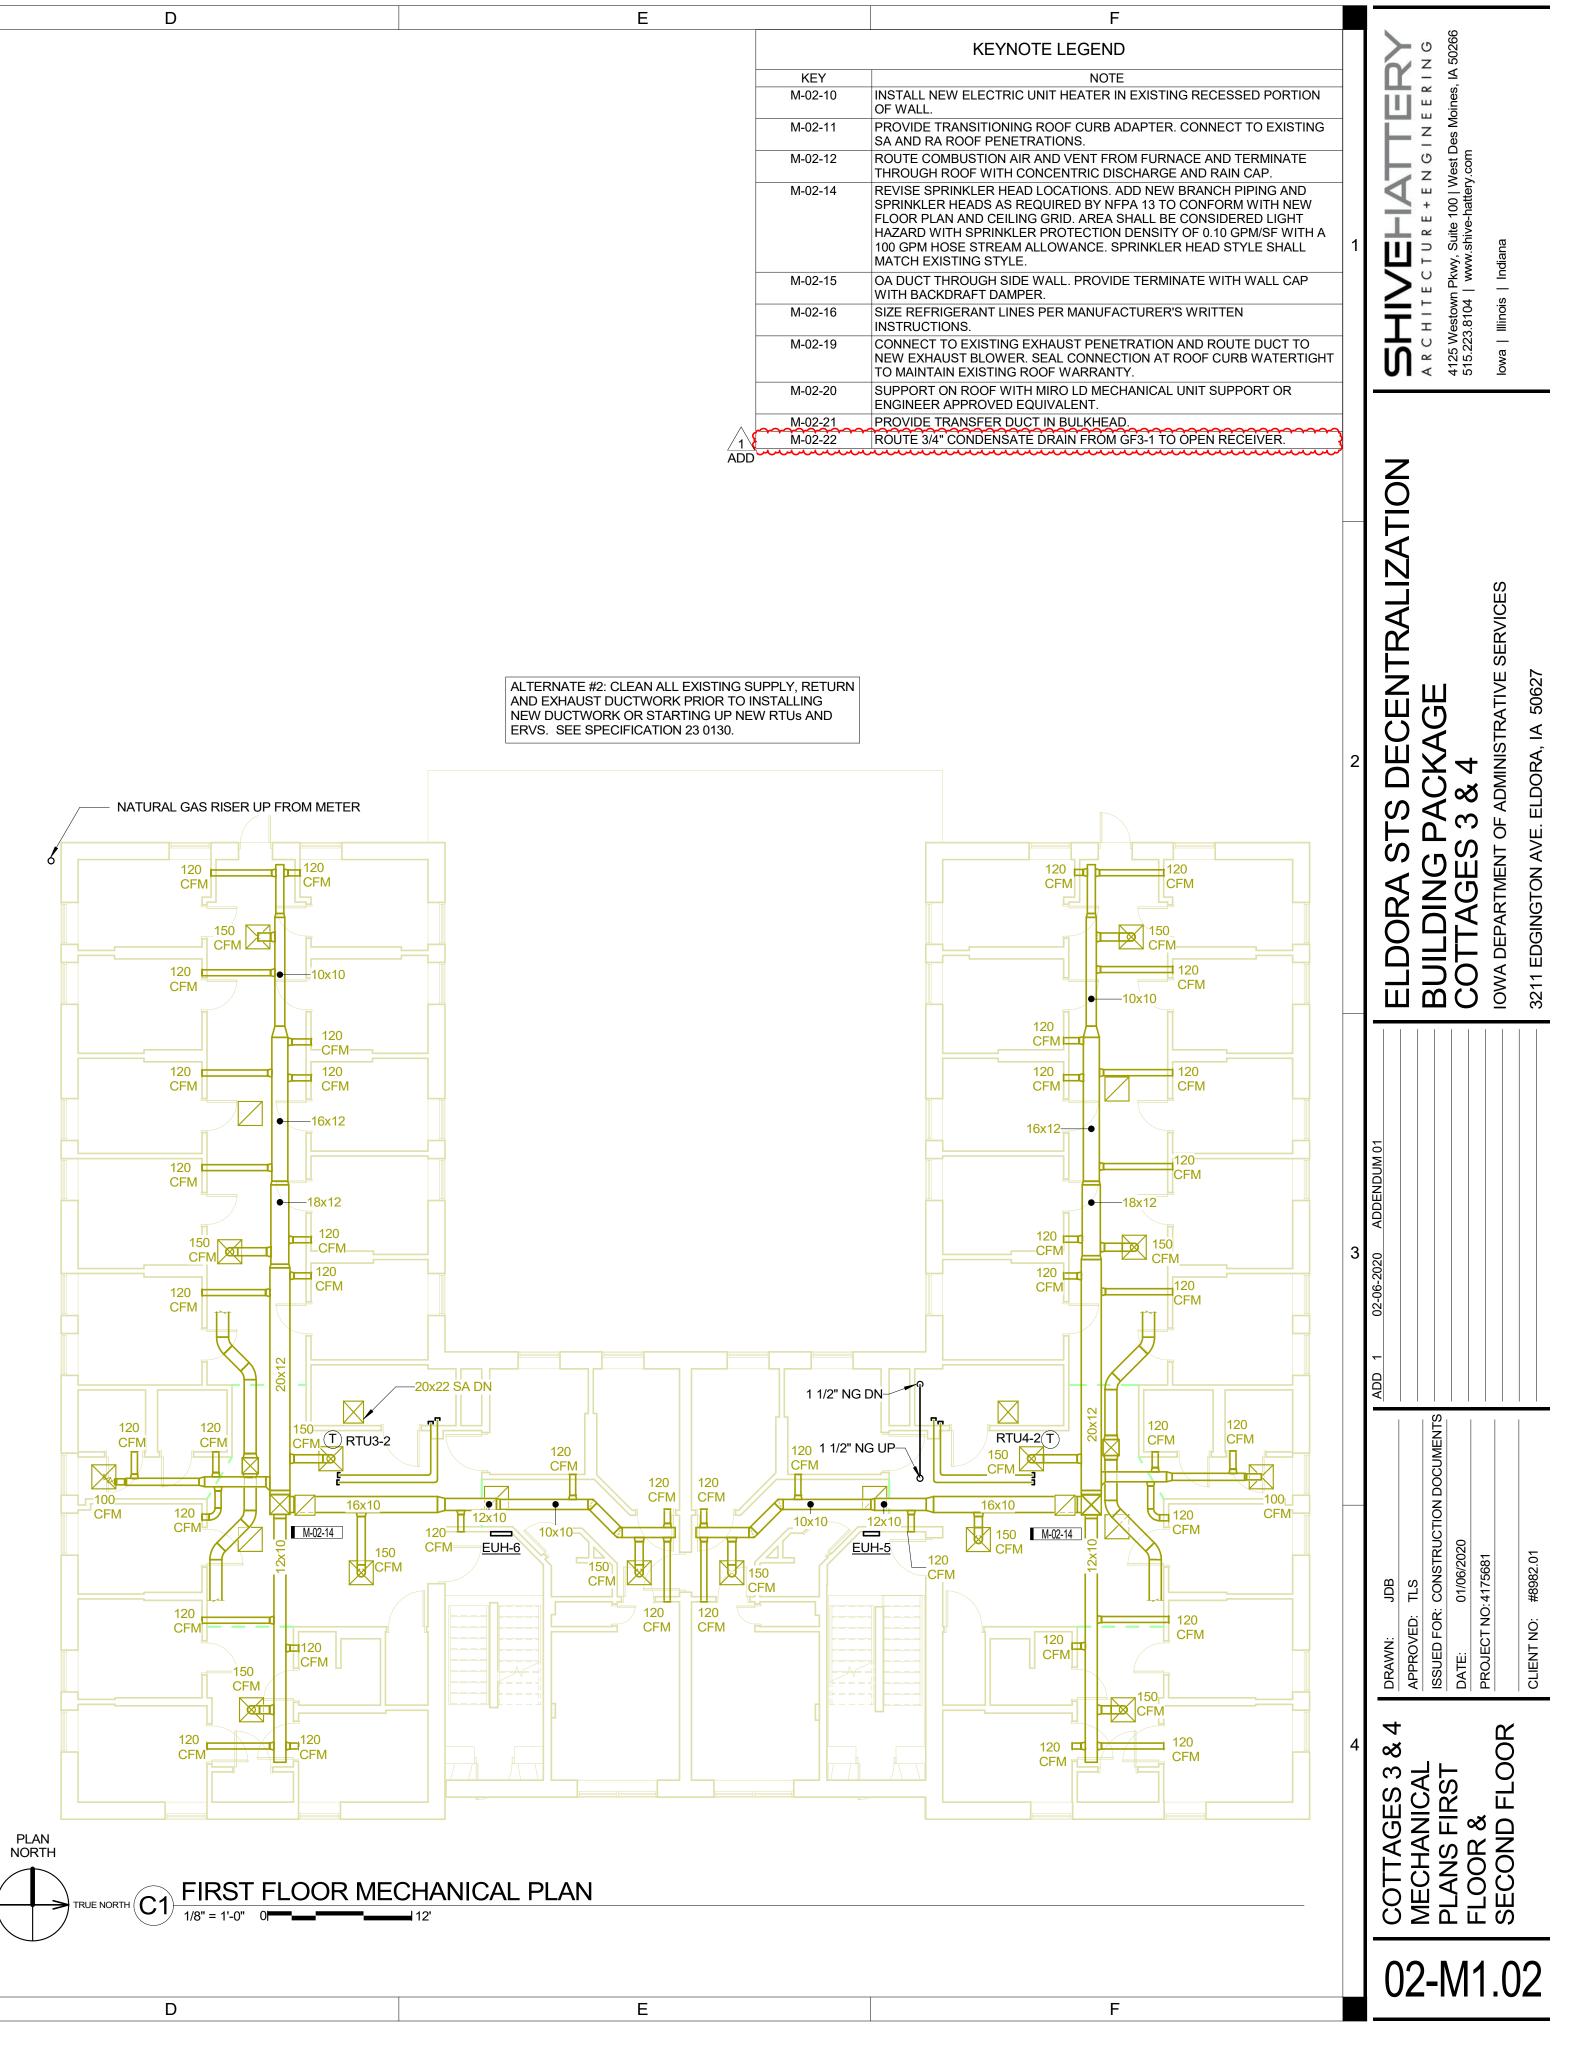

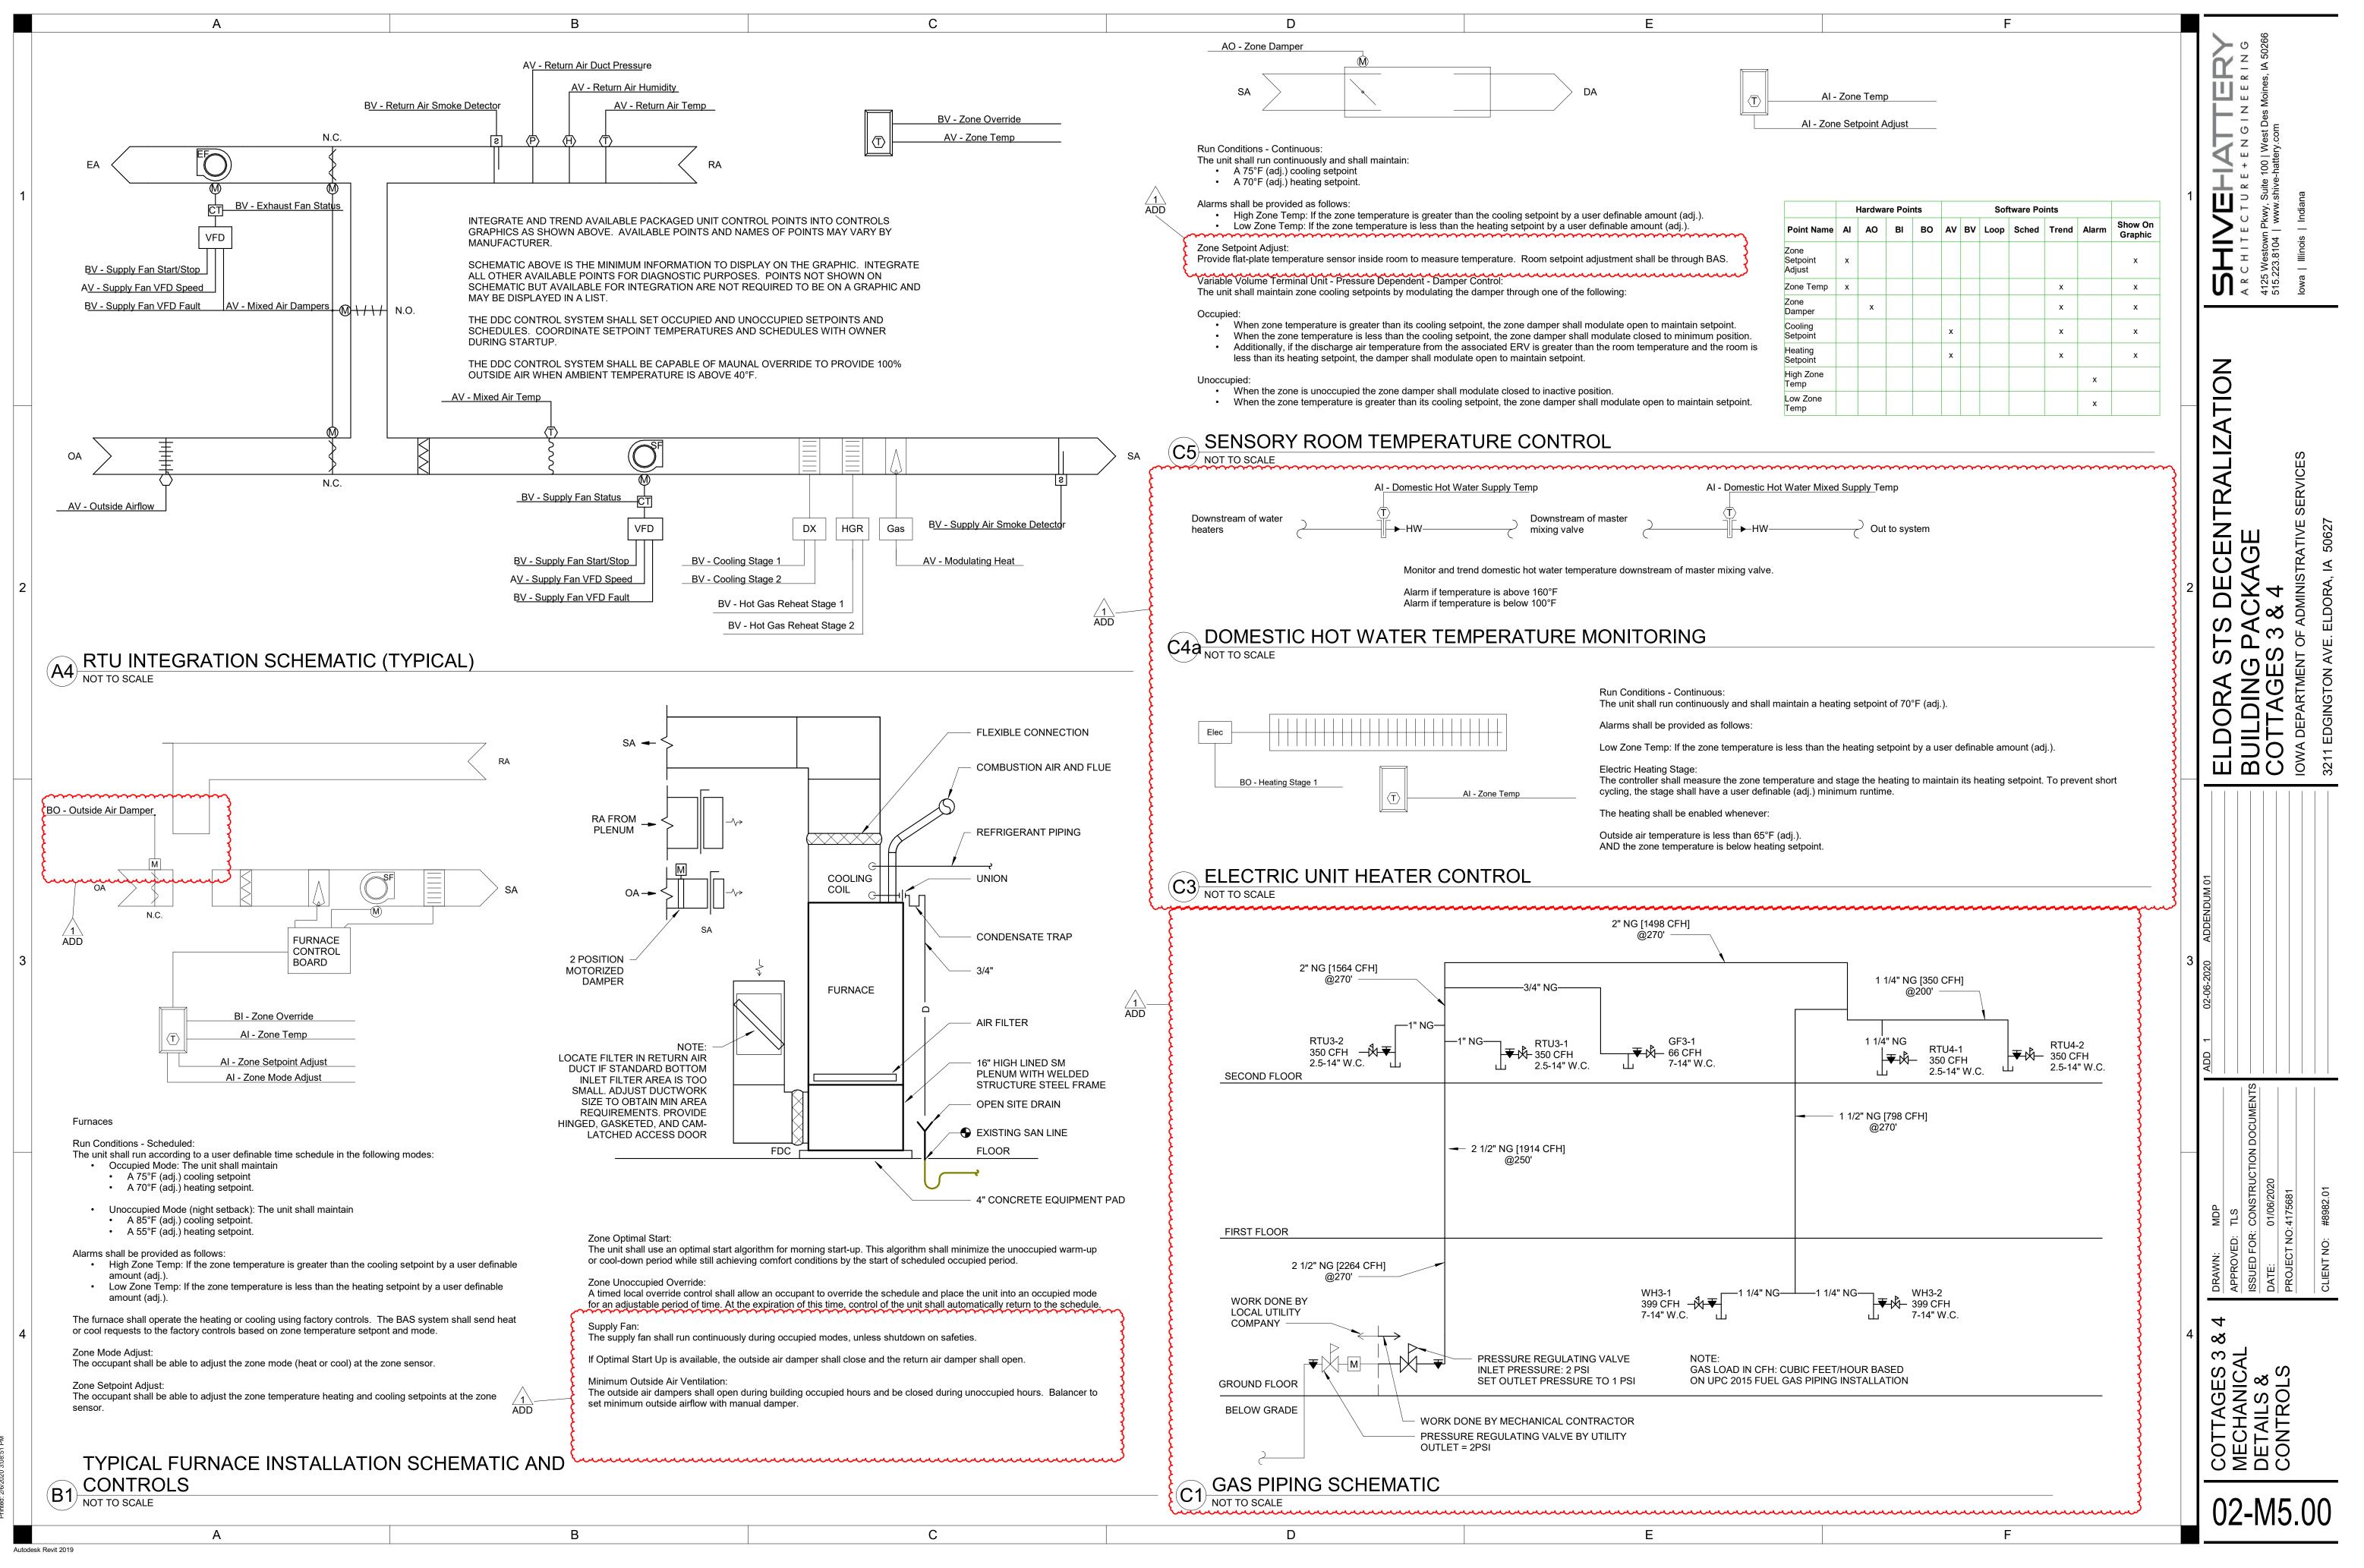

hive\Revit\_Local\_2019\EldoraSTS-Cottage1-MEP-Cent\_tscheidecker.rv

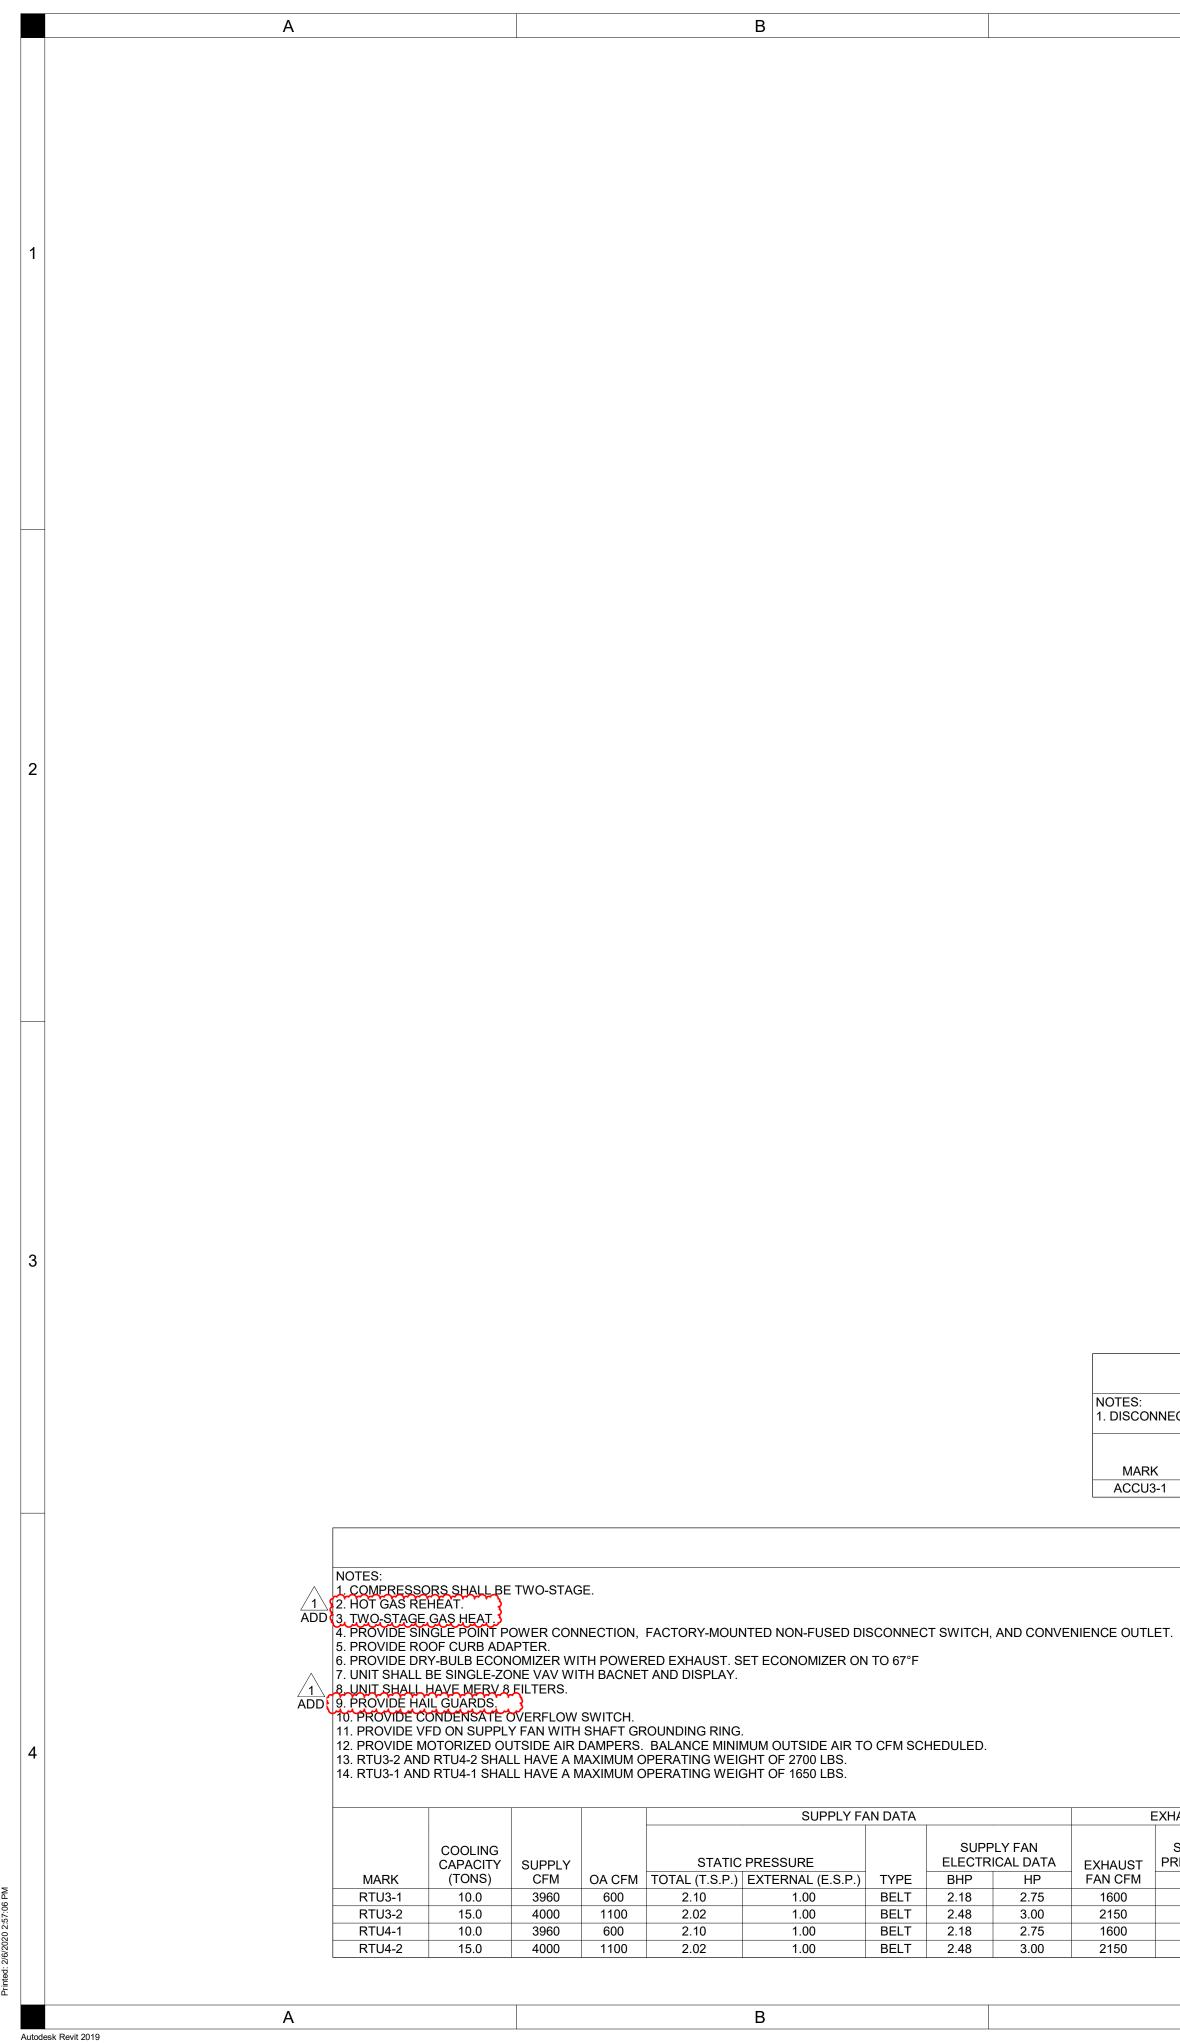

Е

/1\-

ADD

MARK	MATERIAL	DESCRIPTION	FACE
WARK	IVIATERIAL	DESCRIPTION	FACE
EG-A	ALUMINUM	PERFORATED ANTI LIGATURE	SEE PI
RG-B	STEEL	1/2"x1/2"x1/2", ALUMINUM BORDER	SEE PI
SG-C	ALUMINUM	PERFORATED ANTI LIGATURE	SEE PI
SG-D	STEEL	3/4" BLADE SPACING, DOUBLE DEFLECTION	SEE PI

				UNIT HE	ATER SCHEI
NOTES:					
		NG FRAME ON E			
2. DISCONNECT	T TO BE PROVID	DED AND INSTAL	LED BY ELECTR	RICAL CONTRAC	TOR.
			1		
				MOUNTING	
MARK	CFM	EAT (°F)	KW	HEIGHT (FT)	ORIENTATION
EUH-1	100	50	1.5	0' - 8"	HORIZONTAL
EUH-2	100	50	1.5	0' - 8"	HORIZONTAL
EUH-3	100	50	3	0' - 8"	HORIZONTAL
EUH-4	100	50	3	0' - 8"	HORIZONTAL
EUH-5	100	50	3	0' - 8"	HORIZONTAL

	FAN SCHEDULE
NOTES:	
1. DISCONNECT TO BE PROVIDED AND INSTALLED BY ELECTRICAL CONTRACTOR.	
2. PROVIDE BIRDSCREEN ON FAN OUTLET.	

D

	SYSTEM					MOTOR DATA				
MARK	SERVED	FAN TYPE	CFM	ESP (IN H20)	NO FLOW ESP (IN H20)	BHP	HP	VOLTS	PHASE	RPM
EF3-1	EXHAUST	BLOWER	1000	0.50	0.78	0.18	1/3	120	1	1080
EF4-1	EXHAUST	BLOWER	1000	0.50	0.78	0.18	1/3	120	1	1080

						FU	RNACE - GA	S SCHEDUL	E		
NOTE: . REFER TO FILTER SCHEDULE FOR SIZE AND EFFICIENCY. 2. DISCONNECT TO BE PROVIDED AND INSTALLED BY ELECTRICAL CONTRACTOR.											
							HEATING DATA				
				AIRFLOW				MINIMUM GAS			
MARK	OA CFM	CFM	ESP (IN WC)	DIRECTION	EAT (°F)	LAT (°F)	INPUT MBH	PRESSURE	AFUE		
GF3-1	150	1000	0.80	UPFLOW	50	100	66	3.5	96		

AIR COOLED CONDENSING UNIT SCHEDULE												
NOTES: 1. DISCONNECT TO BE PROVIDED AND INSTALLED BY ELECTRICAL CONTRACTOR.												
					MINIMUM OPERATING				E	ELECTRICAL DATA		
MARK	LOCATION	SYSTEM SERVED	CAPACITY (MBH)	COND AMBIENT AIR TEMP (°F)	AMBIENT TEMPERATURE	NUMBER OF CIRCUITS	NUMBER OF COMPRESSORS	SEER	VOLTS	PHASE		
ACCU3-1	ROOF	GF3-1	35.2	95	0	1	1	20	208	1		

### PACKAGED ROOFTOP UNIT SCHEDULE


С


С


I	EXHAUST FAN	I DATA				COOLING DATA		HEATING COIL						
EXHAUST	STATIC PRESSURE	EXHAUST FAN ELECTRICAL DATA	EAT (°F)		LAT (°F)	REFRIGERANT				EAT DB			GAS	
FAN CFM	ESP	HP	DB	WB	DB	TYPE	MBH	EER	IEER	(°F)	LAT DB (°F)	INPUT (MBH)	OUTPUT (MBH)	THERMAL EFFIC
1600	0.40	0.9	79.5	67.0	57.5	R-410A	107.4	12.4	15.2	52	98	250	200	80
2150	0.40	0.8	81.2	67.0	56.5	R-410A	164.75	12	15	45	101	300	280	80
1600	0.40	0.9	79.5	67.0	57.5	R-410A	107.4	12.4	15.2	52	98	250	200	80
2150	0.40	0.8	81.2	67.0	56.5	R-410A	164.75	12	15	45	101	300	280	80

D

Е

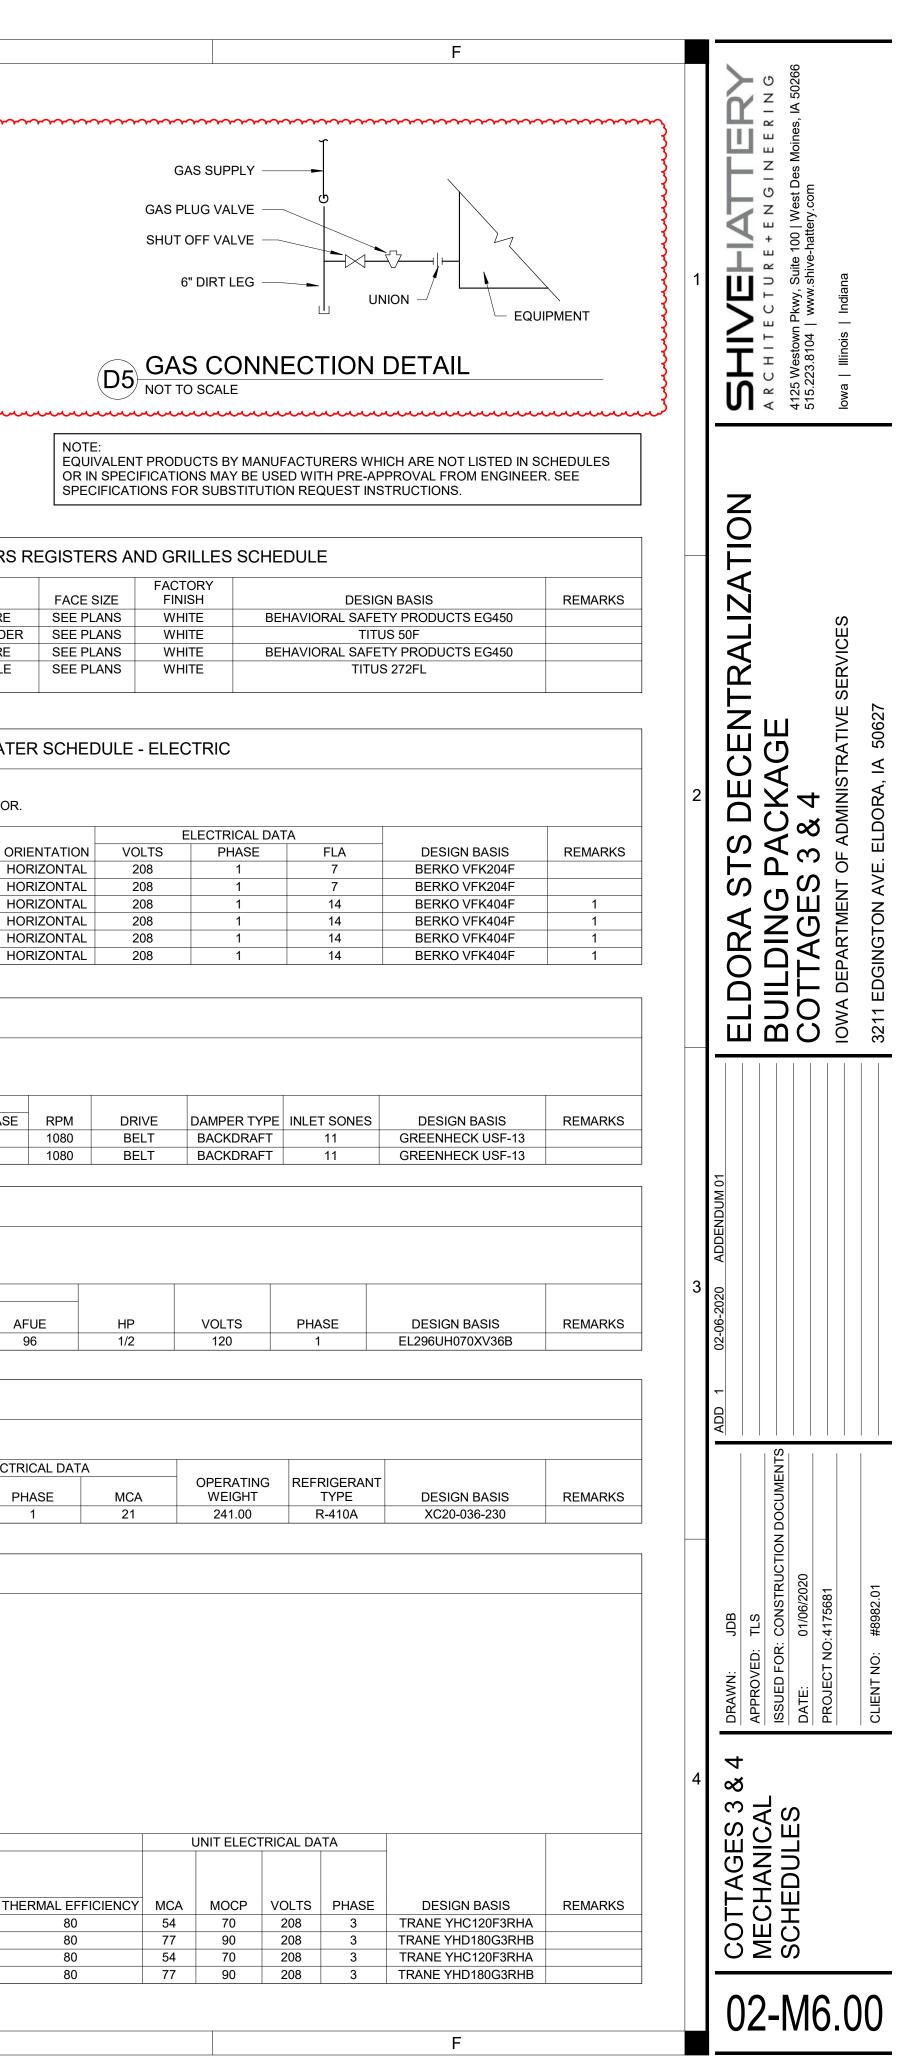

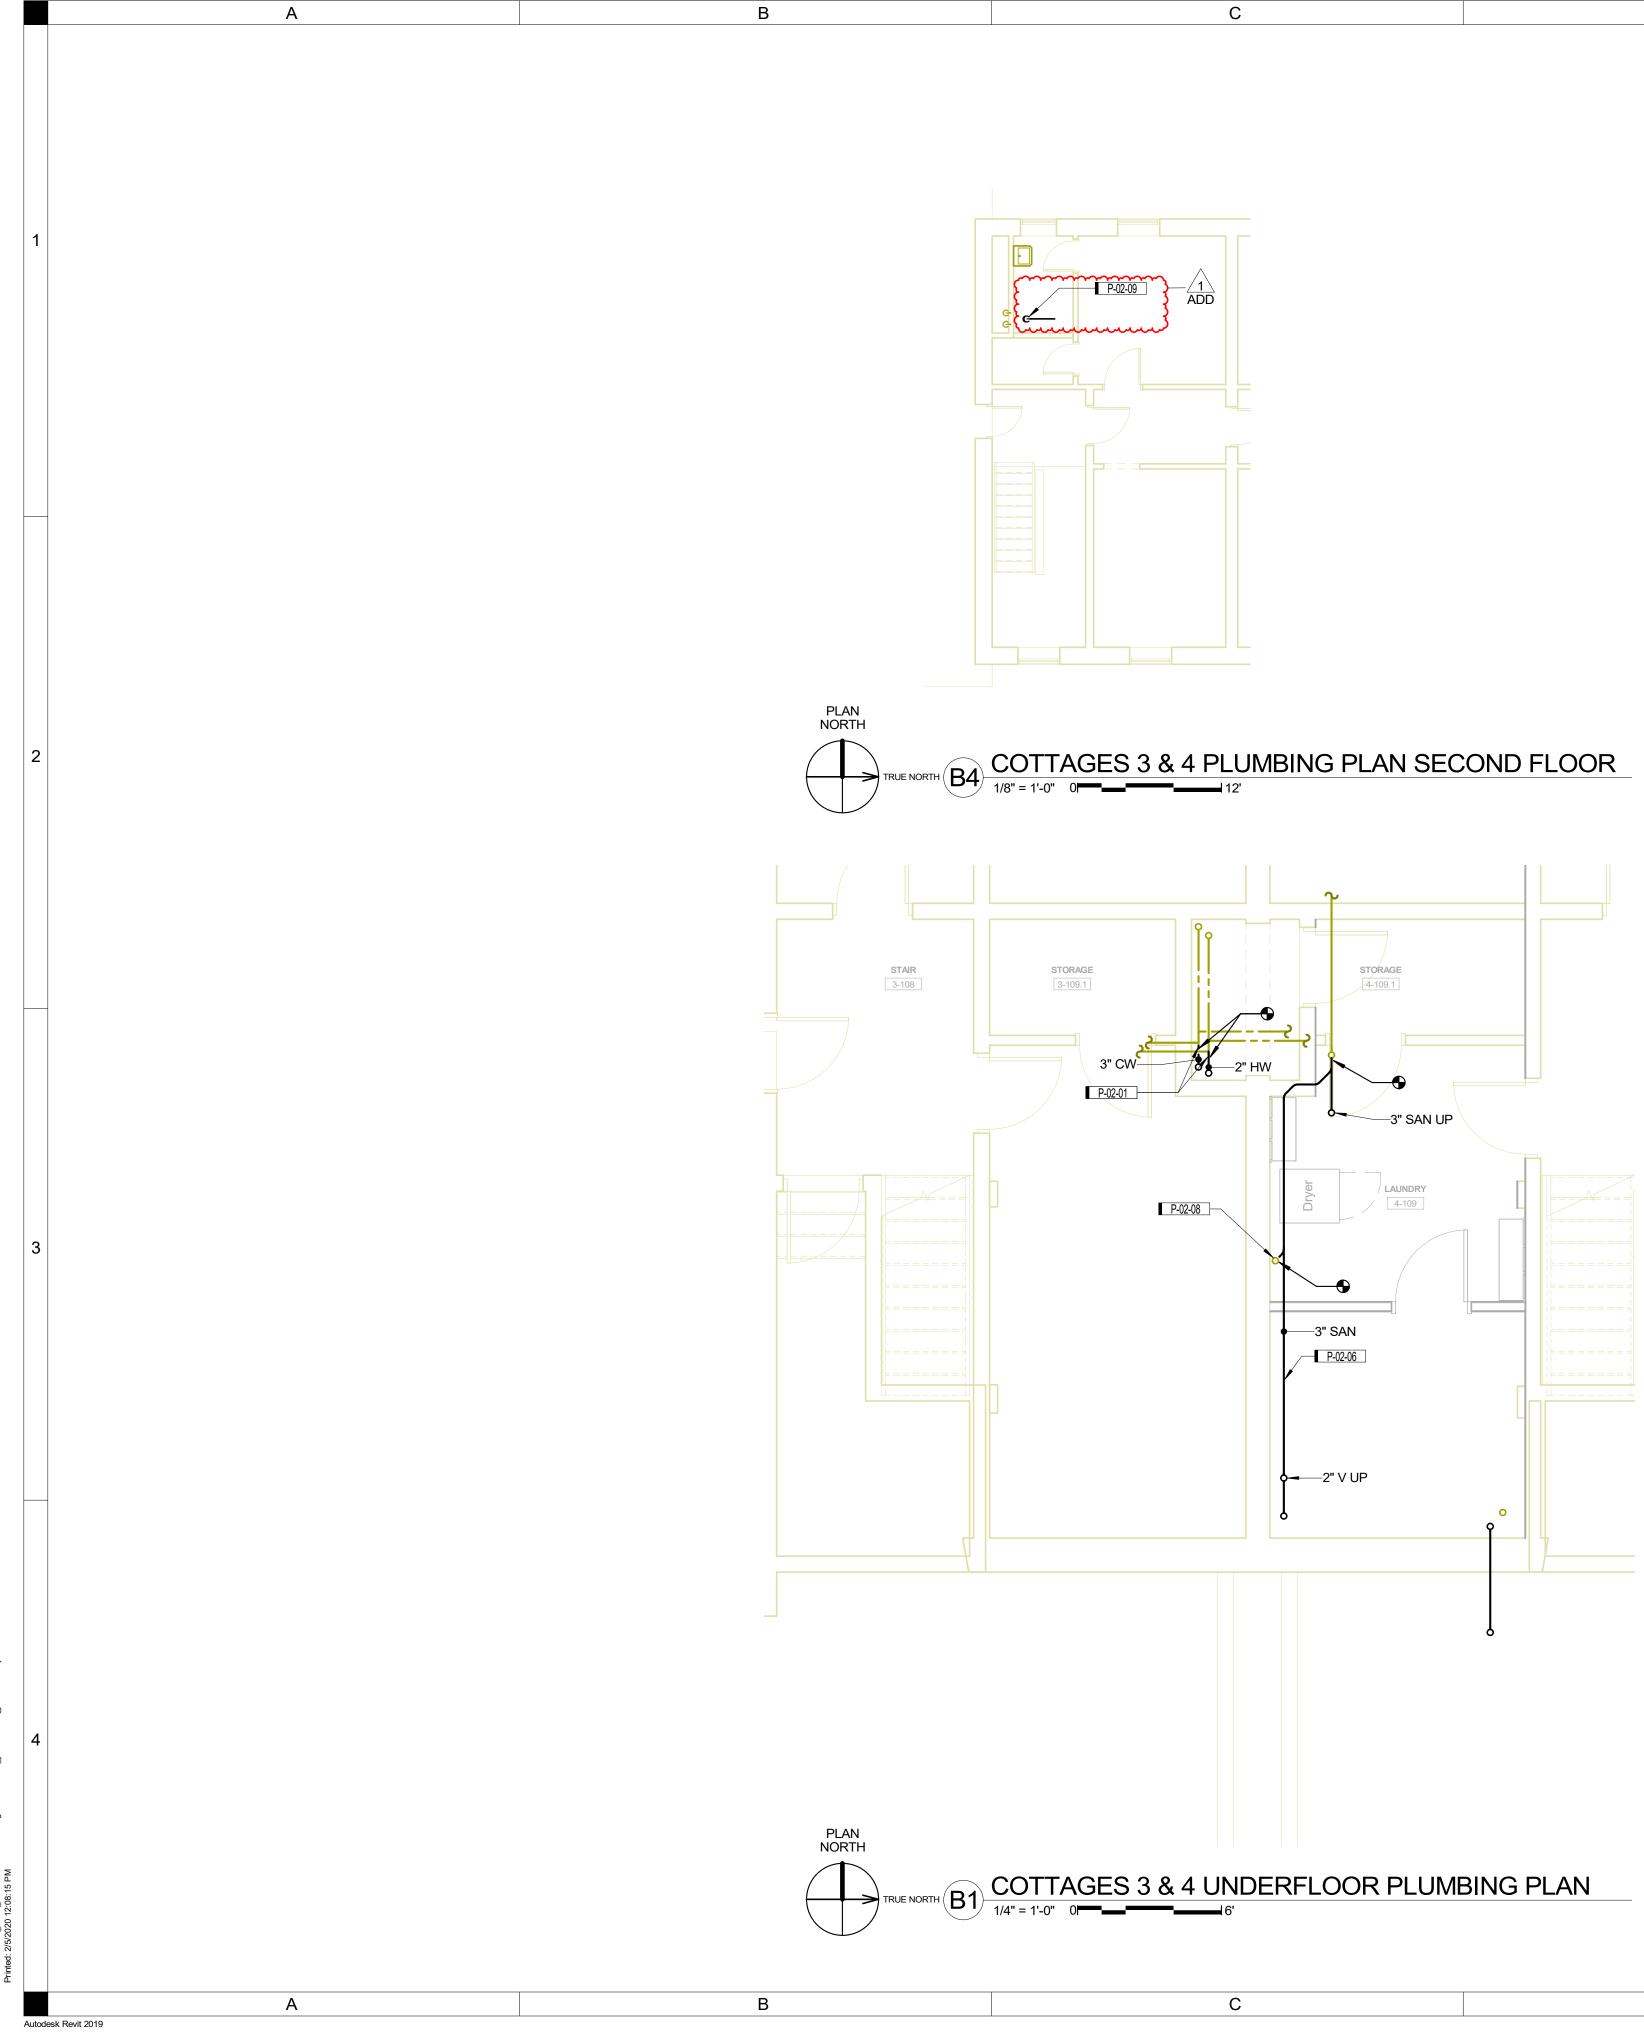


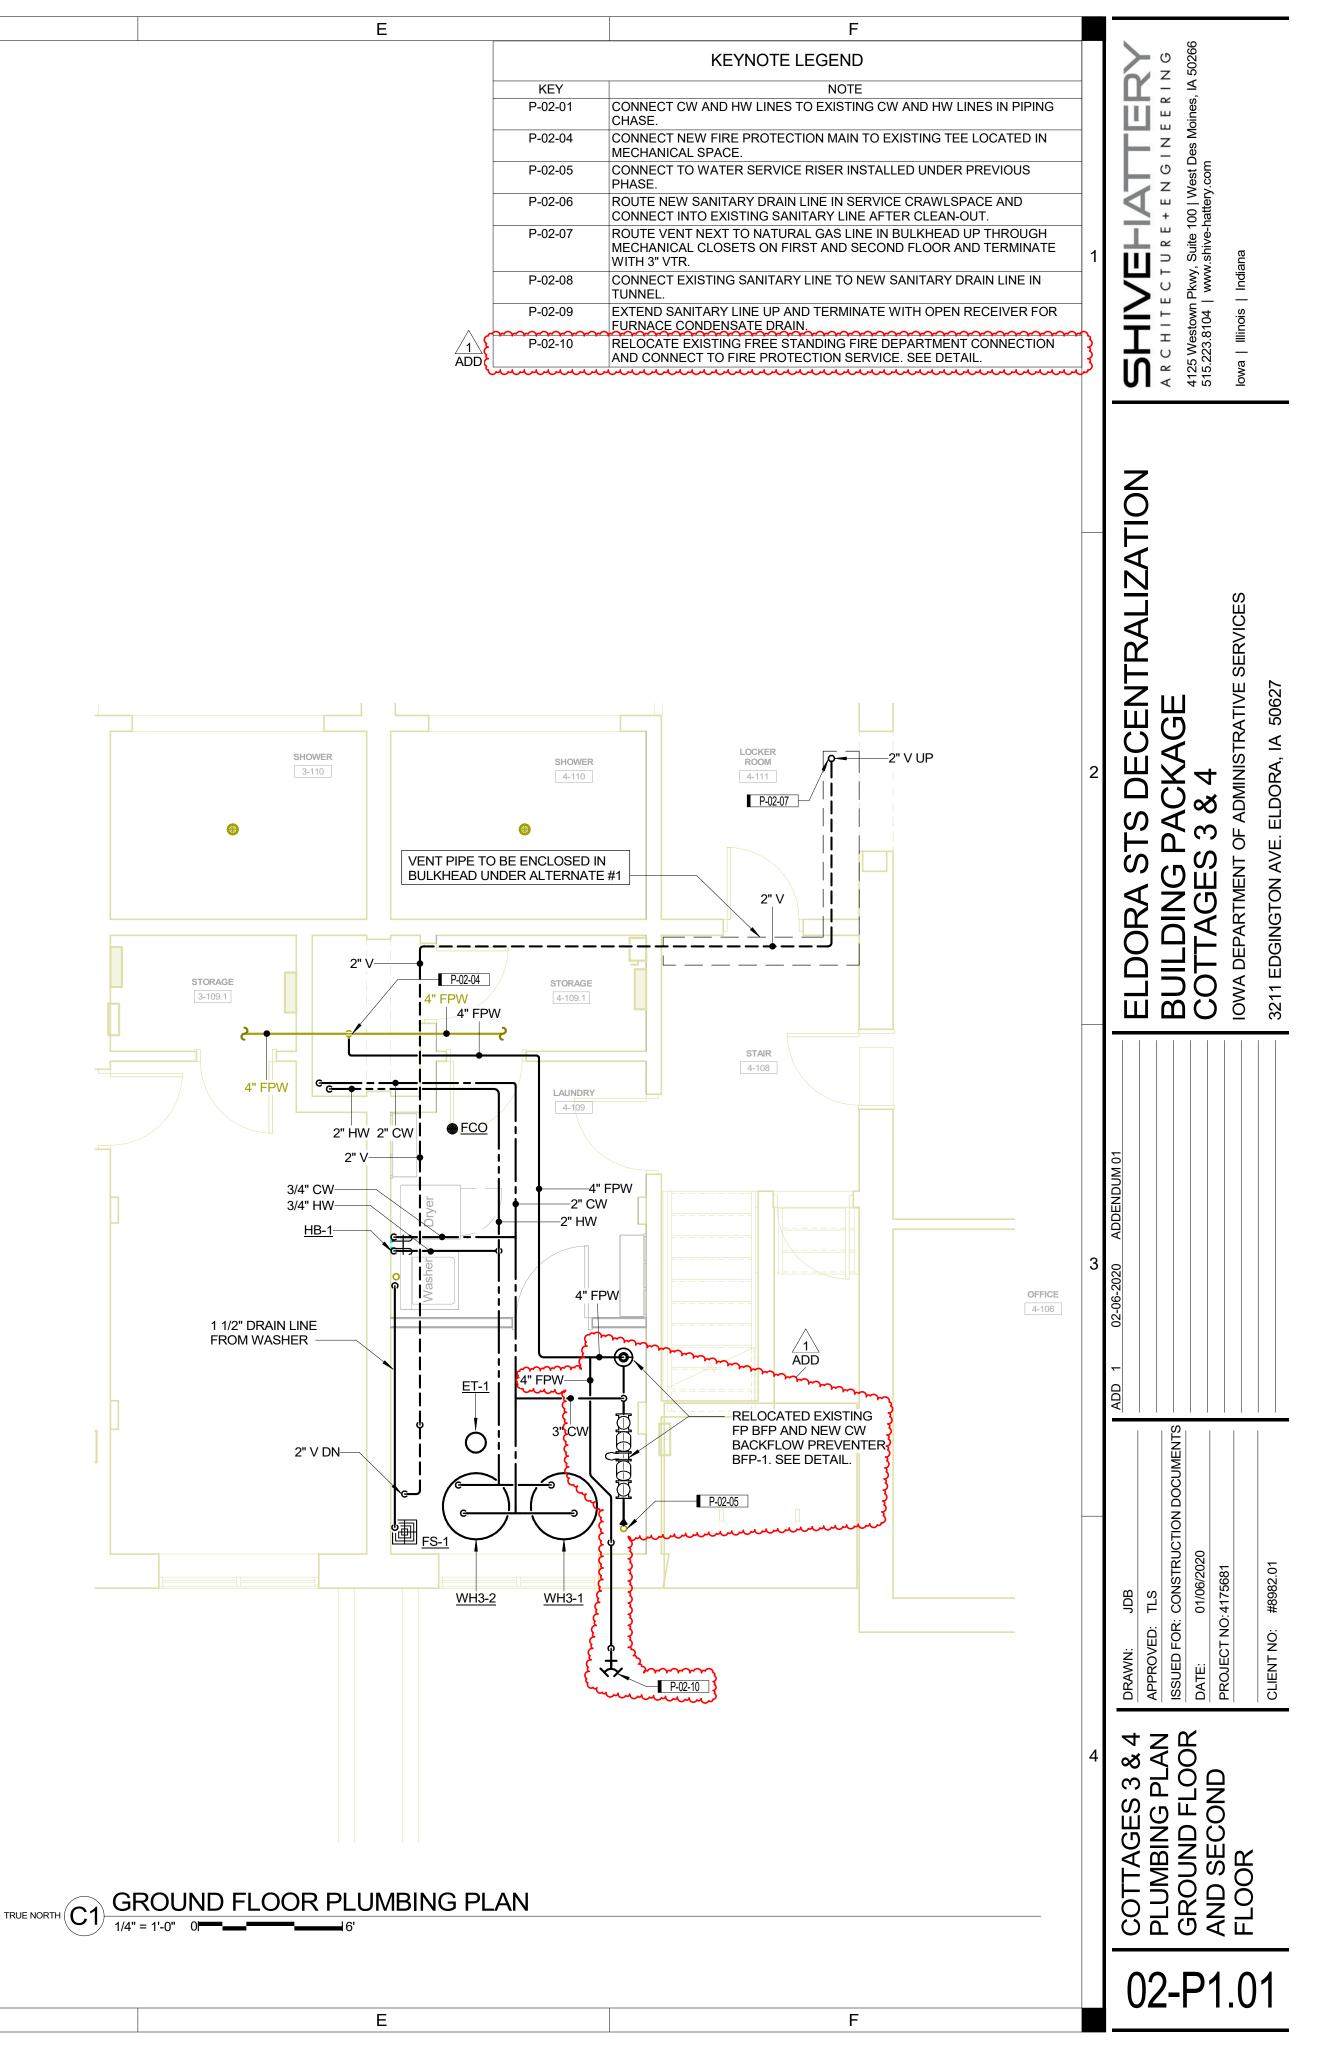



D

PLAN NORTH

D

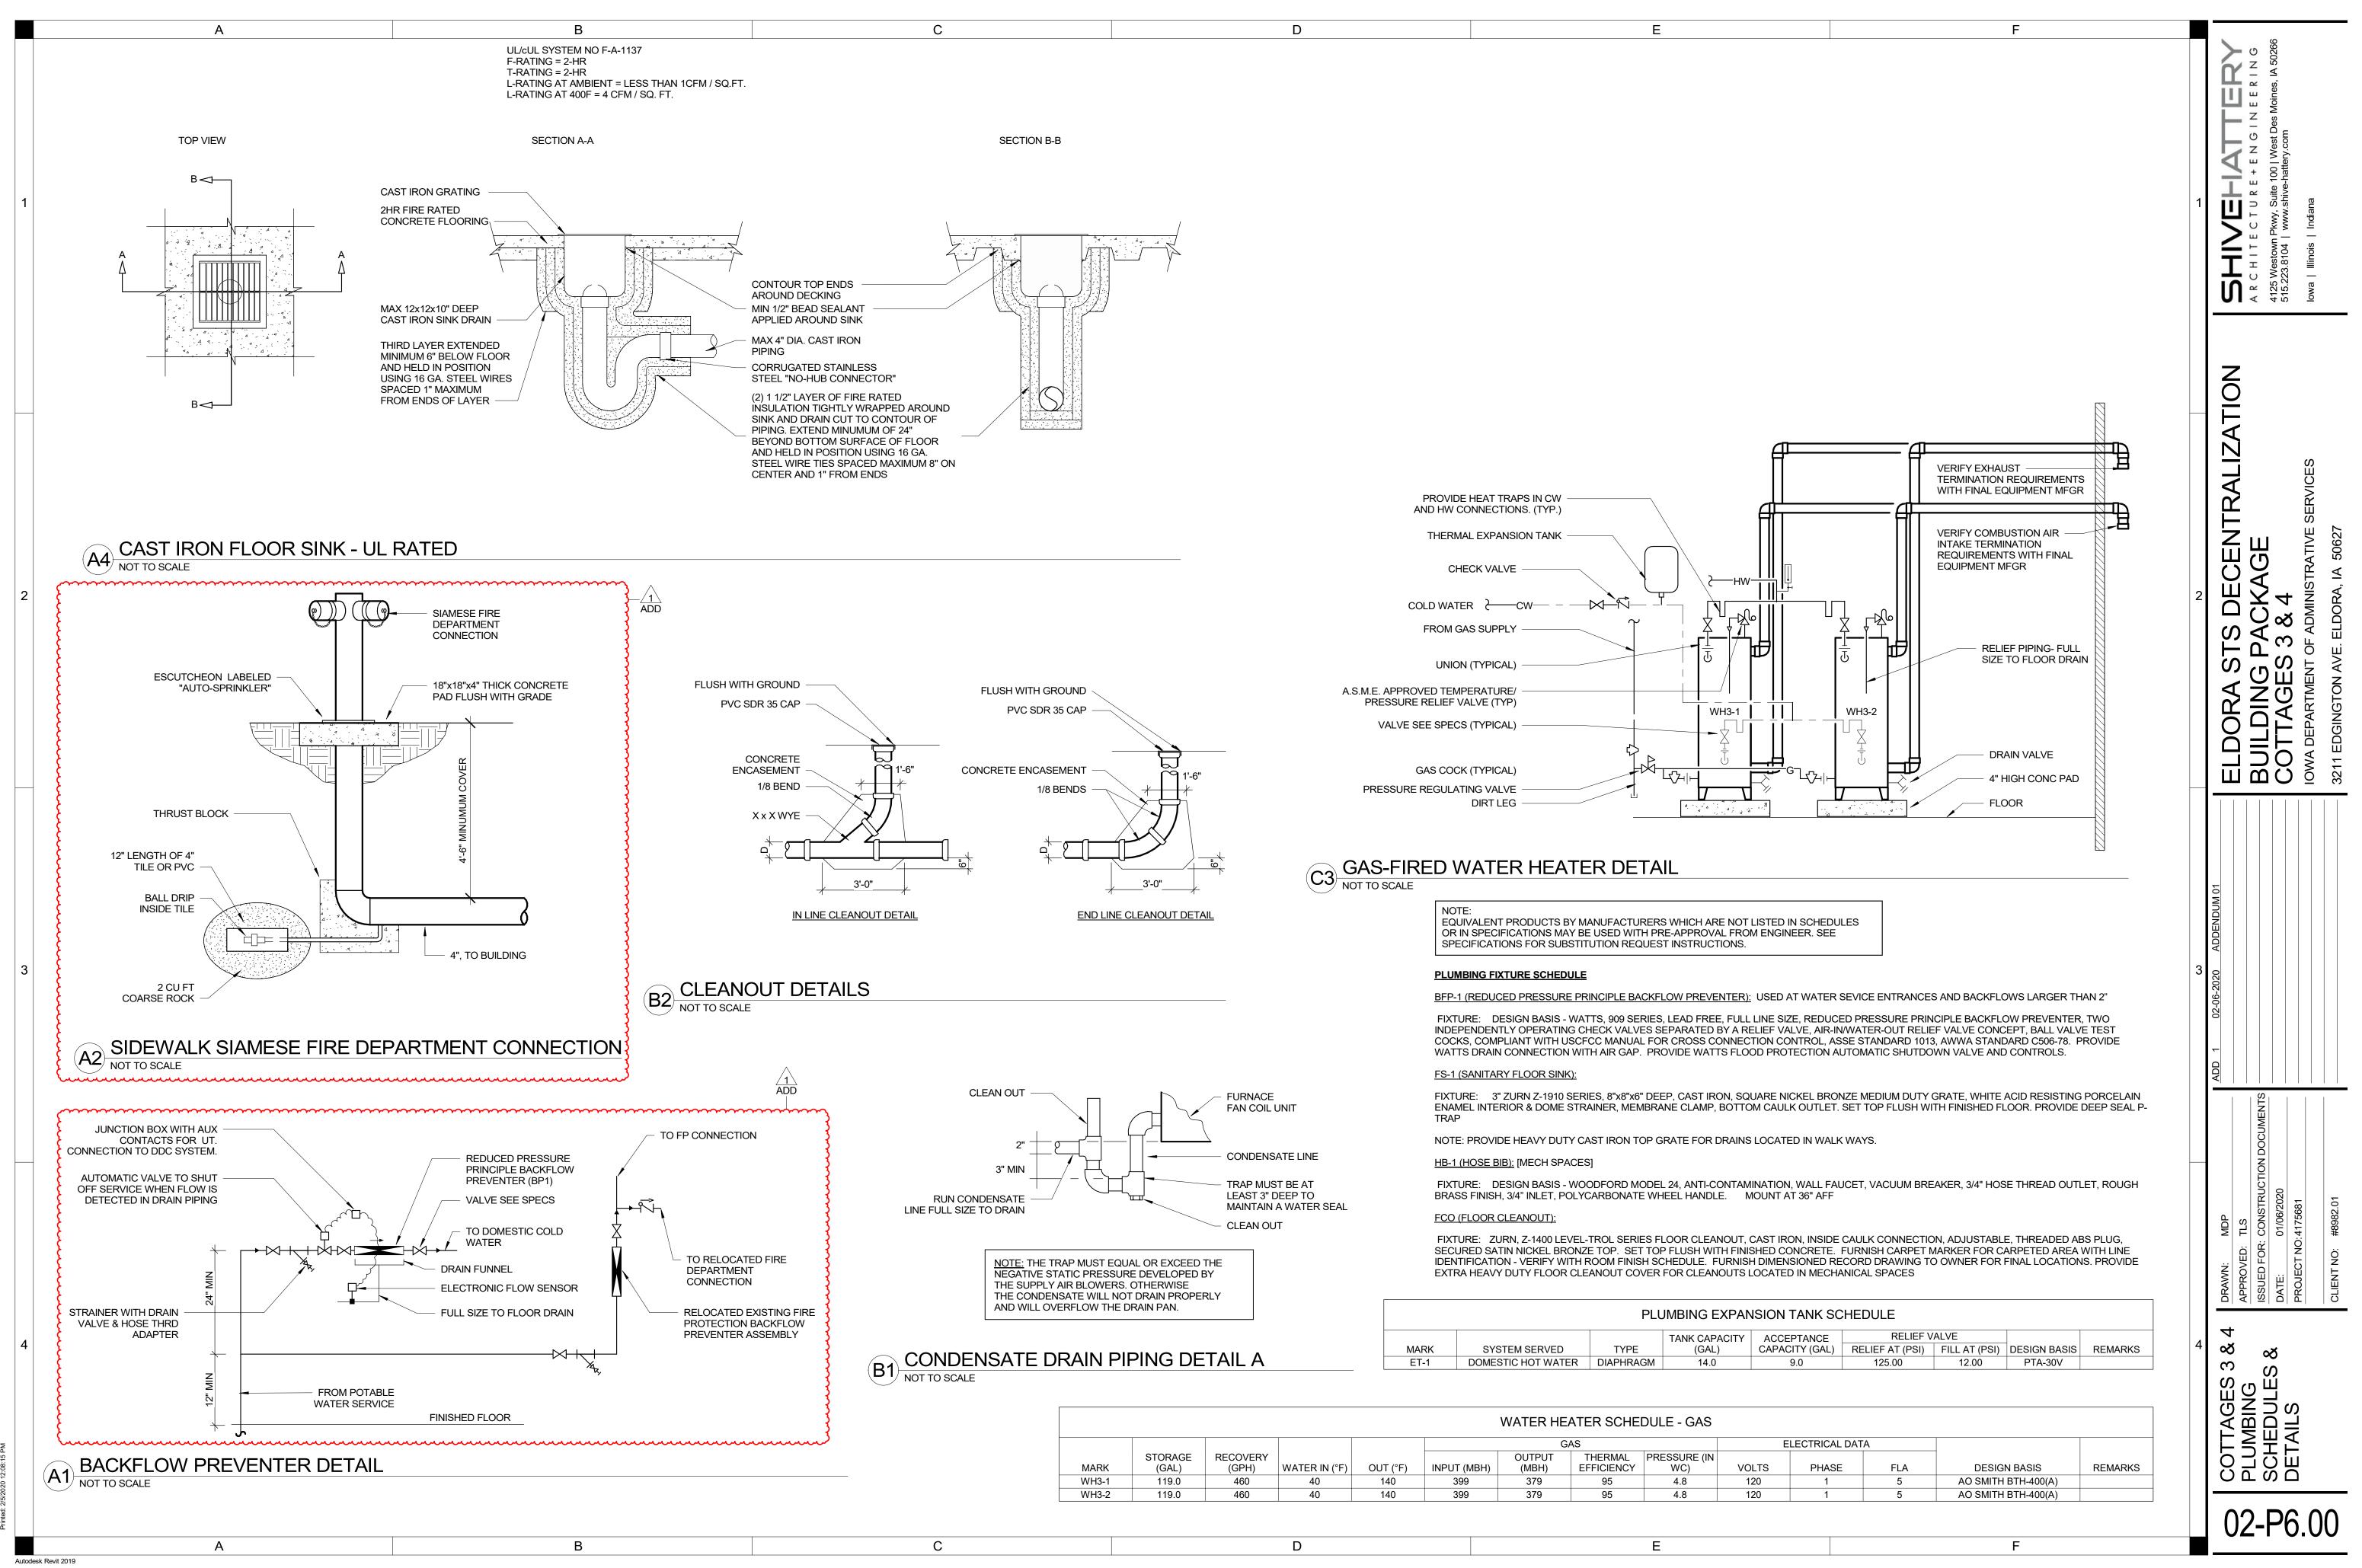

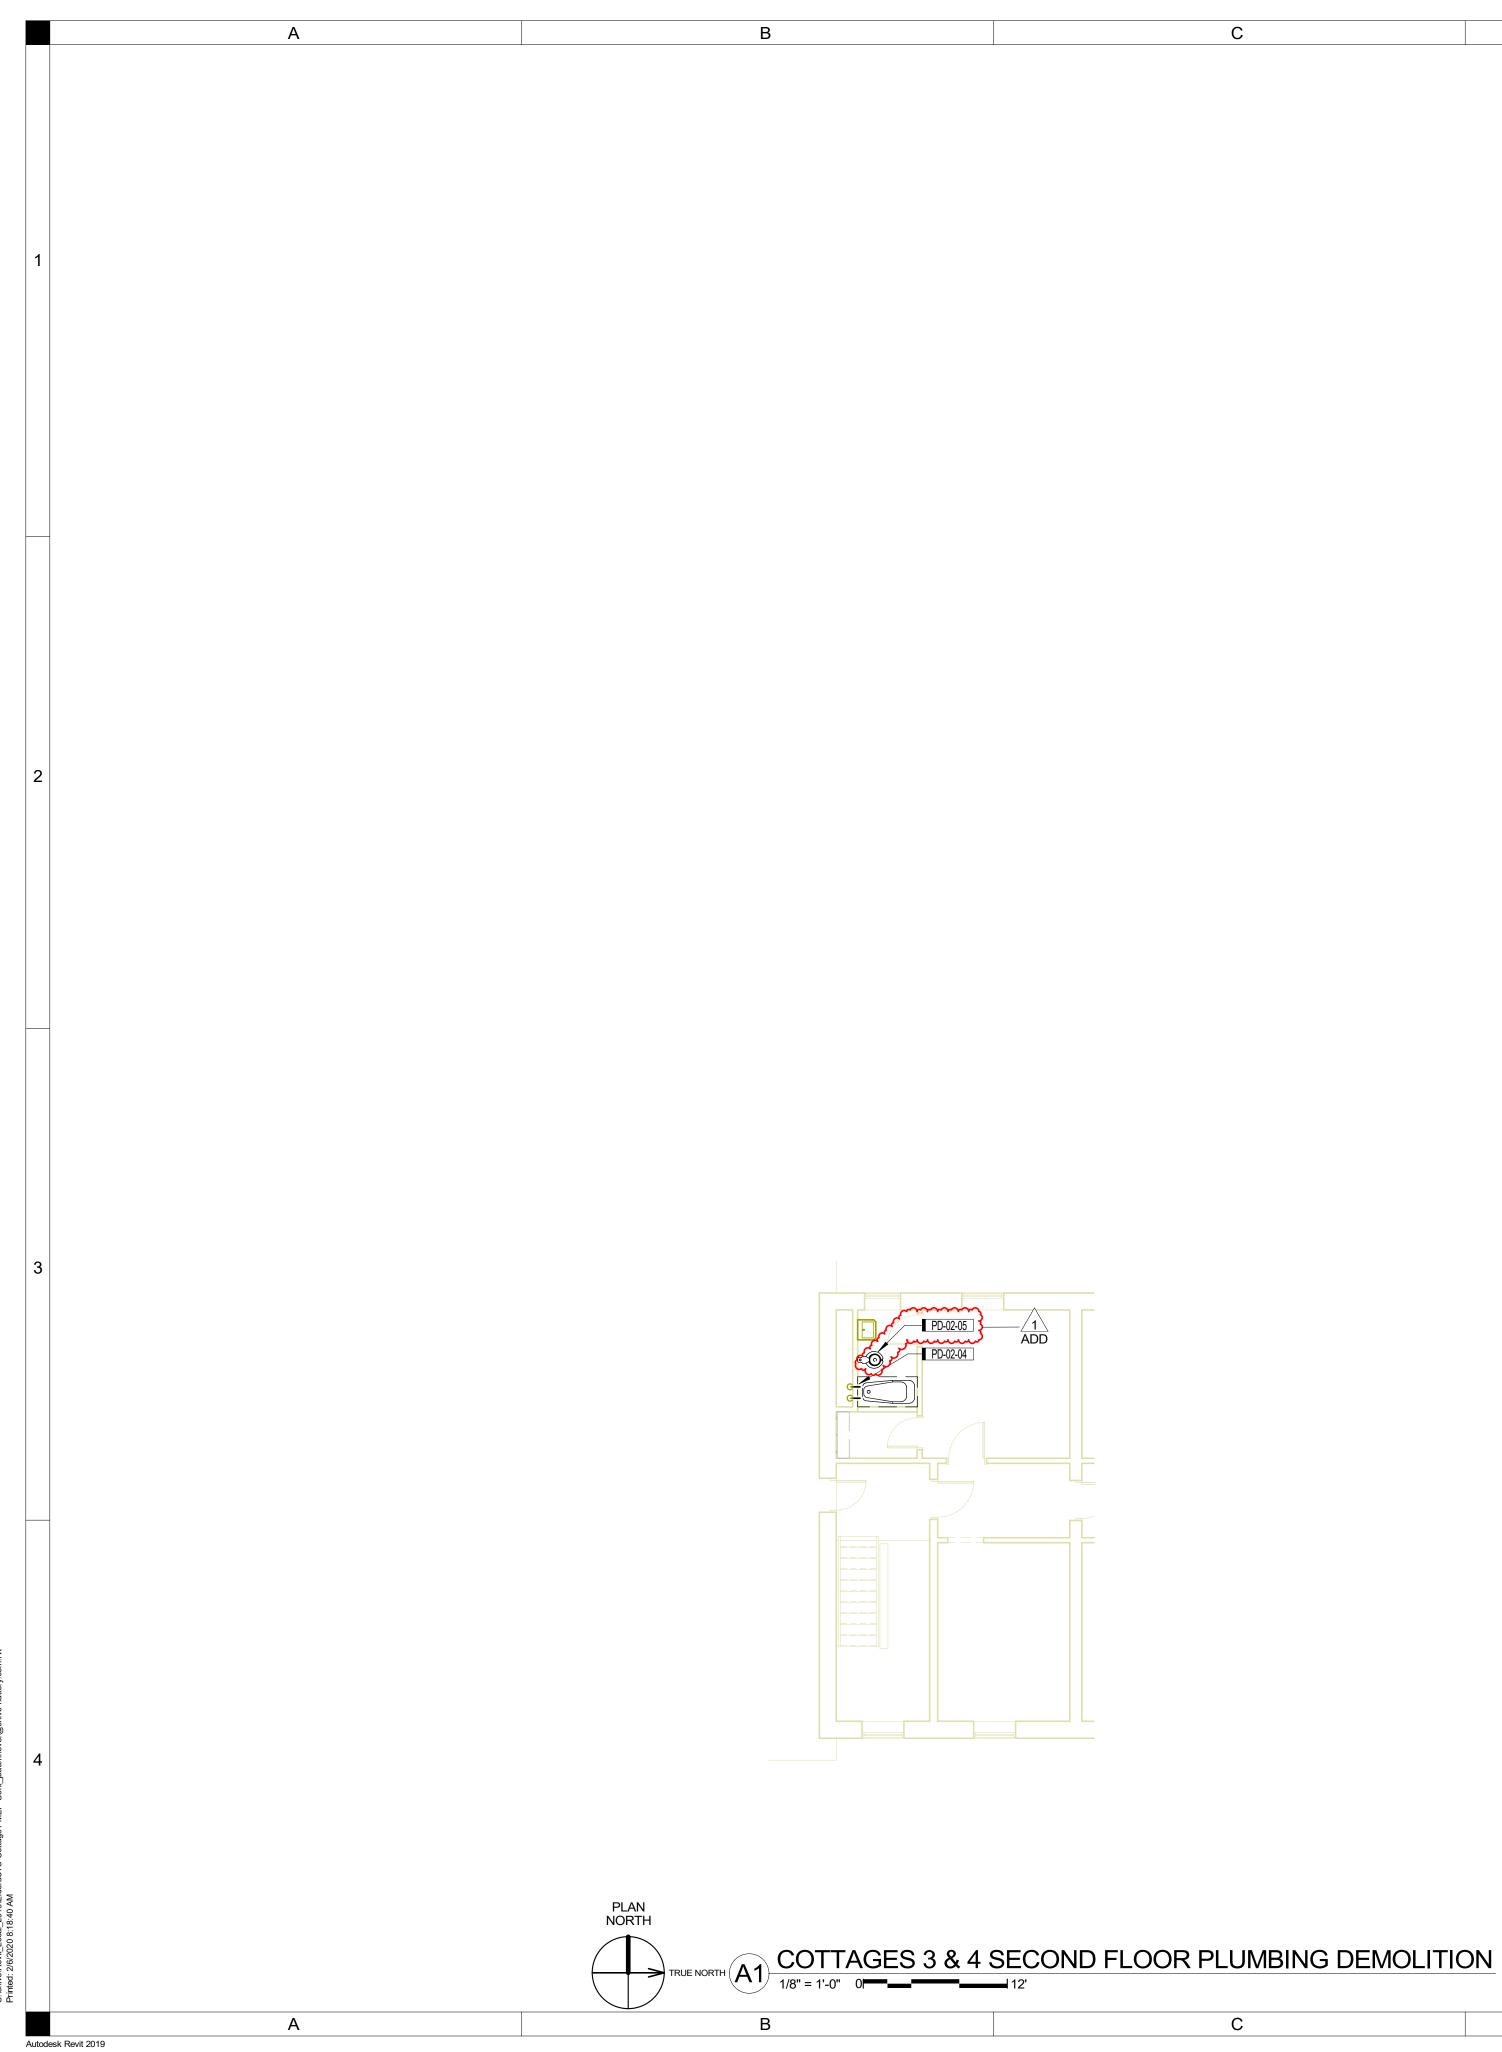

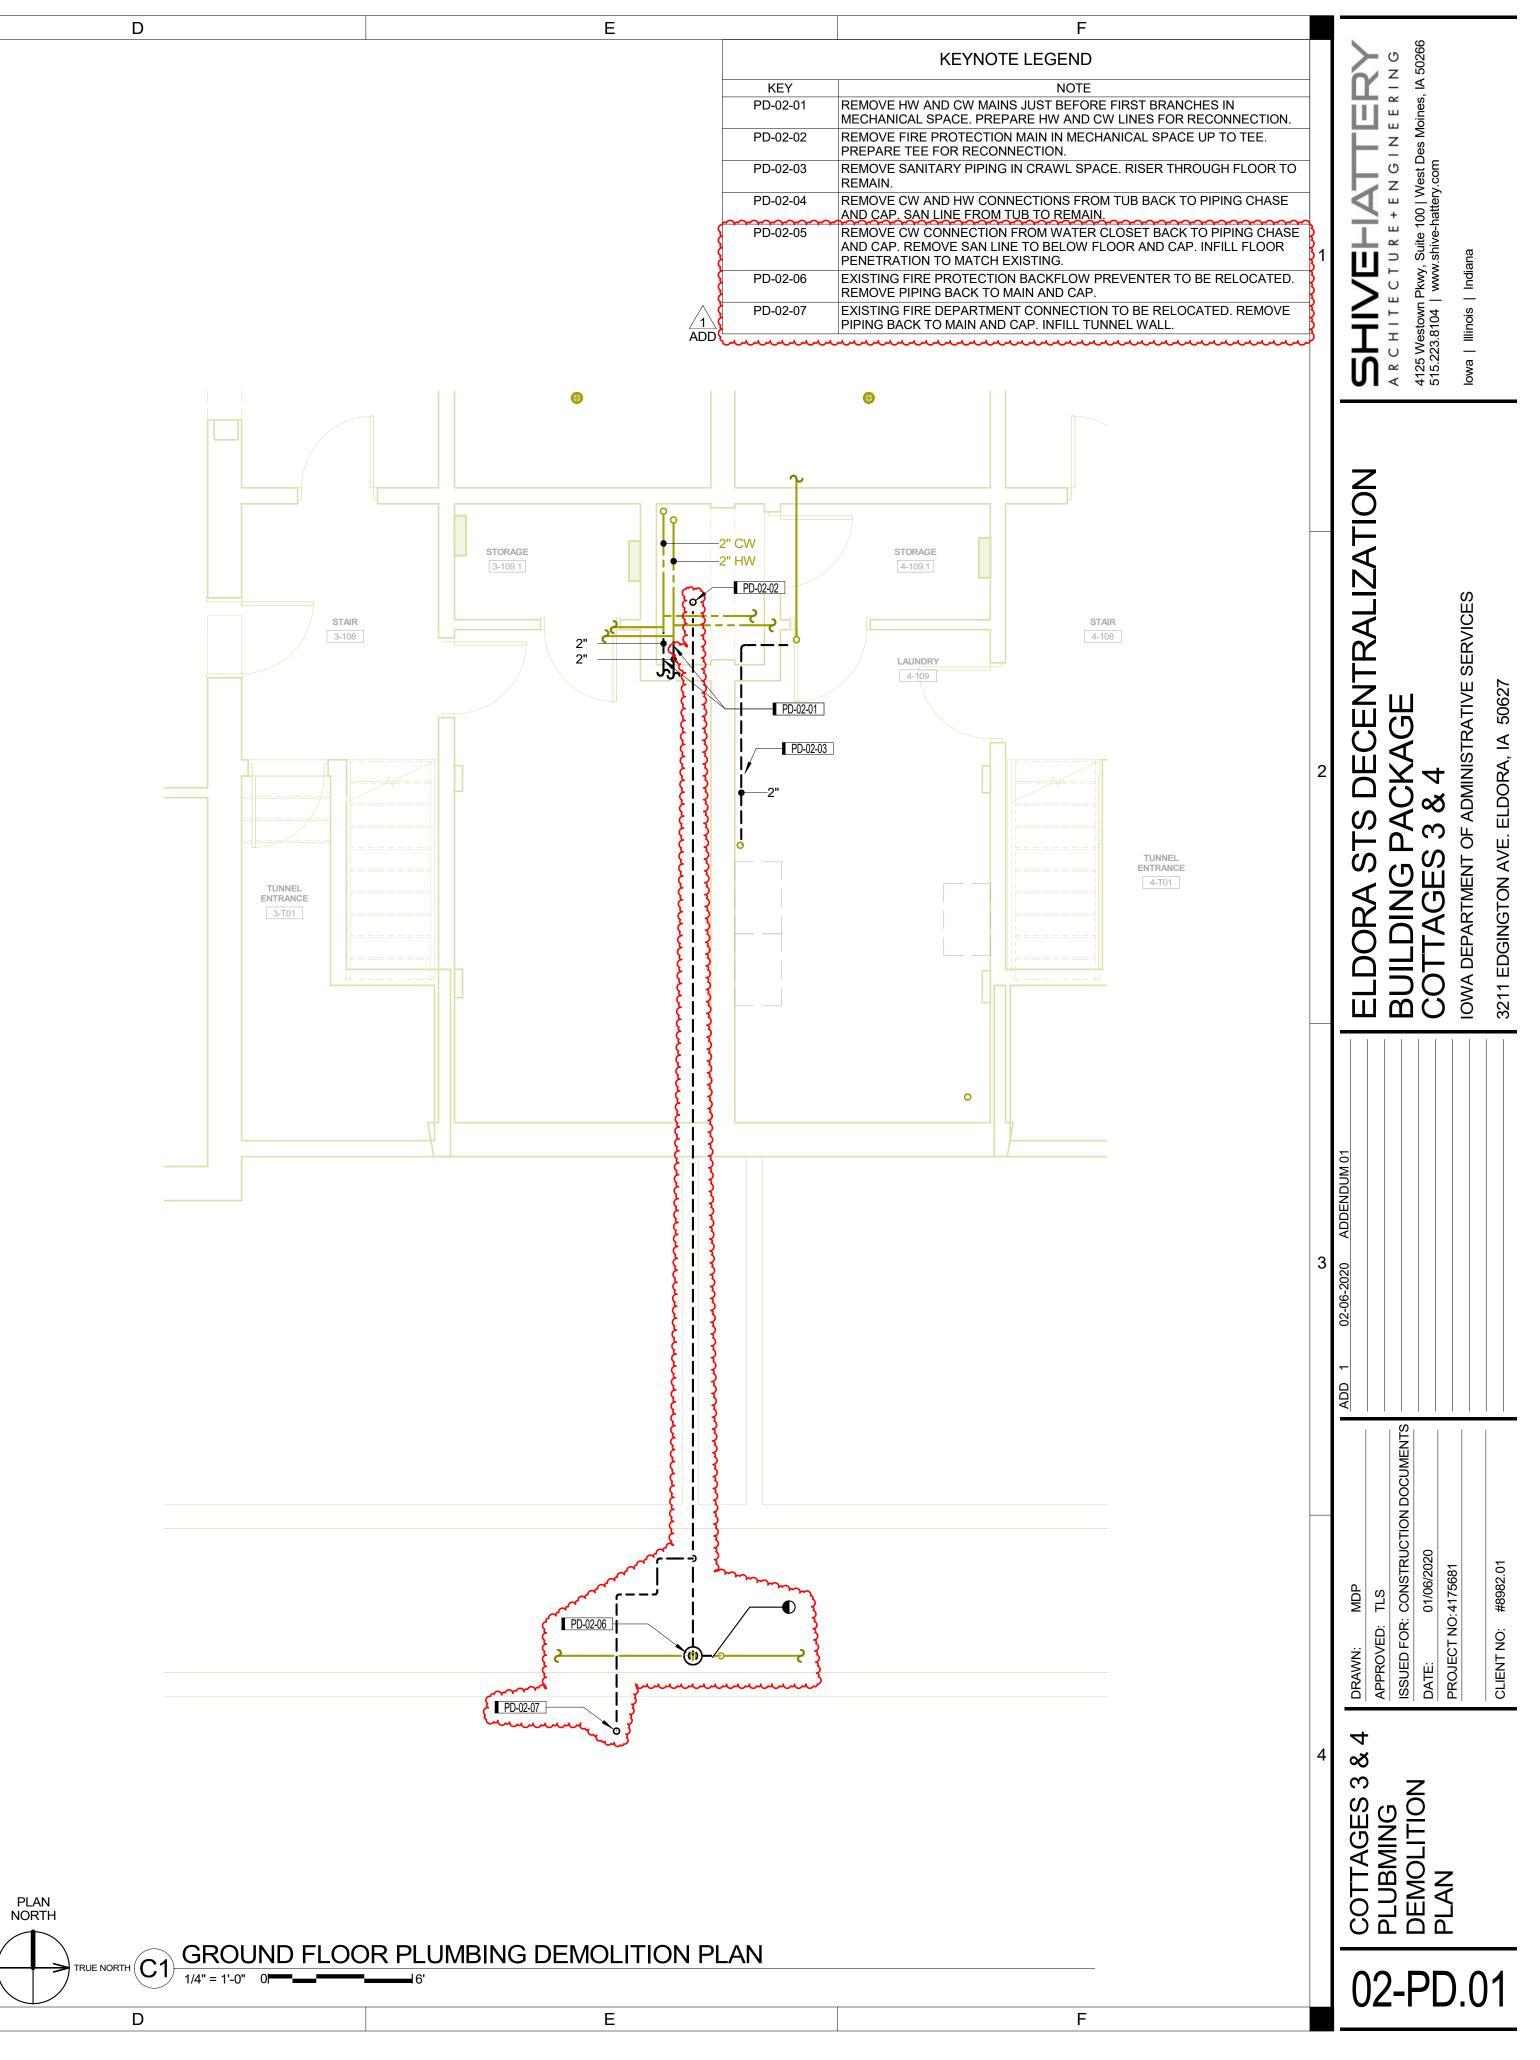

С


jbaumhover@shive-hattery.com.rvt	
oraSTS-Cottage2-MEP-Cent	
cal_2019/Eld	
shive\Revit_Lo	

Autodesk Revit 2019

А


		А	В	
	_			
	1			
	2			
	3			
	U			
	4			
1				


В

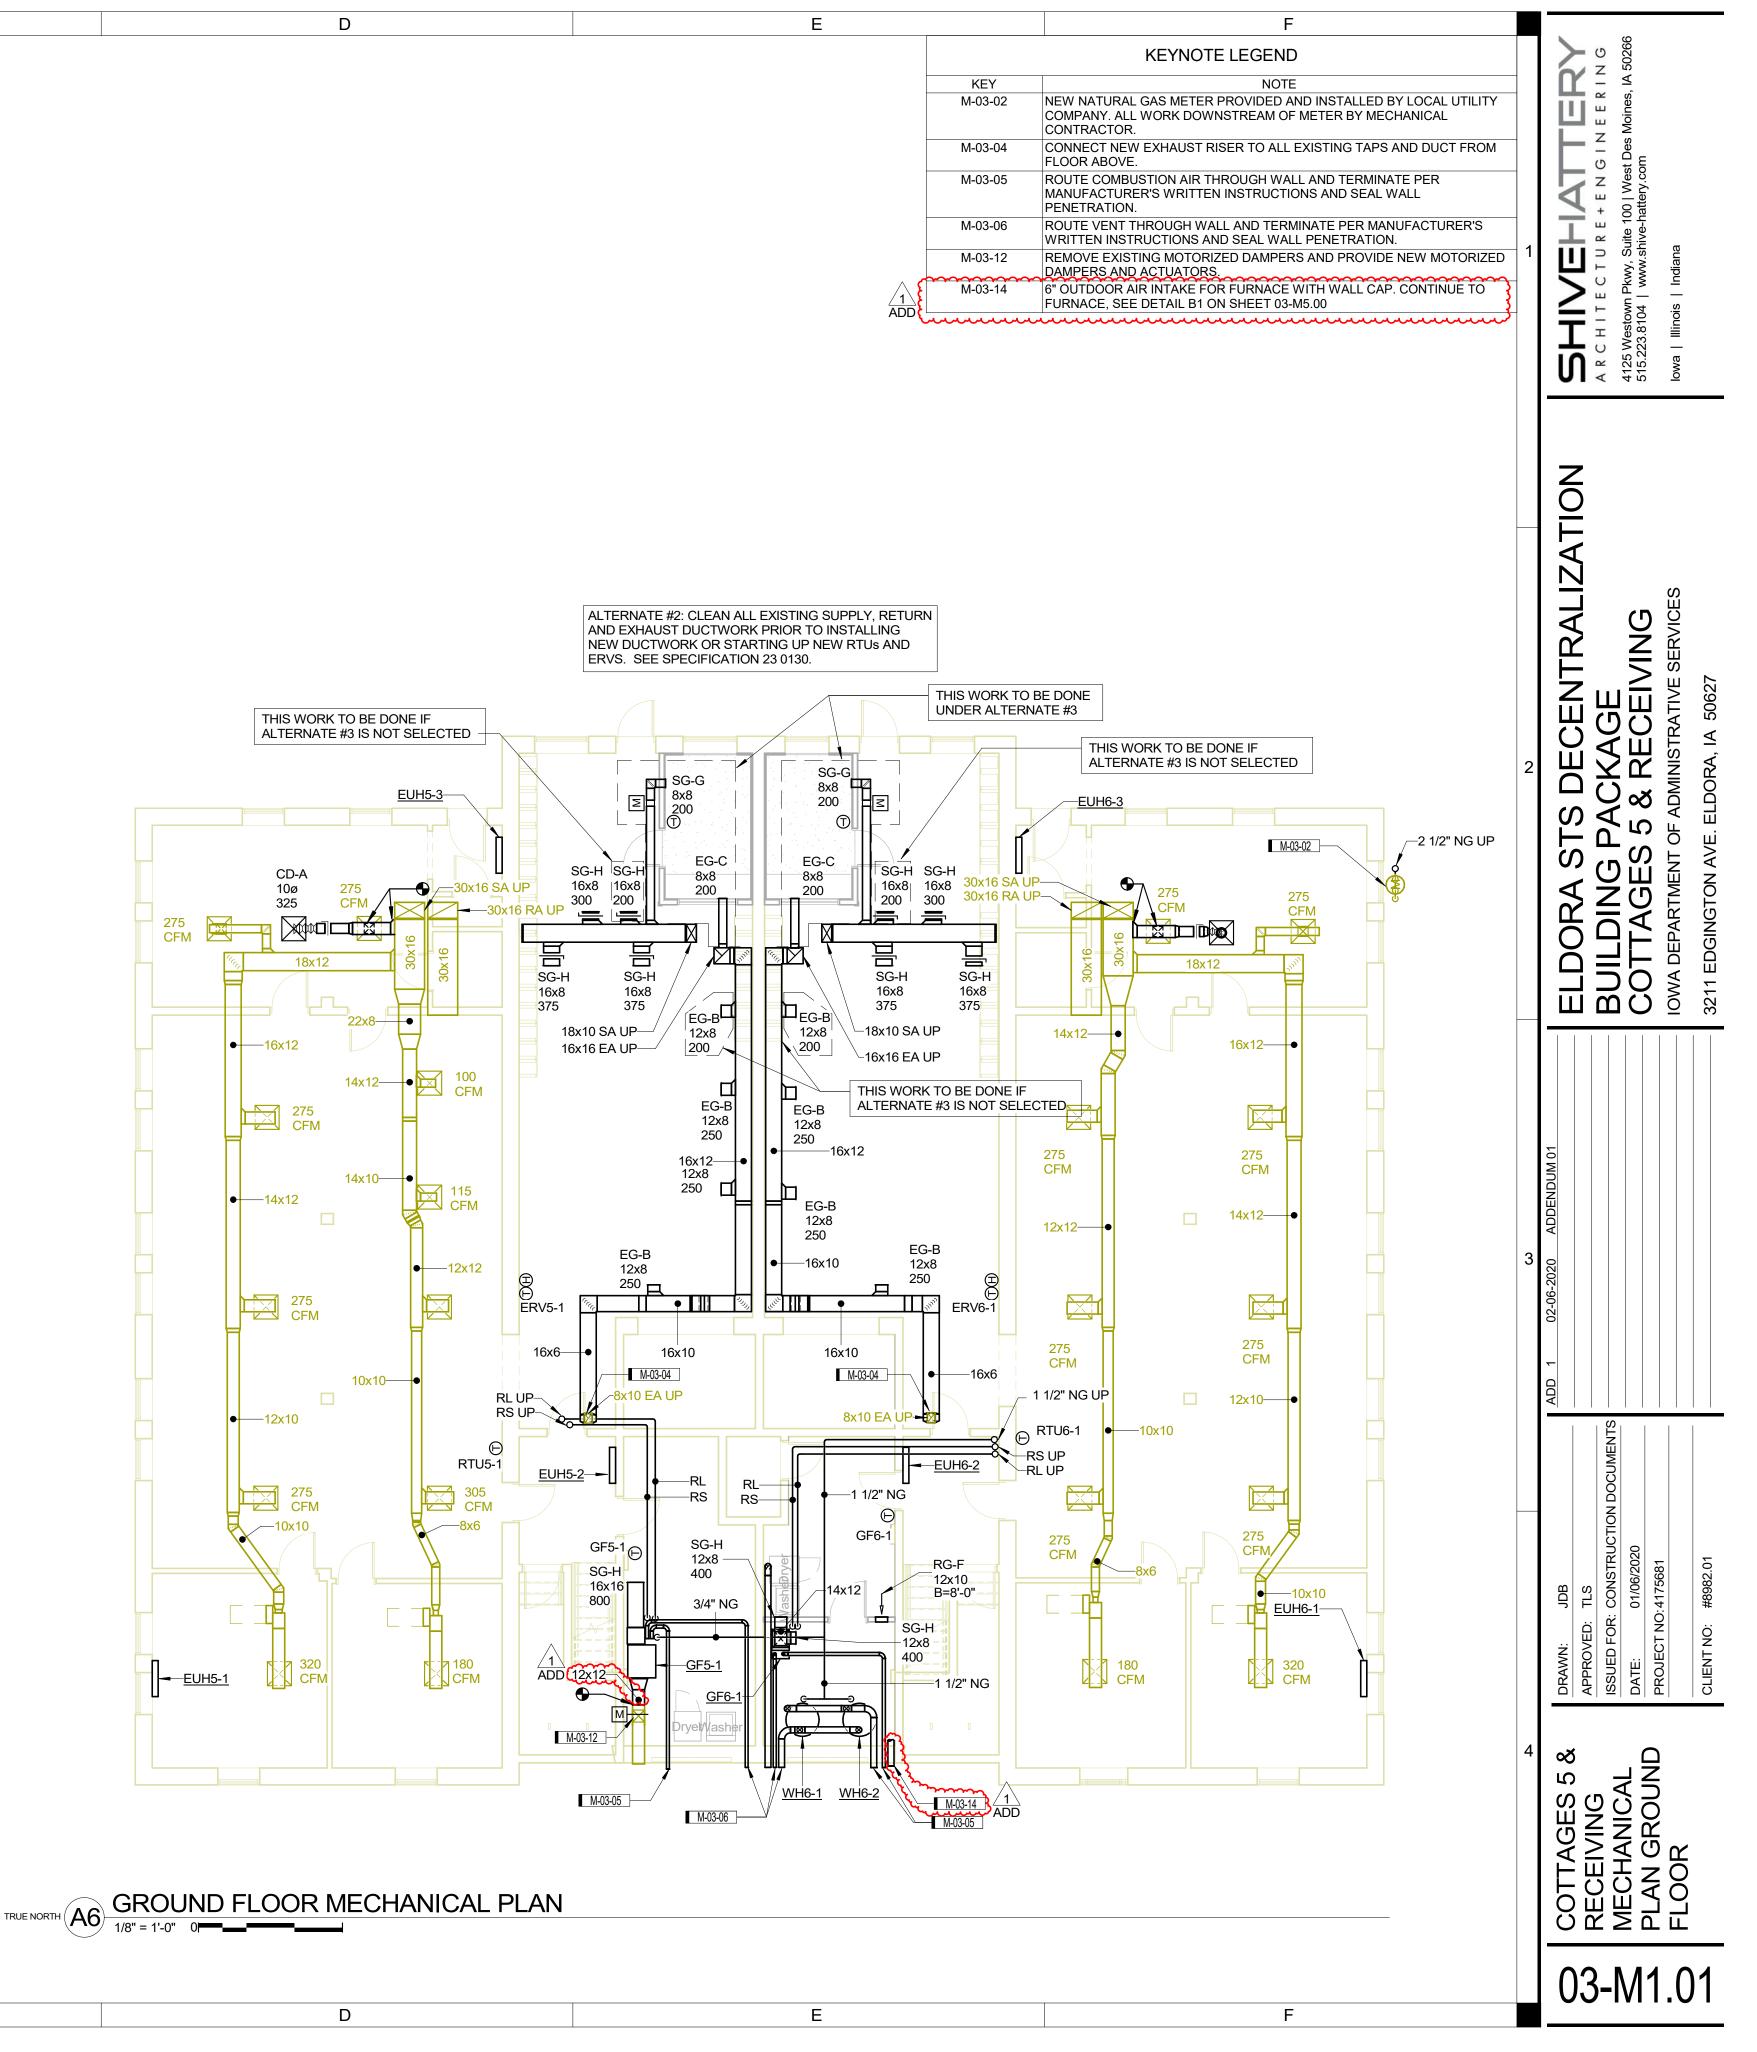


С


PLAN NORTH

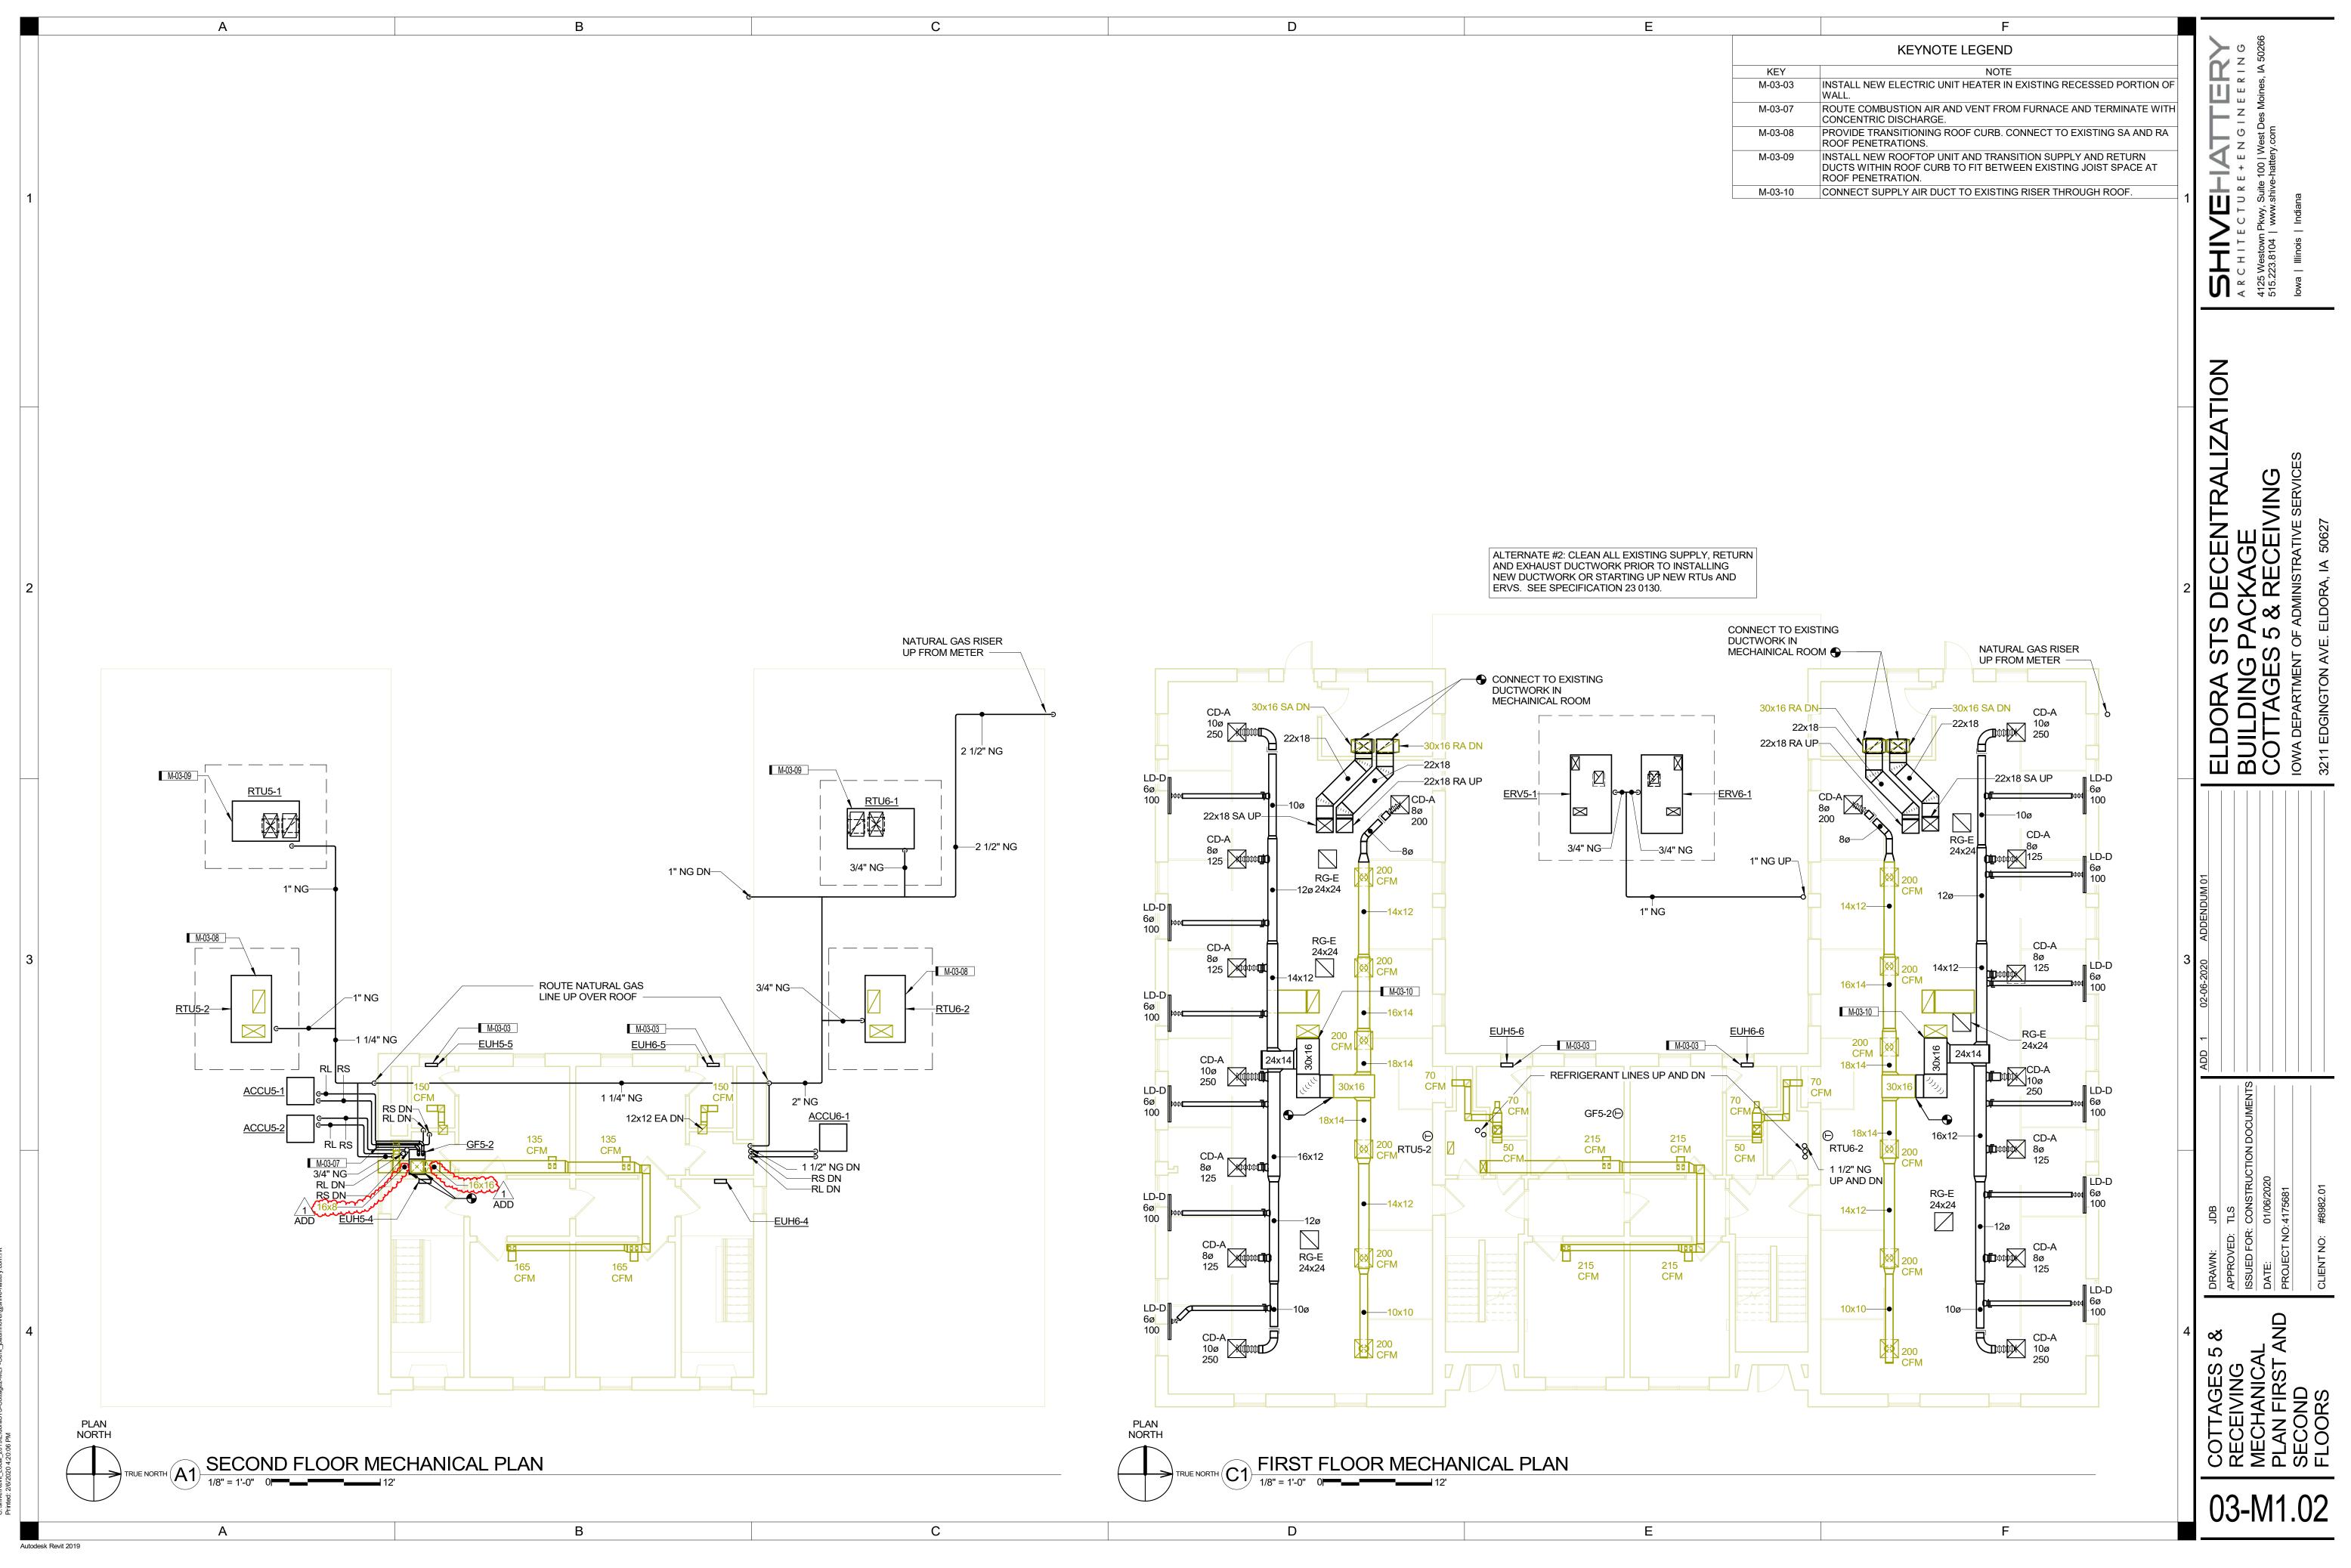

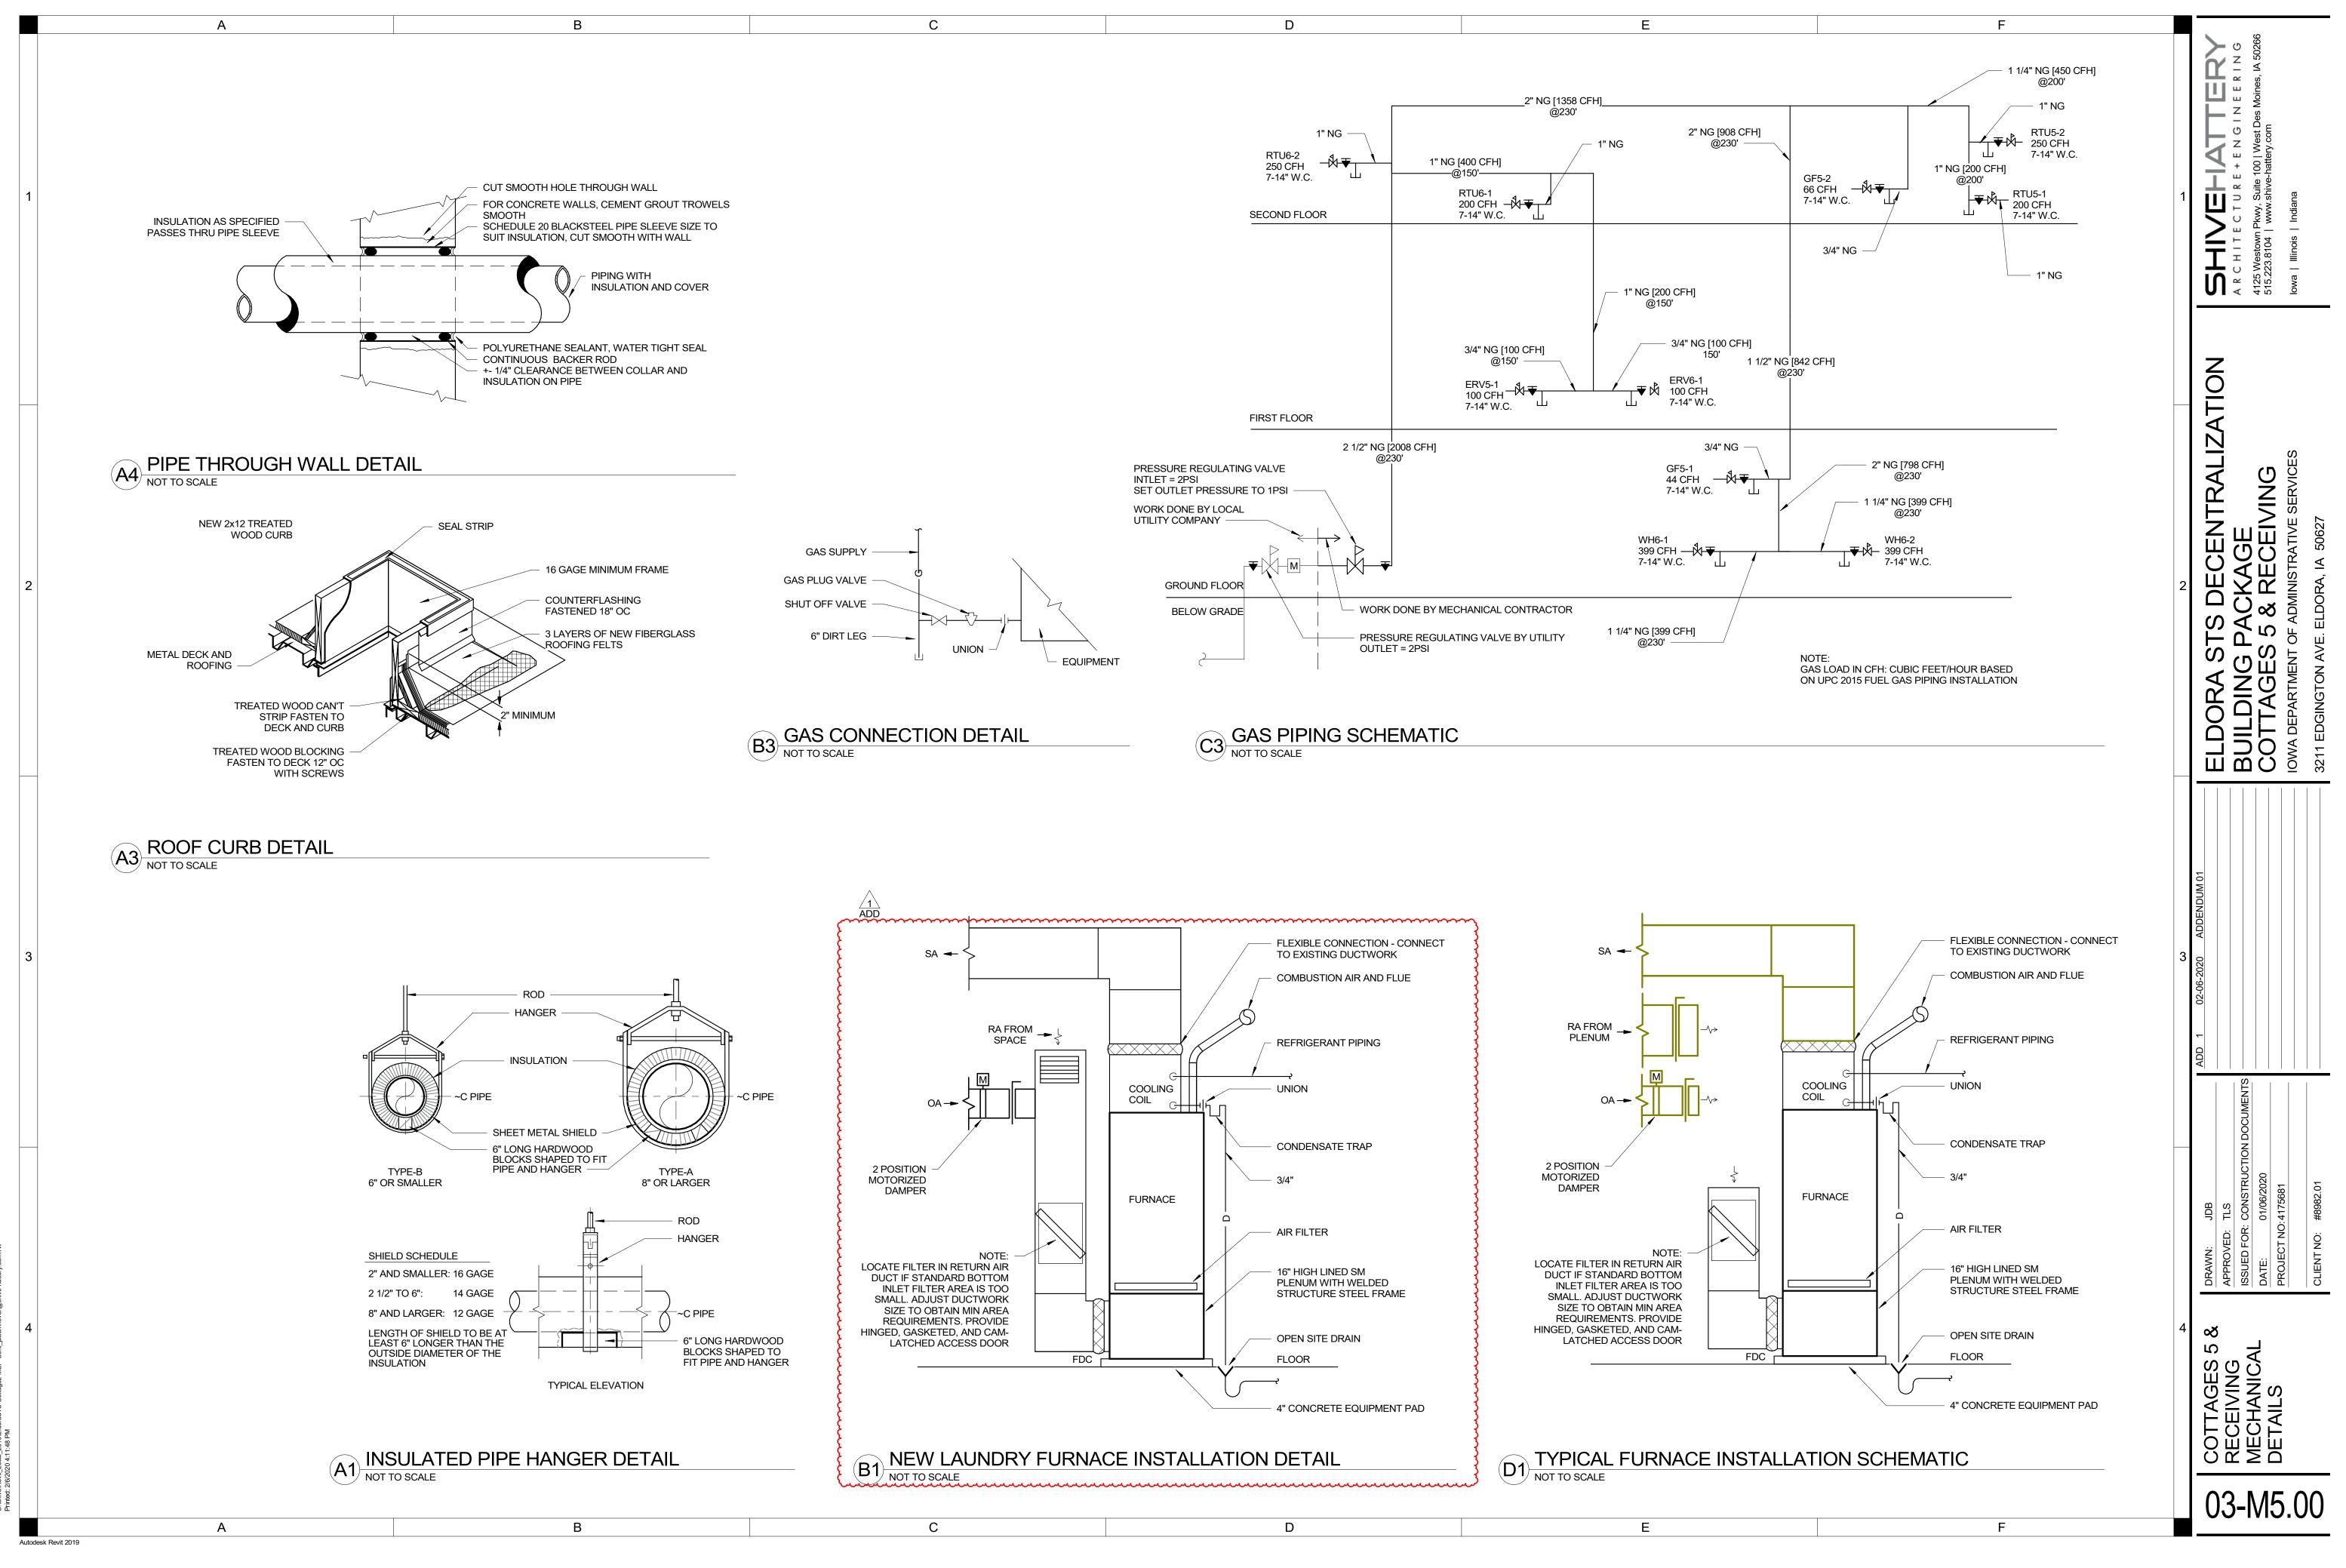

	A	B
1	AV - Exhaust Air Temp EA BV - Exhaust Fan Status BV - Exhaust Fan Status BV - Exhaust Fan Statt/Stop Starter AV - Outside Air Humidity AV - Outside Air Temp AV - Outside Air Temp	AV - Return Air Humidity AV - Return Air Temp AV - Filter Differential Pressure AV - Filter Differential Pressure RA BV - Enthalpy Wheel Status BV - Supply Fan Start/Stop AV - Supply Fan VFD Speed BV - Supply Fan VFD Speed BV - Supply Fan VFD Fault AV - Enthalpy Wheel Discharge Air Temp AV - Enthalpy Wheel Discharge Air Temp AV - Enthalpy Wheel Discharge Air Temp BV - Discharge Air Temp BV - Enthalpy Wheel Discharge Air Temp AV - Enthalpy Wheel Discharge Air Temp AV - Enthalpy Wheel Discharge Air Temp BV - Discharge Air Temp BV - Enthalpy Wheel Discharge Air Temp AV - Enthalpy Wheel Discharge Air Temp AV - Enthalpy Wheel Discharge Air Temp BV - Discharge Air Temp
2	MANUFACTURER. SCHEMATIC ABOVE IS THE MINIMUM INFORMATION TO DISPLAY ON THE SCHEMATIC BUT AVAILABLE FOR INTEGRATION ARE NOT REQUIRED TO	AV - Modulating Heat INTO CONTROLS GRAPHICS AS SHOWN ABOVE. AVAILABLE POINTS AND NAMES O GRAPHIC. INTEGRATE ALL OTHER AVAILABLE POINTS FOR DIAGNOSTIC PURPOSE BE ON A GRAPHIC AND MAY BE DISPLAYED IN A LIST. JETPOINTS AND SCHEDULES. COORDINATE SETPOINT TEMPERATURES AND SCHE
3	Elec       Image:	The heating shall be enabled whenever: Outside air temperature is less than 65°F (adj.). AND the zone temperature is below heating setpoint. DL es: pint by a user definable amount (adj.).
4	The furnace shall operate the heating or cooling using factory controls. The BAS s factory controls based on zone temperature setpont and mode. Zone Mode Adjust: The occupant shall be able to adjust the zone mode (heat or cool) at the zone sens Zone Setpoint Adjust: The occupant shall be able to adjust the zone temperature heating and cooling set Zone Optimal Start: The unit shall use an optimal start algorithm for morning start-up. This algorithm sh down period while still achieving comfort conditions by the start of scheduled occup Zone Unoccupied Override: A timed local override control shall allow an occupant to override the schedule and adjustable period of time. At the expiration of this time, control of the unit shall auto Supply Fan: The supply fan shall run continuously during occupied modes, unless shutdown on If Optimal Start Up is available, the outside air damper shall close and the return ai Minimum Outside Air Ventilation: The outside air dampers shall open during building occupied hours and be closed of minimum outside airflow with manual damper.	Apystem shall send heat or cool requests to the sor. points at the zone sensor. Hall minimize the unoccupied warm-up or cool- bied period. place the unit into an occupied mode for an matically return to the schedule. I safeties. r damper shall open. during unoccupied hours. Balancer to set
Autoda	A A	В

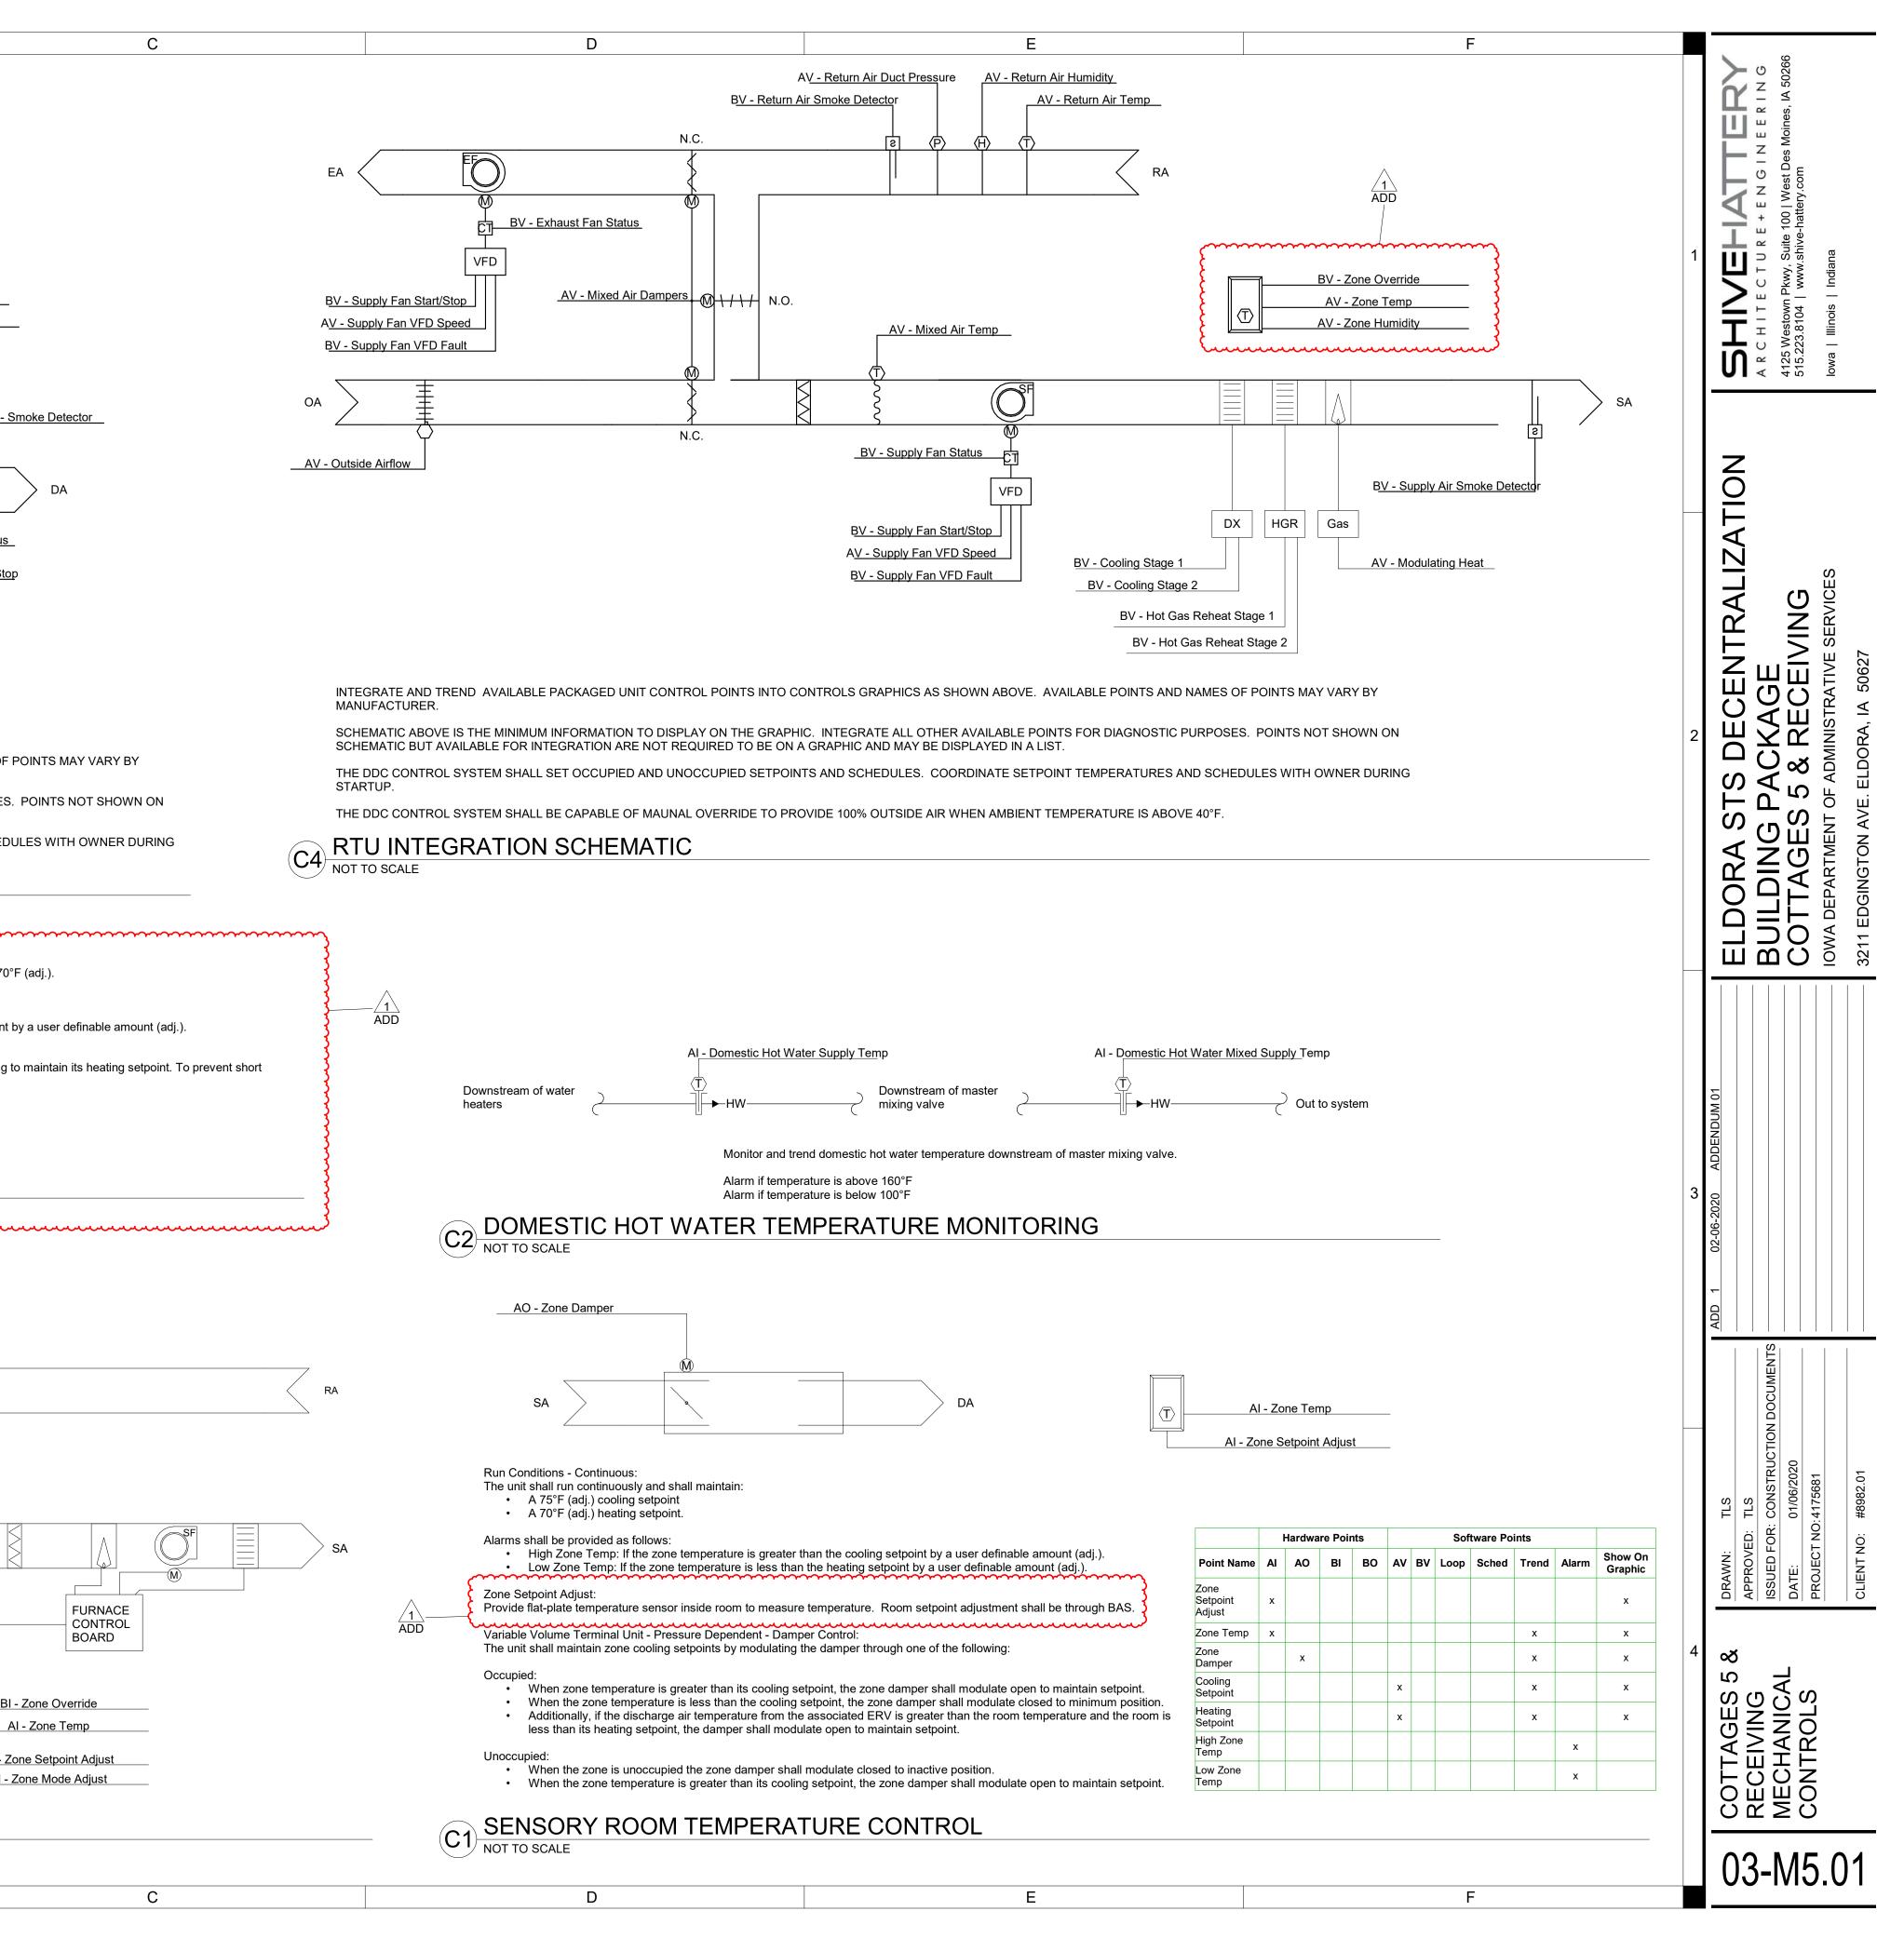

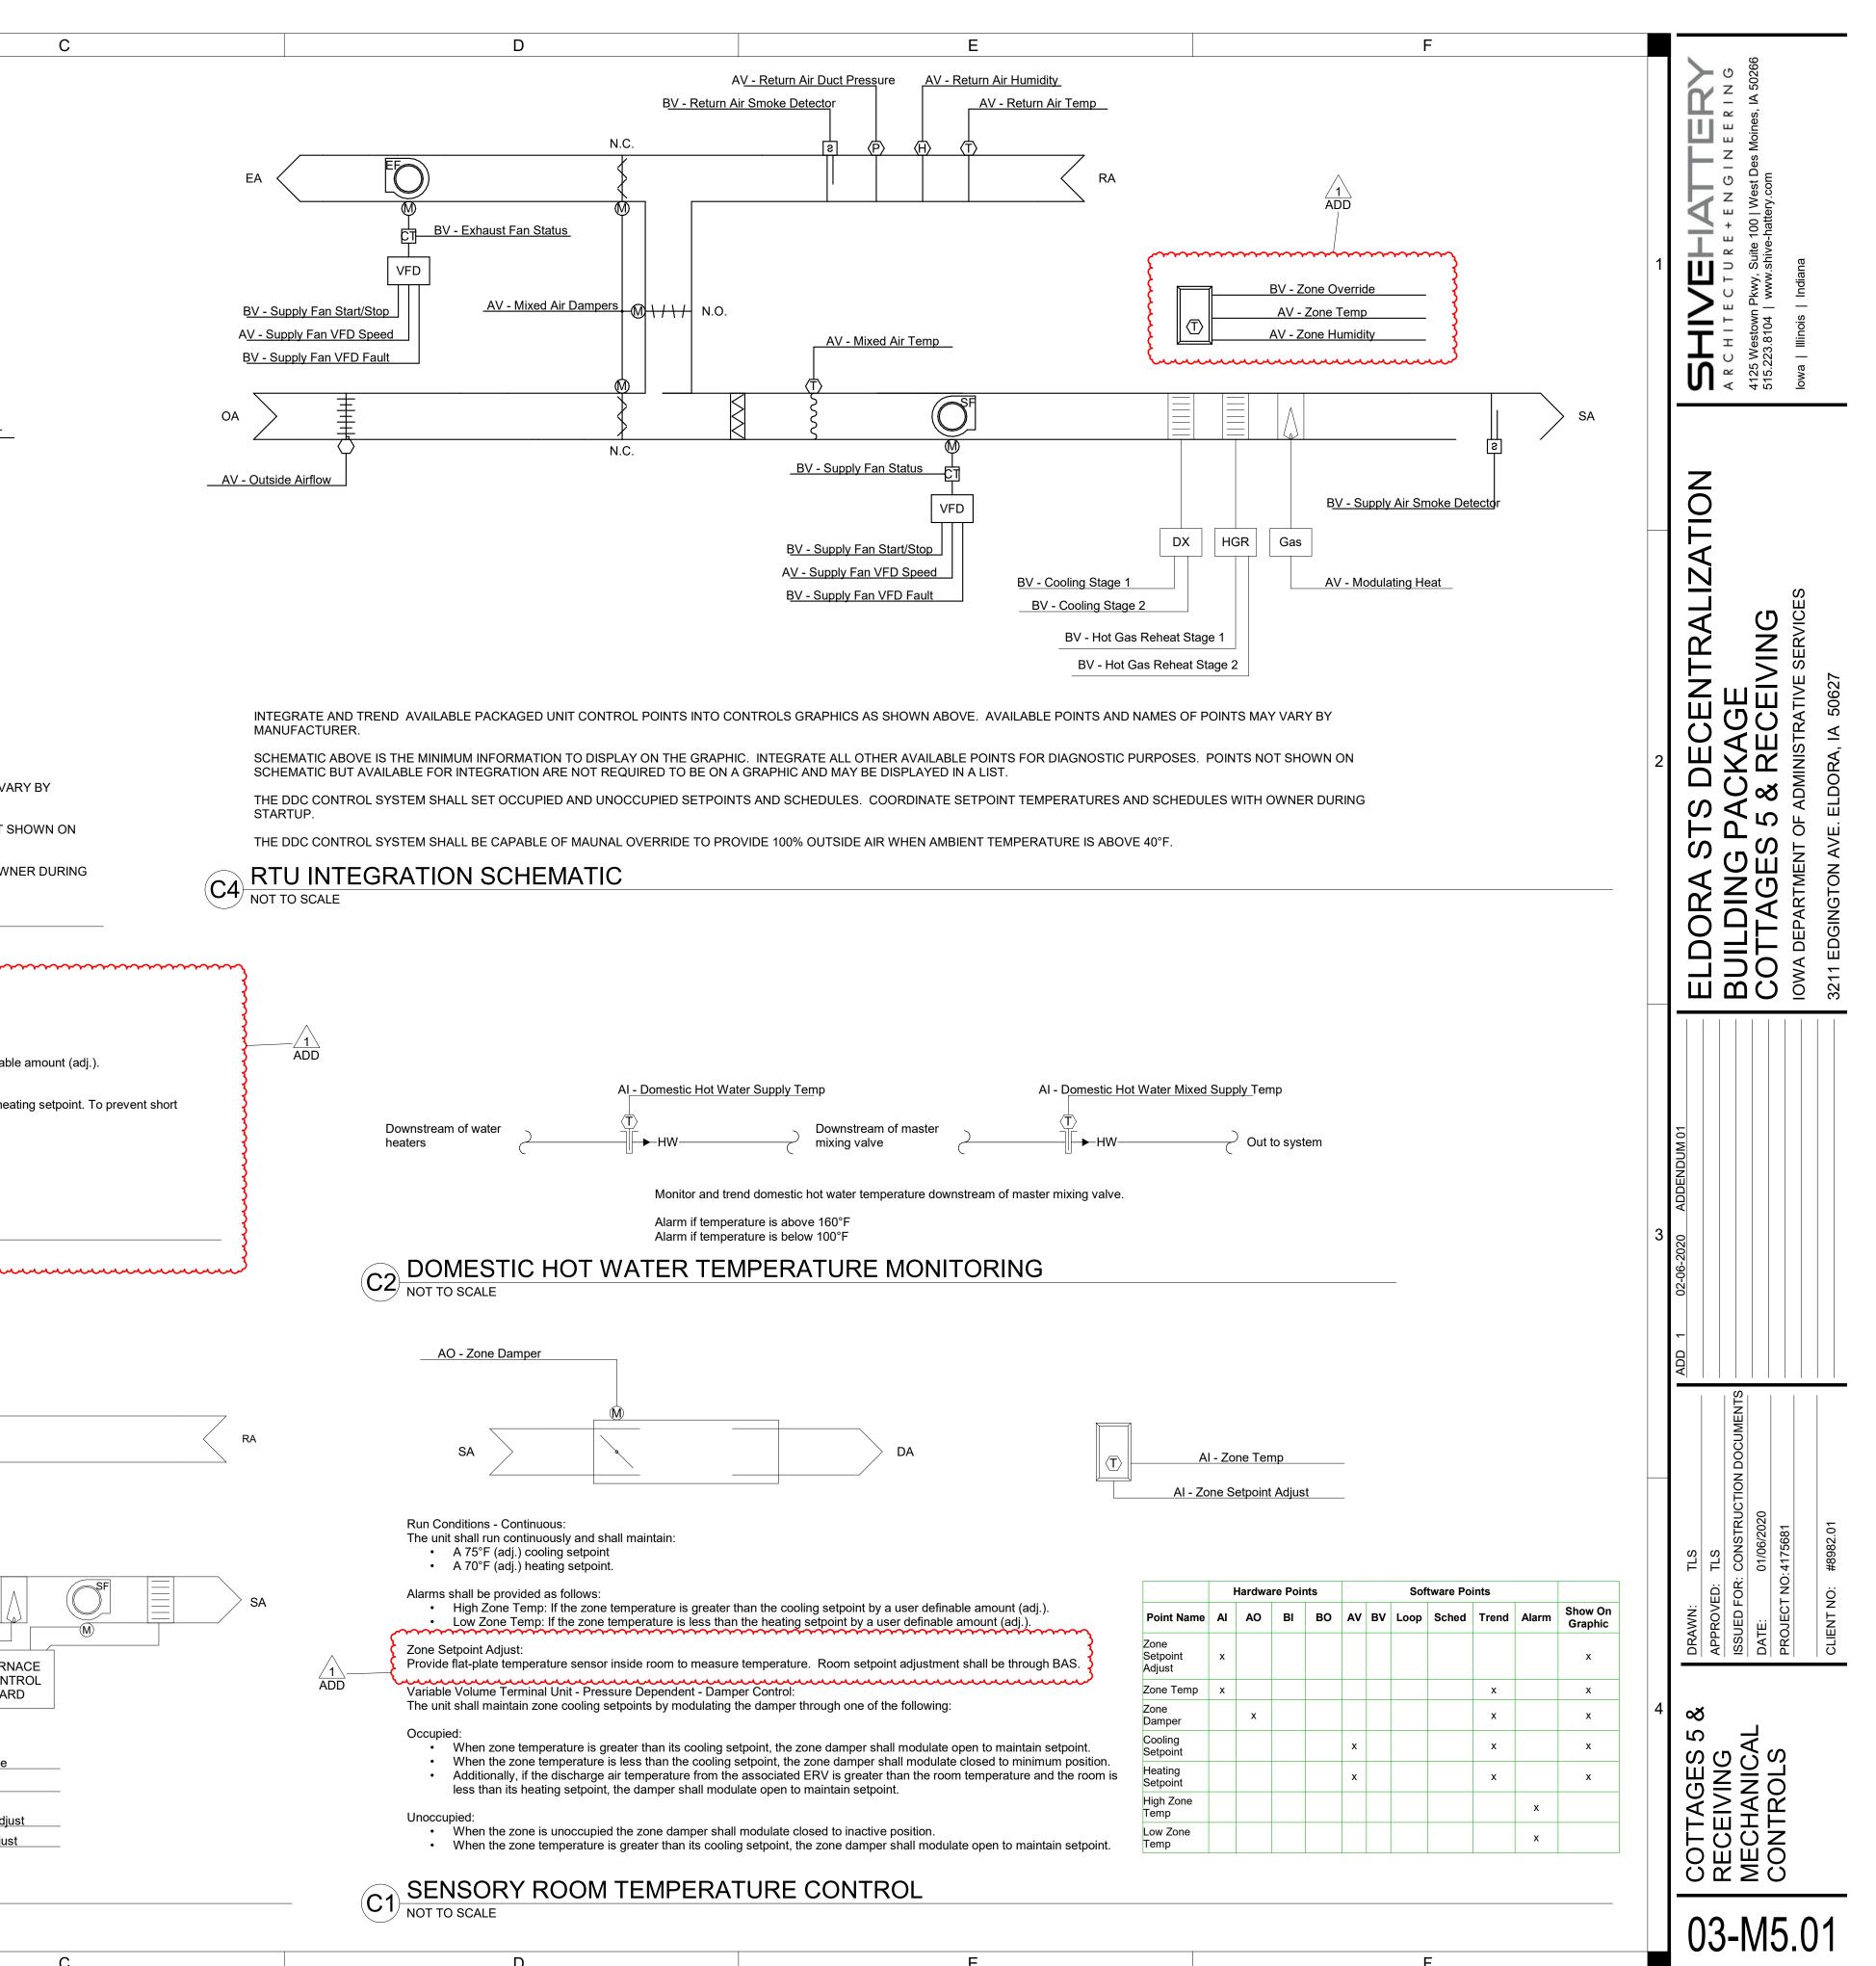



В


1. DISCONNEC	I SWITCH TO B	BE PROVIDED AND INS	STALLED BY ELECTR	ICAL CONTRACTOR.												
					MINIMUM OPERATING AMBIENT TEMPERATURE					E	LECTRICAL DAT	A				
MARK	LOCATION	SYSTEM SERVED	CAPACITY (MBH)	COND AMBIENT AIR TEMP (°F)	(°F)	STEPS OF UNLOAD	ING NUMBER OF CIRCUITS	NUMBER OF COMPRESSORS	SEER	VOLTS	PHASE	MCA	OPERATING WEIGHT	REFRIGERANT TYPE	DESIGN BASIS	REMARKS
ACCU5-1	ROOF	GF5-1	24	95	45	1	1	1	20	208	2	19	243.00	R-410A	LENNOX XC20-024	
ACCU5-2	ROOF	GF5-2	46	95	45	2	1	1	15	208	3	20	288.00	R-410A	LENNOX SSB048H4	
ACCU6-1	ROOF	GF6-1	21	95	45	1	1	1	20	208	2	19	243.00	R-410A	LENNOX XC20-024	

NOTES:

А

А

		SUP	PPLY FAN	DATA		EX	HAUST	FAN D	DATA					ç	SUMME	R OPER	RATION						COOLIN	G COIL							WI	NTER O	PERATIO	N			HEATING C	OIL			ELECT	RICAL D	ATA		
											OUTSI	IDE AIR	RE	TURN A		EMPER											C	UTDOO	OR AIR	RETUR		TEMP	ERED AIF	2											
		E	SP (IN				ESP (II	N			E.	AT		EAT		AIR LA	Т		TOTAL	COIL	EAT	COI	LLAT	TOTAL	. SENSIB	BLE		EAT	Г	EA	AT		LAT		TOTAL	HEATING COI	IL HEATING COII		OUTPU	т					
MA	RK CFI	M	WC)	BHP	HP	CFM	WC)	Bł	HP   I	ΗP	DB	WB	DE	3   W	B   C	DB   V	WB EFFEC	CTIVENESS	REC MBH	DB	WB	DB	WB	MBH	MBH	COIL	APD	DB	WB	DB	WB	DB	WB	EFFECTIVENES	S REC MB	H EAT (DB)	LAT (DB)	(MBH)	(MBH)	VOL	TS PHA	SE MO	A MOC	P DESIGN BASIS	REMARKS
ER\	5-1 125	50	0.75	0.73 (	).75	1250	0.75	0.	80   1	.00	95	78	72	2 6	7 C	76	65	79	71.0	76 °F	65 °F	52 °F	52 °F	48.5	33.2	0.28	in-wg	-10	-11	72	56	58	47	81.7	91.4	58 °F	110 °F	100	80	208	3 3	3	6 50	GREENHECK ERCH-20	)
ER\	6-1 125	50	0.75	0.73 (	).75	1250	0.75	0.	80 1	.00	95	78	72	2 6	7 C	76	65	79	71.0	76 °F	65 °F	52 °F	52 °F	48.5	33.2	0.28	in-wg	-10	-11	72	56	58	47	81.7	91.4	58 °F	110 °F	100	80	208	3 3	3	6 50	GREENHECK ERCH-20	)

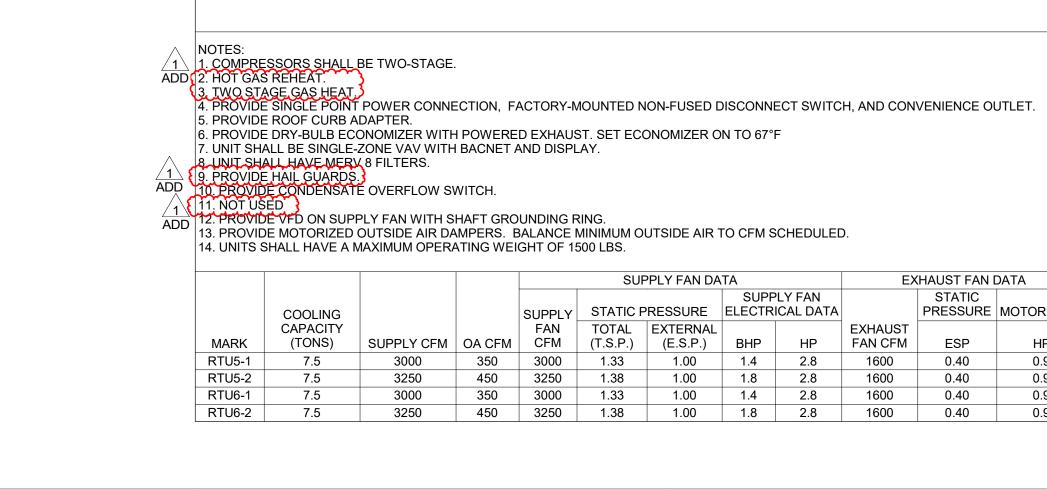

В

Autodesk Revit 2019

Е

NOTE:

		DIFFUSERS REGI	STERS AND	GRILLES SU	JHEDULE	
MARK	MATERIAL	DESCRIPTION	FACE SIZE	FACTORY FINISH	DESIGN BASIS	REMARKS
CD-A	STEEL		24"x24"			
EG-B	STEEL	LONG BLADE	SEE PLANS	WHITE	TITUS 350FL	
EG-C	ALUMINUM	PERFORATED ANTI LIGATURE	SEE PLANS	WHITE	BEHAVIORAL SAFETY PRODUCTS EG450	
LD-D	ALUMINUM	LINEAR DIFFUSER	2" SLOT	WHITE	TITUS FL-20	
RG-E	STEEL	EGGCRATE	24"x24"	WHITE	TITUS 50F	
RG-F	STEEL	LONG BLADE	SEE PLANS	WHITE	TITUS 350FL	
SG-G	ALUMINUM	PERFORATED ANTI LIGATURE	SEE PLANS	WHITE	BEHAVIORAL SAFETY PRODUCTS EG450	
SG-H	STEEL	DOUBLE DEFLECTION	SEE PLANS	WHITE	TITUS 272FL	

# UNIT HEATER SCHEDULE - ELECTRIC

NOTES:

1. DISCONNECT	SWITCH TO B	E PROVIDED AND	INSTALLED BY	ELECTRICAL CO	ONTRACTOR.					
				MOUNTING		E	LECTRICAL DAT	A		
MARK	CFM	EAT (°F)	KW	HEIGHT (FT)	ORIENTATION	VOLTS	PHASE	FLA	DESIGN BASIS	REMARKS
EUH5-1	100	50	1.5	0' - 0"	HORIZONTAL	120	1	13	BERKO VFK151F	
EUH5-2	100	50	4	0' - 0"	HORIZONTAL	208	1	19	BERKO VFK408F	
EUH5-3	100	50	1.5	2' - 0"	HORIZONTAL	120	1	13	BERKO VFK151F	
EUH5-4	100	50	4	0' - 0"	HORIZONTAL	208	1	19	BERKO VFK408F	
EUH5-5	100	50	1.5	2' - 0"	HORIZONTAL	120	1	13	BERKO VFK151F	
EUH5-6	100	50	1.5	2' - 0"	HORIZONTAL	120	1	13	BERKO VFK151F	
EUH6-1	100	50	1.5	0' - 0"	HORIZONTAL	120	1	13	BERKO VFK151F	
EUH6-2	100	50	4	0' - 0"	HORIZONTAL	208	1	19	BERKO VFK408F	
EUH6-3	100	50	1.5	2' - 0"	HORIZONTAL	120	1	13	BERKO VFK151F	
EUH6-4	100	50	4	0' - 0"	HORIZONTAL	208	1	19	BERKO VFK408F	
EUH6-5	100	50	1.5	2' - 0"	HORIZONTAL	120	1	13	BERKO VFK151F	
EUH6-6	100	50	1.5	2' - 0"	HORIZONTAL	120	1	13	BERKO VFK151F	

### AIR COOLED CONDENSING UNIT SCHEDULE

D

								FUF	RNACE - C	GAS SCH	IEDULE								
ROVIDE DI	CT SWITCH TO BE PROVID IRECT DRIVE FAN WITH E ND INSTALL CONDENSATE	C MOTOR A	AND 2-ST	AGE HEA	TING OPERATIO	N.	OR DRAIN.												
				ESP (IN			COIL DATA				HEA	TING DATA			ELE	ECTRICAL	DATA	-	
MARK	AREA SERVED	OA CFM	CFM	ESP (IN WC)	TOTAL MBH	COOLING EAT DB (°F)	COIL DATA	MODEL	EAT (°F)	LAT (°F)	HEA <sup>-</sup>	TING DATA THERMAL EFFICIENCY	MINIMUM GAS PRESSURE	AFUE	ELE	ECTRICAL VOLTS	DATA PHASE	DESIGN BASIS	REMARK
	AREA SERVED COTTAGE 5 LAUNDRY	OA CFM 100	CFM 800		TOTAL MBH 24	EAT DB		MODEL CX35-24B	EAT (°F) 60	LAT (°F) 95		THERMAL		AFUE 96				DESIGN BASIS LENNOX EL296UH045XV36B	REMAR
MARK GF5-1 GF5-2			-	WC)		EAT DB	LAT DB (°F)		· · · · ·	( )	INPUT MBH	THERMAL EFFICIENCY	PRESSURE	-	HP	VOLTS			REMAR

### ENERGY RECOVERY VENTILATOR SCHEDULE

### PACKAGED ROOFTOP UNIT SCHEDULE

С

		EX	XHAUST FAN	DATA				CC	oling (	COIL					HEATING	COIL			ELECTRICAL	ΔΑΤΑ			
	PLY FAN ICAL DATA		STATIC PRESSURE	MOTOR DATA		EAT	- (°F)	LAT	(°F)							GAS							
		EXHAUST								REFRIGERAN		SENSIBLE	EAT DB	LAT DB	INPUT	OUTPUT	THERMAL						
3HP	HP	FAN CFM	ESP	HP	TYPE	DB	WB	DB	WB	T TYPE	MBH	MBH	(°F)	(°F)	(MBH)	(MBH)	EFFICIENCY	MCA	MOCP	VOLTS	PHASE	DESIGN BASIS	REMARKS
1.4	2.8	1600	0.40	0.9	DX	78	66	58	56	R-410A	86	62	59	96	150	120	80	47	60	208	3	TRANE YHC092F3RMA	
1.8	2.8	1600	0.40	0.9	DX	80	67	60	58	R-410A	88	64	54	99	200	160	80	47	60	208	3	TRANE YHC092F3RHA	
1.4	2.8	1600	0.40	0.9	DX	78	66	58	56	R-410A	86	62	59	96	150	120	80	47	60	208	3	TRANE YHC092F3RMA	
1.8	2.8	1600	0.40	0.9	DX	80	67	60	58	R-410A	88	64	54	99	200	160	80	47	60	208	3	TRANE YHC092F3RHA	

Е

С

D

EQUIVALENT PRODUCTS BY MANUFACTURERS WHICH ARE NOT LISTED IN SCHEDULES OR IN SPECIFICATIONS MAY BE USED WITH PRE-APPROVAL FROM ENGINEER. SEE SPECIFICATIONS FOR SUBSTITUTION REQUEST INSTRUCTIONS.

F

F

	4		3	2	1
		-	ADD 1 02-06-2020 ADDENDUM 01		
С	COTTAGES 5 &	DRAWN: JDB		TEL DORA STS DECENTRALIZATION	
)3		APPROVED: TLS			
3-	SNIVIDORY RECEIVING				A R C H I T E C T U R E + E N G I N E E R I N G
•		ISSUED FOR: CONSTRUCTION DOCUMENTS			
M		DATE: 01/06/2020			4125 Westown Pkwy, Suite 100   West Des Moines, IA 50266
6	SCHEDULES				0.0.777.0.0 104   MMM.31146-11811617.0011
).				IOWA DEPARTMENT OF ADMINISTRATIVE SERVICES	lowa   Illinois   Indiana
0					
С		CLIENT NO: #8982 01			
)					

ibaumhover@shive-hatterv.com.rvt	
1 2019/FldoraSTS-Cottage3-MEP-Cent	
009	
shive\Revit	

Autodesk Revit 2019

А


	A		В	
1	1			
2	2			
3	3			
2	4			


В



С




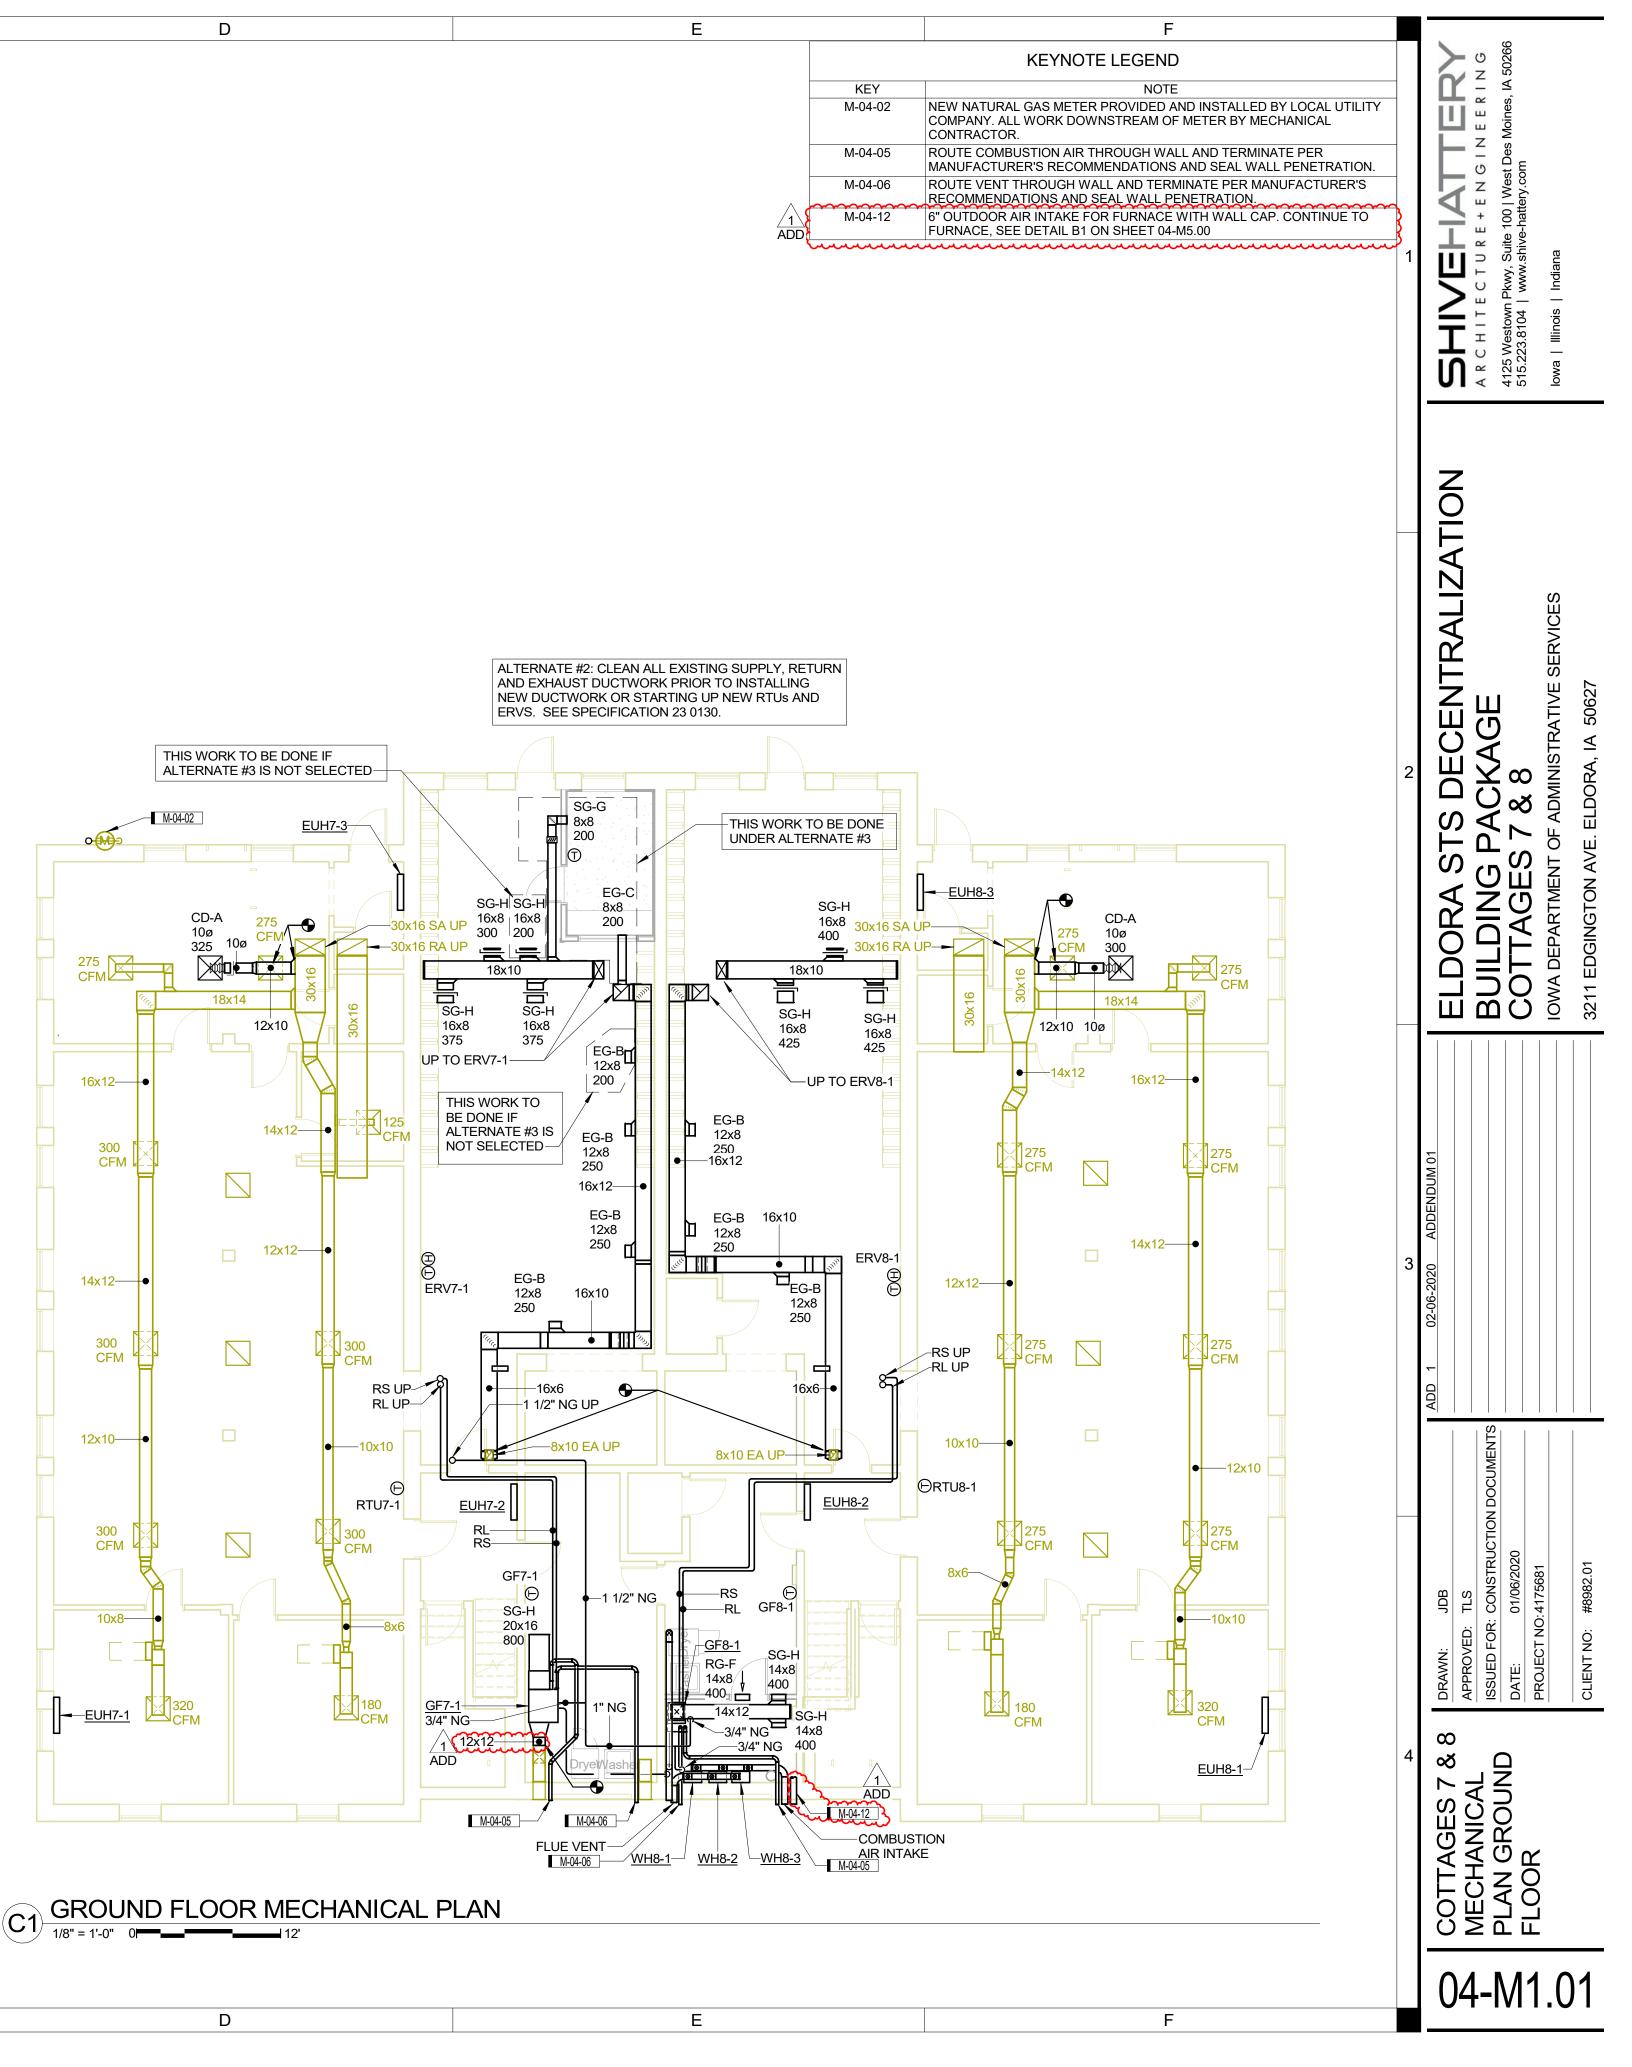

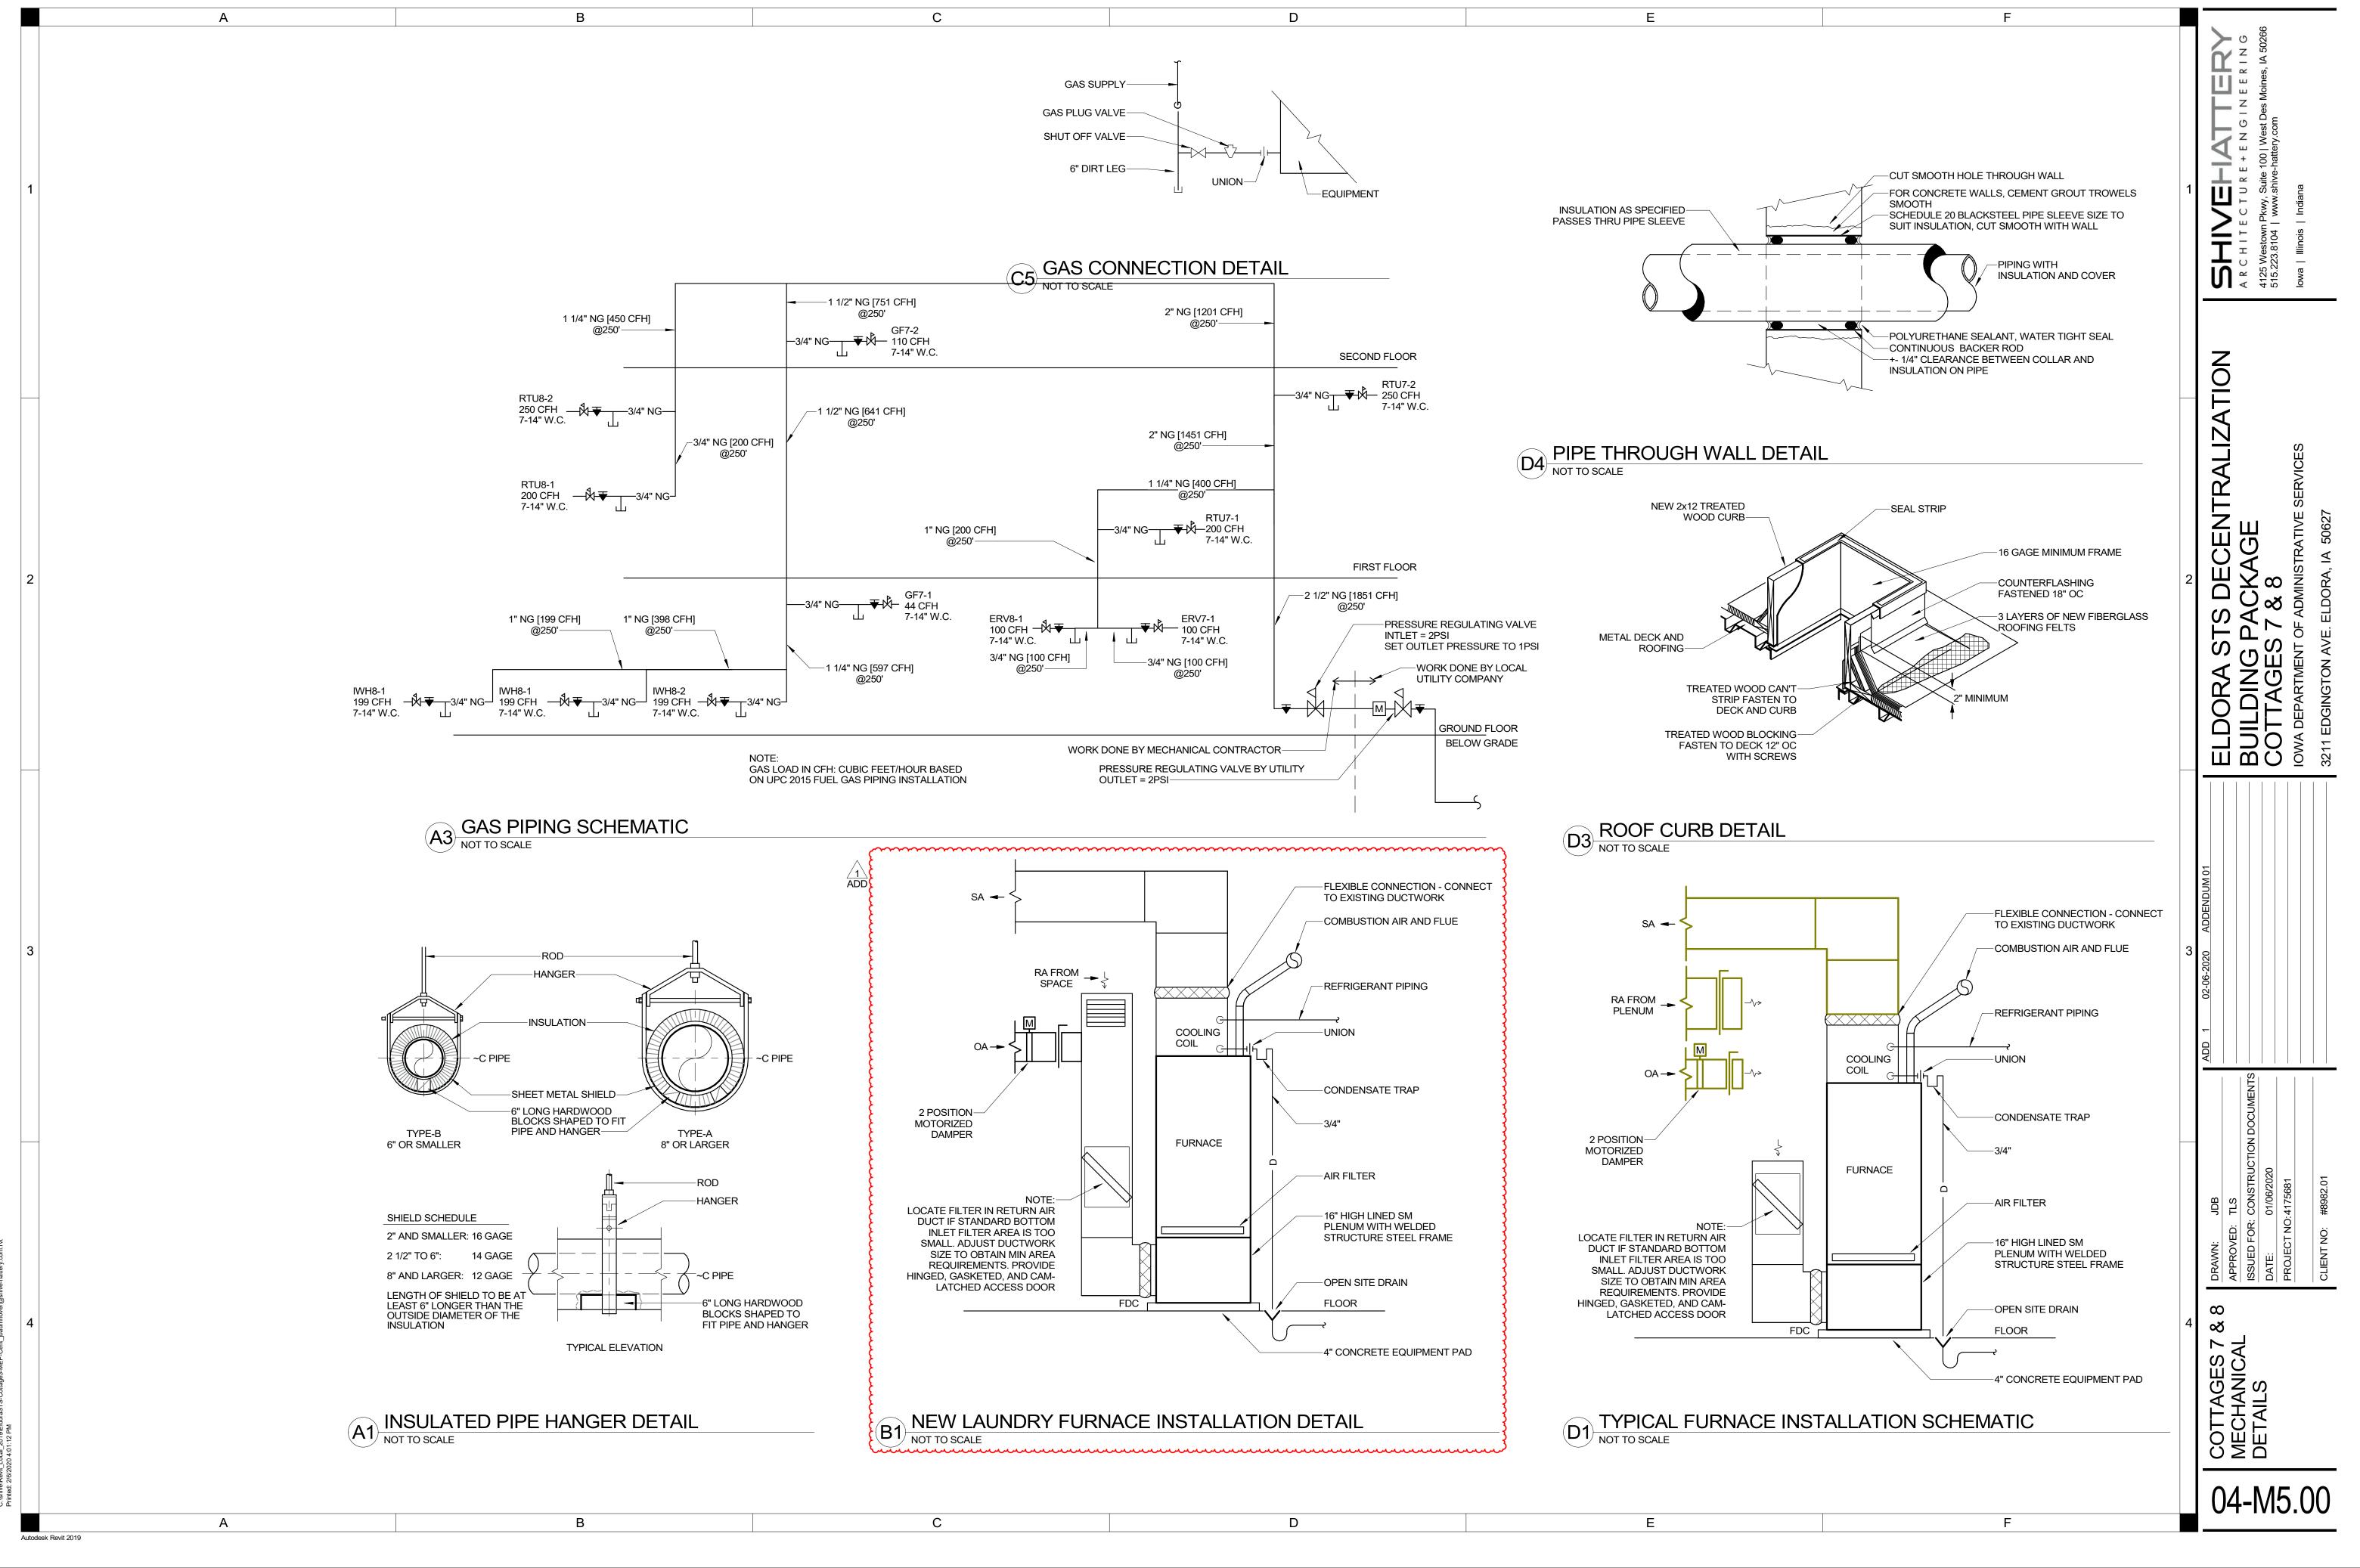


	A B
	AV - Exhaust Air Temp AV - Exhaust Air Temp AV - Filter Differential Pressure H T H L RA
1	BV - Exhaust Fan Status       CI         BV - Exhaust Fan Start/Stop       Starter         BV - Exhaust Fan Start/Stop       Starter         AV - Outside Air Humidity       AV - Outside Air Temp         AV - Filter Differential Pressure       AV - Enthalpy Wheel Discharge Air Humidity
	BV - Outside Air Damper Status BV - Outside Air Damper BV - Outside Air Damper OA N.C.
	AV - Zone Humidity AV - Zone Temp Gas AV - Digital Compressor
2	INTEGRATE AND TREND AVAILABLE PACKAGED UNIT CONTROL POINTS INTO CONTROLS GRAPHICS AS SHOWN ABOVE. AVAILABLE POINTS AND NAMES OF POINT MANUFACTURER. SCHEMATIC ABOVE IS THE MINIMUM INFORMATION TO DISPLAY ON THE GRAPHIC. INTEGRATE ALL OTHER AVAILABLE POINTS FOR DIAGNOSTIC PURPOSES. POIN SCHEMATIC BUT AVAILABLE FOR INTEGRATION ARE NOT REQUIRED TO BE ON A GRAPHIC AND MAY BE DISPLAYED IN A LIST. THE DDC CONTROL SYSTEM SHALL SET OCCUPIED AND UNOCCUPIED SETPOINTS AND SCHEDULES. COORDINATE SETPOINT TEMPERATURES AND SCHEDULES I STARTUP.
	Elec       Image: Construction of the stage
3	ELECTRIC UNIT HEATER CONTROL NOT TO SCALE Furnaces Run Conditions - Scheduled: The unit shall run according to a user definable time schedule in the following modes: Occupied Mode: The unit shall maintain A 75°F (adj.) cooling setpoint A 70°F (adj.) heating setpoint. Unoccupied Mode (night setback): The unit shall maintain A 85°F (adj.) cooling setpoint. Alarms shall be provided as follows: High Zone Temp: If the zone temperature is greater than the cooling setpoint by a user definable amount (add).
	Low Zone Temp: If the zone temperature is less than the heating setpoint by a user definable amount (adj.). The furnace shall operate the heating or cooling using factory controls. The BAS system shall send heat or cool requests to the factory controls based on zone temperature setpont and mode. Zone Mode Adjust: The occupant shall be able to adjust the zone mode (heat or cool) at the zone sensor. Zone Setpoint Adjust: The occupant shall be able to adjust the zone temperature heating and cooling setpoints at the zone sensor. FURNACONTER
4	Zone Optimal Start: The unit shall use an optimal start algorithm for morning start-up. This algorithm shall minimize the unoccupied warm-up or cool-down period while still achieving comfort conditions by the start of scheduled occupied period. Zone Unoccupied Override: A timed local override control shall allow an occupant to override the schedule and place the unit into an occupied mode for an adjustable period of time. At the expiration of this time, control of the unit shall automatically return to the schedule. BI - Zone Temp
	Supply Fan: The supply fan shall run continuously during occupied modes, unless shutdown on safeties. If Optimal Start Up is available, the outside air damper shall close and the return air damper shall open. Minimum Outside Air Ventilation: The outside air dampers shall open during building occupied hours and be closed during unoccupied hours. Balancer to set minimum outside airflow with manual damper.
	A1a TYPICAL FURNACE CONTROL SCHEMATIC & SEQUENCE
Autode	A B desk Revit 2019



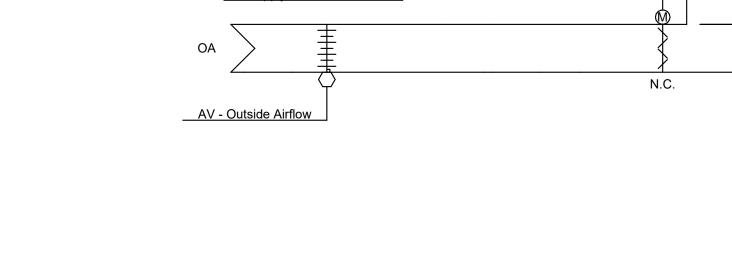

DA

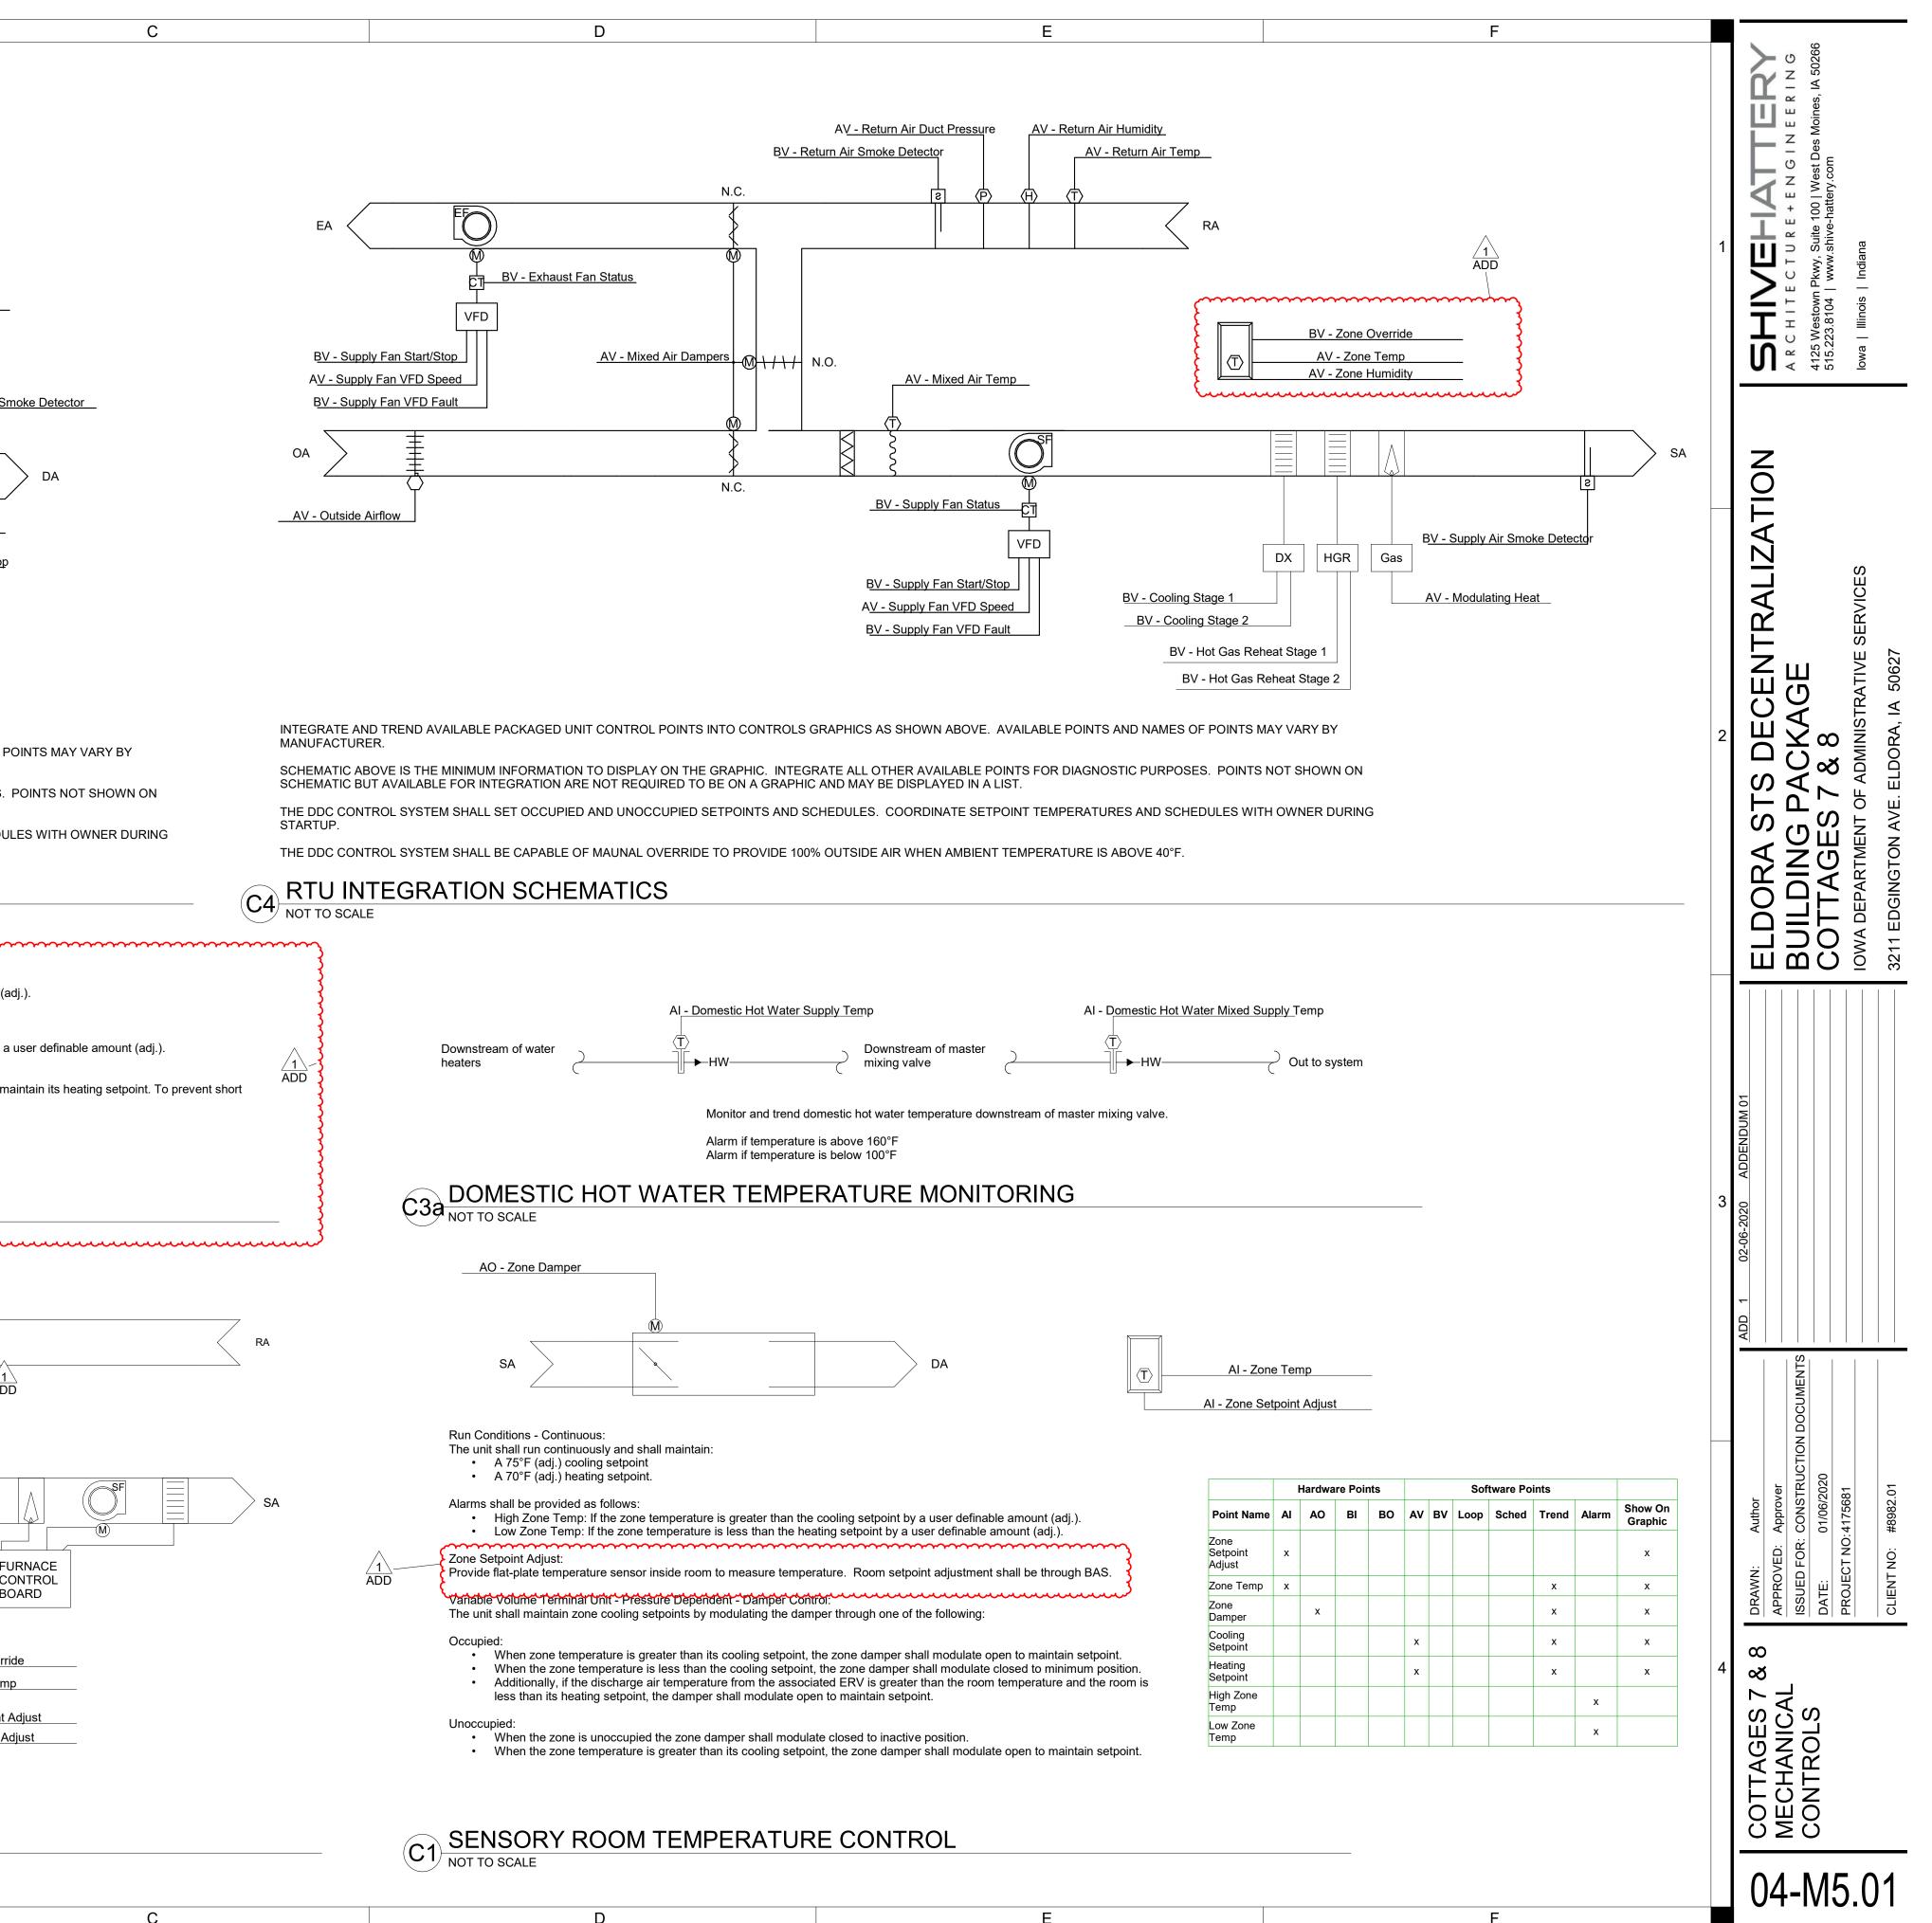


D

F



В

										E	ELECTRICAL DATA					
MARK	LOCATION	SYSTEM SERVED	CAPACITY (MBH)	COND AMBIENT AIR TEMP (°F)	MINIMUM OPERATING AMBIENT TEMPERATURE (°F)	STEPS OF UNLOADING	NUMBER OF CIRCUITS	NUMBER OF COMPRESSORS	AHRI SEER	VOLTS	PHASE	MCA	OPERATING WEIGHT	REFRIGERANT TYPE	DESIGN BASIS	REMARKS
ACCU7-1	ROOF	GF7-1	24	95	45	1	1	1	20	208	1	15	243.00	R-410A	LENNOX XC20-024	
ACCU7-2	ROOF	GF7-2	46	95	45	2	1	1	15	208	3	16	288.00	R-410A	LENNOX SSB048H4	
ACCU8-1	ROOF	GF8-1	24	95	45	1	1	1	20	208	1	15	243.00	R-410A	LENNOX XC20-024	

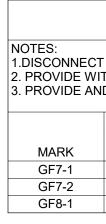

	ENERGY RECOVERY VENTILATOR SCHEDULE																																								
		SUPF	PLY FAN	I DATA		EXI	IAUST FA	AN DATA				SU	MMER C	PERATIO	N				С	OOLING	GCOIL						WIN	ITER OPE	RATION				HEATI	NG COIL			ELECTRI	CAL DATA	Ą		
									OU	TSIDE AIF				PERED											OOR AIR	RETU	RN AIR	TEMPE	RED AIR		TOTAL	HEATING		3							
		ES	P (IN				ESP (IN			EAT		EAT	AIF	RLAT	_	TOTAL	COIL	EAT	COIL I	_AT		SENSIBLE		E	AT	E	AT	L	.AT		REC	COIL EAT		Γ INPUT	OUTPUT	-					
	K CF	FM V	VC)	BHP	HP	CFM	WC)	BHP F	IP DE	B WB	DB	WB	DB	WB	EFFECTIVENESS	REC MBH	DB	WB	DB	WB	MBH	MBH	COIL APD	DB	WB	DB	WB	DB	WB	EFFECTIVENESS	MBH	(DB)	(DB)	(MBH)	(MBH)	VOLTS	PHASE	MCA	MOCP	DESIGN BASIS	REMARKS
ERV	7-1 12	250 0	.75	0.73 (	0.75	1250	0.75	0.80 1.	.00 95	5 78	72	60	76	65	79	71.0	76	65	52	52	48.5	33.2	0.28	-10	-11	72	56	58	47	81.7	91.4	58	110	100	80	208	3	36	50	<b>GREENHECK ERCH-20</b>	
ERV	3-1 12	250 0	.75	0.73 (	0.75	1250	0.75	0.80 1	.00 95	5 78	91	60	76	65	79	71.0	76	65	52	52	48.5	33.2	0.28	-10	-11	72	56	58	47	81.7	91.4	58	110	100	80	208	3	36	50	GREENHECK ERCH-20	

C:\shiveHevit_Local_2019\EldoraSTS-Cottage3-MEP-Cent_jbaumhover@shive-hattery.com.rvt Printed: 2/6/2020 4:15:53 PM	4	

Autodesk Revit 2019

	NOTES:
$\wedge$	1. COMPRESSORS SHALL BE TWO-STAGE.
	2. HÓT GÁS REHEAT.
DD	3. TWO STAGE GAS HEAT.
	4. PROVIDE SINGLE POINT POWER CONNECTION, FACTORY-MOUNTED NON-FUSED DISCONNECT SWITCH, AND CON
	5. PROVIDE ROOF CURB ADAPTER.
	6. PROVIDE DRY-BULB ECONOMIZER WITH POWERED EXHAUST. SET ECONOMIZER ON TO 67°F
$\wedge$	7. UNIT SHALL BE SINGLE-ZONE VAV WITH BACNET AND DISPLAY.
1	8. UNIT SHALL HAVE MERV 8 FILTERS.
DD	9. PROVIDE HAIL GUARDS. )
/	10 PROVIDE CONDENSATE OVERELOW SWITCH

В

А

А

10. PROVIDE CONDENSATE OVERFLOW SWITCH.
 11. NOT USED.
 ADD
 12. PROVIDE VFD ON SUPPLY FAN WITH SHAFT GROUNDING RING.
 13. PROVIDE MOTORIZED OUTSIDE AIR DAMPERS. BALANCE MINIMUM OUTSIDE AIR TO CFM SCHEDULED.
 14. UNITS SHALL HAVE A MAXIMUM OPERATING WEIGHT OF 1500 LBS.

						SUPPLY	′ FAN DATA		Ελ	(HAUST FAN D	ATA				CO	OLING (	COIL						HEATIN	G COIL				UN	IT ELEC	TRICAL D	ATA		
										STATIC																							
	COOLING				STATIC I	PRESSURE	SUPPLY FAN E	LECTRICAL DATA		PRESSURE	MOTOR DATA		EAT	(°F)	LAT	(°F)										GAS							
	CAPACITY	SUPPLY			TOTAL	EXTERNAL	L		EXHAUST FAI	N EXTERNAL							REFRIGERANT		SENSIBL		EAT DB	LAT DB	APD (IN		INPUT		THERMAL						
MARK	(TONS)	CFM	OA CFM	1 RPM	(T.S.P.)	(E.S.P.)	BHP	HP	CFM	(E.S.P)	HP	TYPE	DB	WB	DB	WB	TYPE	MBH	E MBH	TYPE	(°F)	(°F)	WC)	MBH	(MBH)	(MBH)	EFFICIENCY	MCA	MOCP	VOLTS	PHASE	DESIGN BASIS	REMARKS
RTU7-1	7.5	3000	350	3450	1.33	1.00	1.4	2.8	1600	0.40	0.9	DX	78	66	58	56	R-410A	86.55	61.91	NATURAL GAS	59	96	0.33	150	150	120	80	47	50	208	3	TRANE YHC092F3RMA	
RTU7-2	7.5	3250	450	3450	1.38	1.00	1.8	2.8	1600	0.40	0.9	DX	79	67	59	58	R-410A	88.24	64.18	NATURAL GAS	54	100	0.20	200	200	160	80	47	50	208	3	TRANE YHC092F3RMA	
RTU8-1	7.5	3000	350	3450	1.33	1.00	1.4	2.8	1600	0.40	0.9	DX	78	66	58	56	R-410A	86.55	61.91	NATURAL GAS	59	96	0.33	150	150	120	80	47	50	208	3	TRANE YHC092F3RMA	
RTU8-2	7.5	3250	450	3450	1.38	1.00	1.8	2.8	1600	0.40	0.9	DX	79	67	59	58	R-410A	88.24	64.18	NATURAL GAS	54	100	0.20	200	200	160	80	47	50	208	3	TRANE YHC092F3RMA	

Е

NOTE:

### DIFFUSERS REGISTERS AND GRILLES SCHEDULE FACTORY FINISH SCRIPTION FACE SIZE DESIGN BASIS REMARKS 24"x24" NG BLADE SEE PLANS WHITE TITUS 350FL ED ANTI LIGATURE SEE PLANS WHITE BE SAFE PROUD EG450

MARK	MATERIAL	DESCI
		DLOOI
CD-A	STEEL	
EG-B	STEEL	LONG
EG-C	ALUMINUM	PERFORATED
LD-D	ALUMINUM	LINEAR
RG-E	STEEL	EGG
RG-F	STEEL	LONG
SG-G	ALUMINUM	PERFORATED
SG-H	STEEL	DOUBLE D

Е

# UNIT HEATER SCHEDULE - ELECTRIC

NOTES: 1. DISCONNECT TO BE PROVIDED AND INSTALLED BY ELECTRICAL CONTRACTOR.

				MOUNTING HEIGHT	-	E	LECTRICAL DAT	Ą		
MARK	CFM	EAT (°F)	KW	(FT)	ORIENTATION	VOLTS	PHASE	FLA	DESIGN BASIS	REMARKS
EUH7-1	100	50	1.5	2' - 0"	HORIZONTAL	120	1	13	QMARK VFK151F	
EUH7-2	100	50	4	2' - 0"	HORIZONTAL	208	1	19	BERKO VFK408F	
EUH7-3	100	50	1.5	2' - 0"	HORIZONTAL	120	1	13	QMARK VFK151F	
EUH7-4	100	50	4	2' - 0"	HORIZONTAL	208	1	19	BERKO VFK408F	
EUH7-5	100	50	1.5	2' - 0"	HORIZONTAL	120	1	13	QMARK VFK151F	
EUH7-6	100	50	1.5	2' - 0"	HORIZONTAL	120	1	13	QMARK VFK151F	
EUH8-1	100	50	1.5	2' - 0"	HORIZONTAL	120	1	13	QMARK VFK151F	
EUH8-2	100	50	4	2' - 0"	HORIZONTAL	208	1	19	BERKO VFK408F	
EUH8-3	100	50	1.5	2' - 0"	HORIZONTAL	120	1	13	QMARK VFK151F	
EUH8-4	100	50	4	2' - 0"	HORIZONTAL	208	1	19	BERKO VFK408F	
EUH8-5	100	50	1.5	2' - 0"	HORIZONTAL	120	1	13	QMARK VFK151F	
EUH8-6	100	50	1.5	2' - 0"	HORIZONTAL	120	1	13	QMARK VFK151F	

# AIR COOLED CONDENSING UNIT SCHEDULE

D

### FURNACE - GAS SCHEDULE

# NOTES: 1.DISCONNECT TO BE PROVIDED AND INSTALLED BY ELECTRICAL CONTRACTOR. 2. PROVIDE WITH DIRECT DRIVE FAN WITH EC MOTOR AND 2-STAGE HEATING OPERATION.

С

ND INSTALL CONDENSATE N	EUTRALIZAT	FION ANE	D ROUTE C	ONDENSATE T	O FLOOR DF	RAIN.													
					COOLING	COIL DATA					HEATING	DATA			ELE	ECTRICAL	DATA		
			ESP (IN		EAT DB							THERMAL	MINIMUM GAS						
AREA SERVED	OA CFM	CFM	WC)	TOTAL MBH	(°F)	LAT DB (°F)	MODEL	EAT (°F)	LAT (°F)	INPUT MBH	OUTPUT MBH	EFFICIENCY	PRESSURE	AFUE	HP	VOLTS	PHASE	DESIGN BASIS	REMARKS
COTTAGE 7 LAUNDRY	100	800	0.80	24	80	55	CX35-30B	60	95	44	42	96	3.5	96	1/2	120	1	LENNOX EL296UH045XV36B	
OFFICES	150	1560	0.80	46	80	55	CX35-48C	50	95	88	85	96	3.5	96	3/4	120	1	LENNOX EL296UH090XV48C	
COTTAGE 8 LAUNDRY	100	800	0.80	24	80	55	CX35-30B	60	95	44	42	96	3.5	96	1/2	120	1	LENNOX EL296UH045XV36B	

### PACKAGED ROOFTOP UNIT SCHEDULE

ONVENIENCE OUTLET.


С


EQUIVALENT PRODUCTS BY MANUFACTURERS WHICH ARE NOT LISTED IN SCHEDULES OR IN SPECIFICATIONS MAY BE USED WITH PRE-APPROVAL FROM ENGINEER. SEE SPECIFICATIONS FOR SUBSTITUTION REQUEST INSTRUCTIONS.


F

F

RDIFFUSER	2" SLOT	WHITE	TITUS FL-20	
GCRATE	24"x24"	WHITE	TITUS 50F	
G BLADE	24"x24"	WHITE	TITUS 350FL	
D ANTI LIGATURE	SEE PLANS	WHITE	BE SAFE PROUD EG450	
DEFLECTION	24"x24"	WHITE	TITUS 272FL	

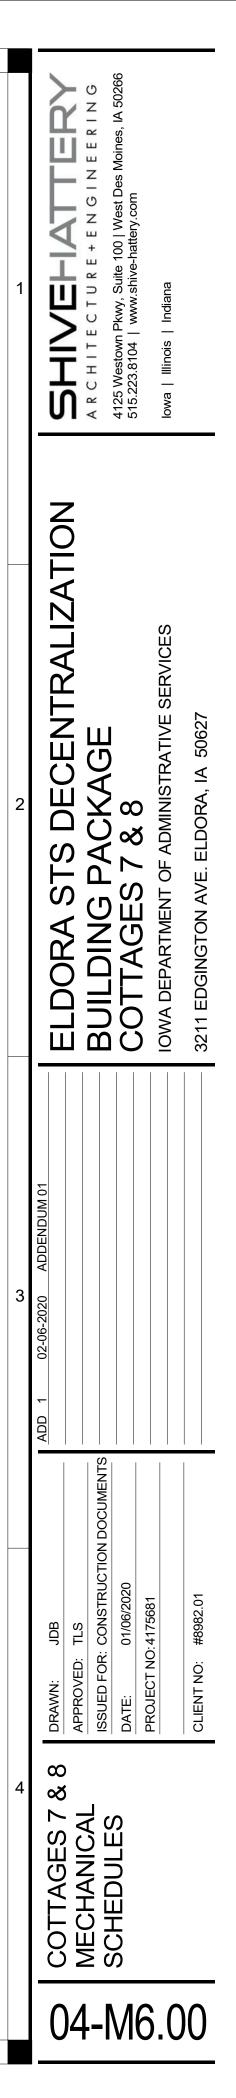

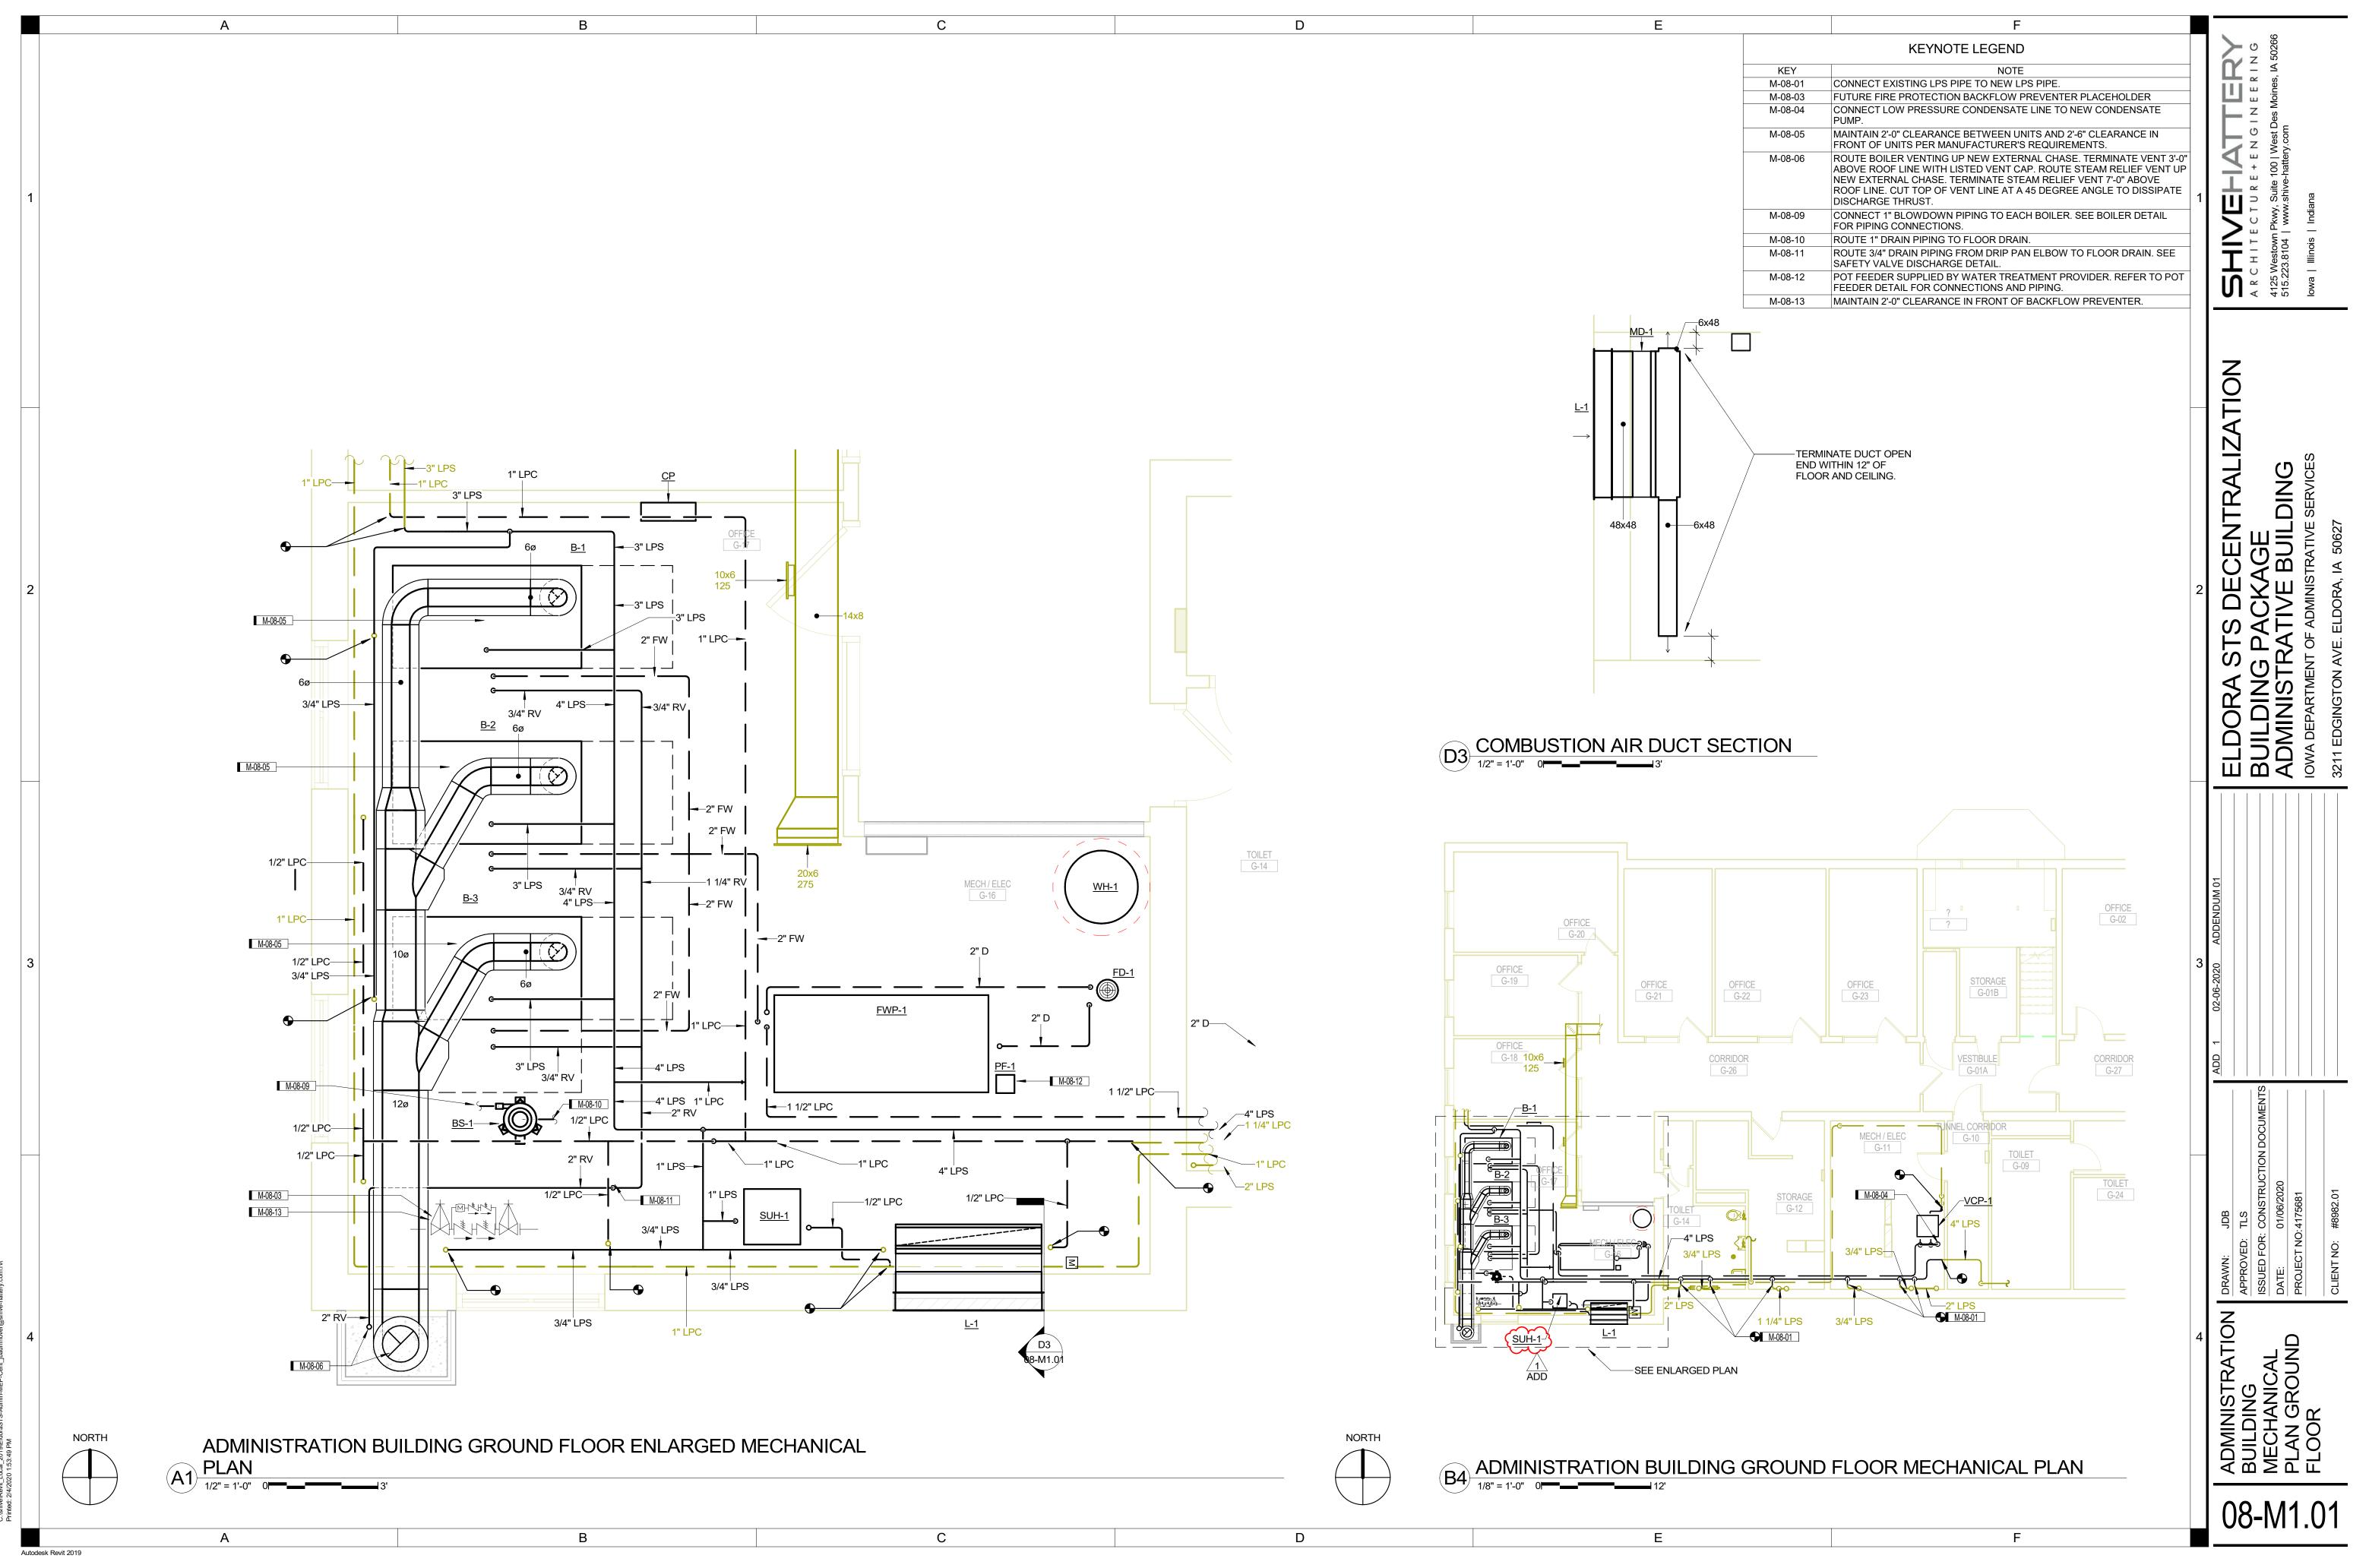

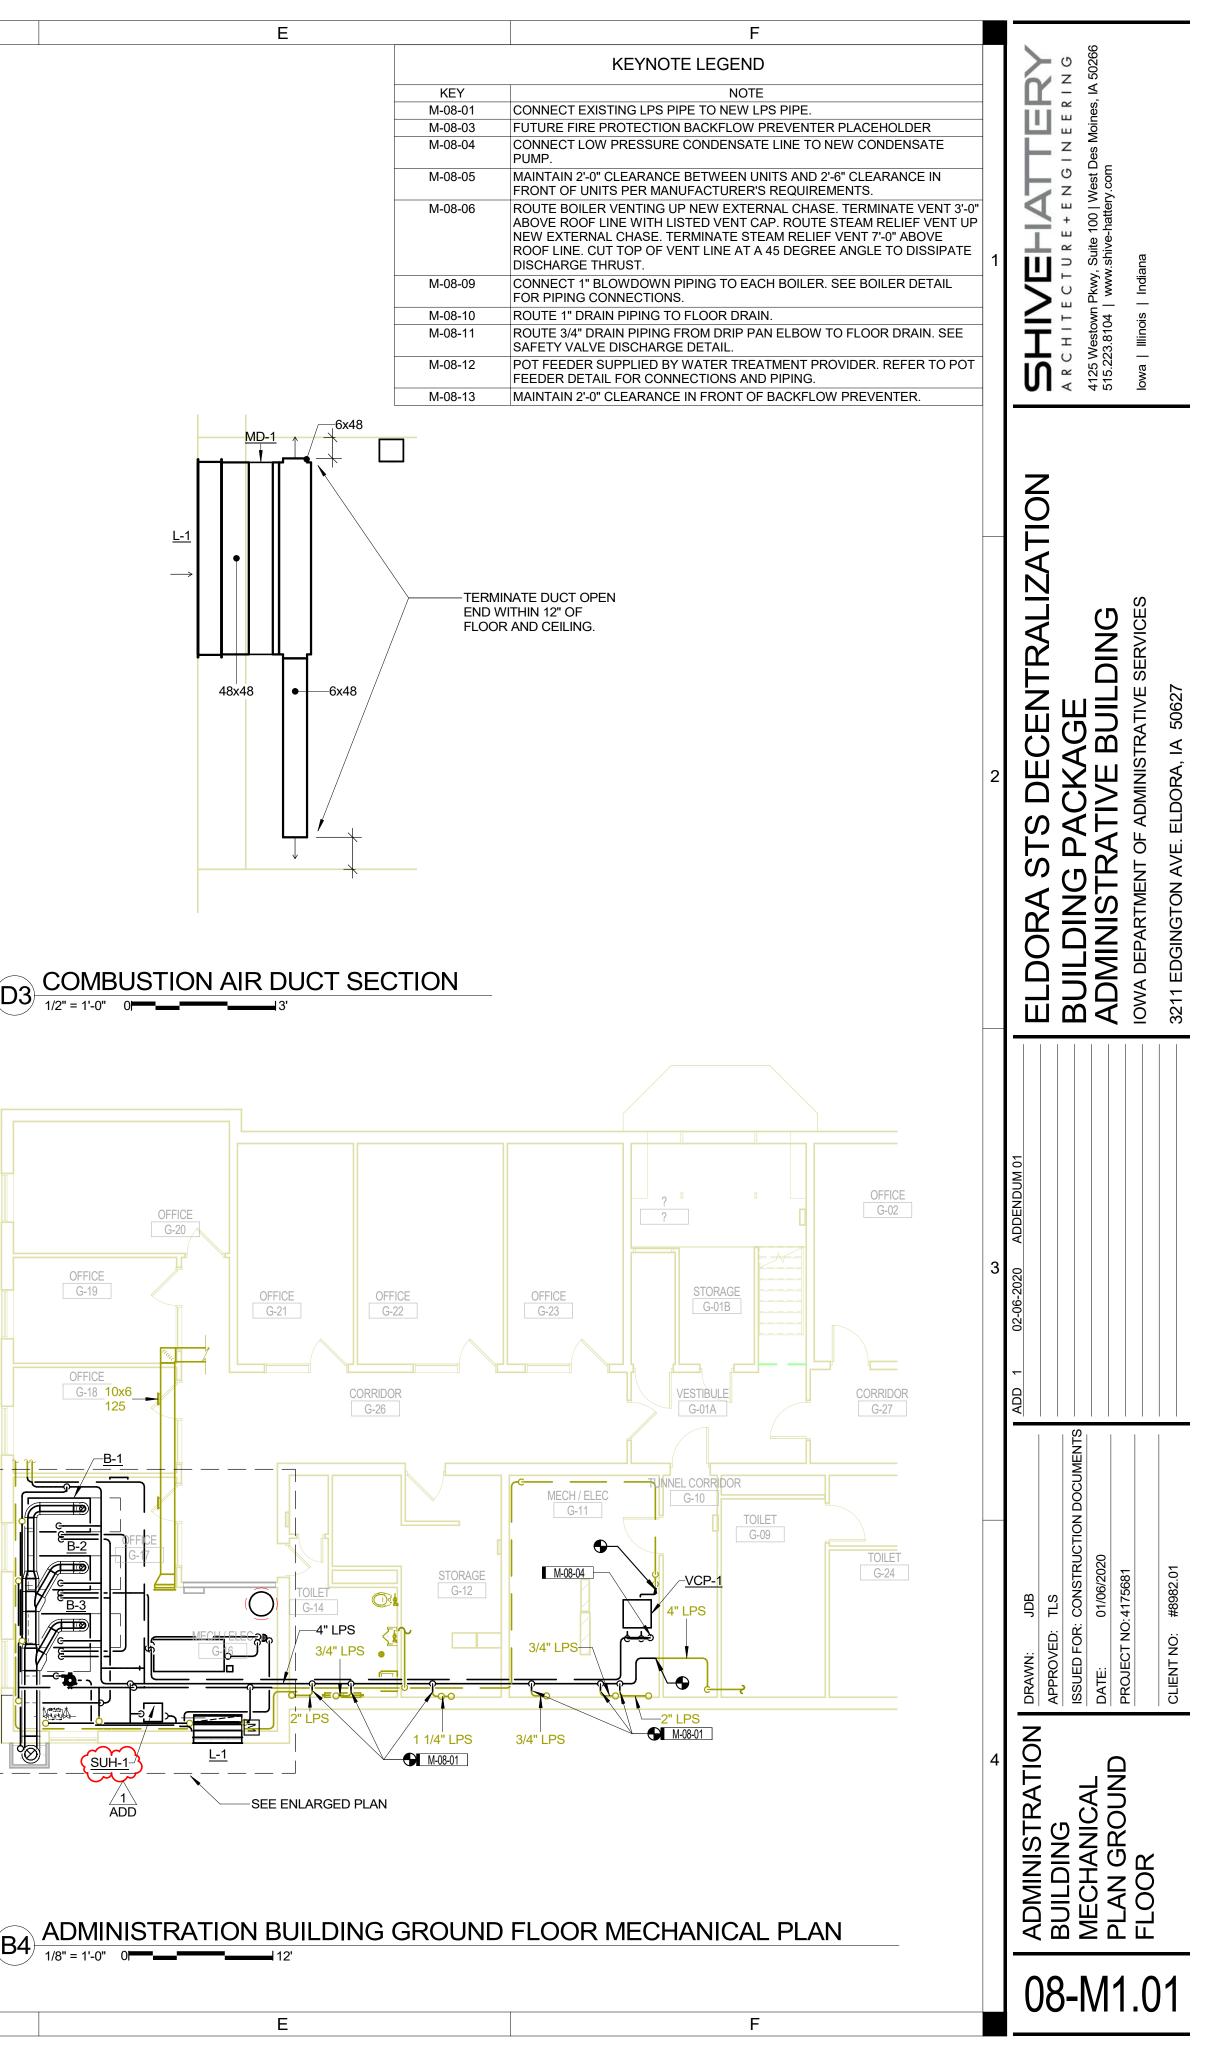

_jbaumhover@shive-hattery.com.rvt
_2019/EldoraSTS-Admin-MEP-Cent
e\Revit_Local_

Autodesk Revit 2019

Α

	Α	В	
1			
2			
3			
0			
4			
- <b>-</b>			

В

					MOTOR		DAMPER S	С
	WITH DAMPER END SWITCH S CONTRACTOR TO PROVID							_
				DIMEN	NSIONS			Γ
MARK	EQUIPMENT SERVED	CFM	APD (IN)	Н	W	INSULATED BLADE	BLADE ORIENTATION	
MD-1	BOILER COMBUSTION AIR	1050	0.01	48	48	YES	HORIZONTAL	

MARK	CFM	
SUH-1	<b>3</b> 860	
m	مر	
2		
)		

NOTES:

 $\overline{\phantom{a}}$ 

<u>∕1</u> ADD

С

MARK

VCP-1

MARK

B-1

B-2

B-3

SYSTEM SERVED

MARK

L-1

FUEL

LAT (°F)

95

1. DISCONNECT TO BE PROVIDED AND INSTALLED BY ELECTRICAL CONTRACTOR.

EAT (°F)

-5

D

CONDENSATE RETURN

NATURAL GAS	4	14	350	280	80	
NATURAL GAS	4	14	350	280	80	
NATURAL GAS	4	14	350	280	80	
UNIT HEATER SCHEDULE - STEAM						М
			<b>U</b>			

STEAM

PRESSURE

(PSI)

15.00

### **BOILER SCHEDULE - STEAM** NOTES: 1. MANUFACTURER SHALL PROVIDE PRESSURE SAFETY VALVE FOR BOILER. CONTRACTOR SHALL ROUTE AND TERMINATE RELIEF PIPING PER MANUFACTURER'S REQUIREMENTS. 2. PROVIDE COMMUNICATIONS BRIDGE TO BACNET. PROVIDE DISPLAY ON DDC SYSTEM WHICH SHOWS BOILER ENABLE/DISABLE, STEAM SUPPLY PRESSURE SET POINT AND SUMMARY ALARM FOR EACH BOILER. 3. INTERLOCK BOILER OPERATION WITH MOTORIZED DAMPER AT COMBUSTION AIR INTAKE LOUVER.

GAS

MIN. (IN. WC.) MAX (IN. WC.) INPUT (MBH)

PRESSURE PRESSURE

MBH

89

HEIGHT (IN.)

48

DD <b>\</b>	3. INTERLOCK F	TANK	GPM (PER	HEAD	NUMBER OF	PUMP HP	ELI
	MARK	VOLUME	PUNP)	(PSI)	PUMPS	(EACH)	VOLT
	FWP-1	71	3	20.00	4	1/3	208

						FEEDWAT	ER PUM
	NOTES:						
_	1. FEEDWATER	PUMP ASS	SEMBLY SHALL H	AVE SINGL	E POINT POWER	CONNECTION W	/ITH CONTE
	2-UNIT SHALL	BE SIZED V	WITH ONE STAND	BY PUMP.	$\sim$	$\sim$	
ADD	3. INTERLOCK F	PUMP OPE	RATION WITH BO	ILER LOW \	NATER FEED CO	NTROL.	
	m		han	m	mmm		
		TANK	GPM (PER	HEAD	NUMBER OF	PUMP HP	ELEC
				1		1	

7\_

TYPE

VACUUM

AIR FLOW

(CFM)

1050

GAS

RATING AT 5-1/2" HG VACUUM AT 160°F SIMULTANEOUS

GPM AIR CFM

3

DIMENSIONS

48

WIDTH (IN.) DEPTH (IN.)

4"

GROSS

OUTPUT

(MBH)

STEAM

LBS/HR

67

HEAD (FT)

46.00

HP

1

44


MOUNTING

6' - 0"


Е

Е

С

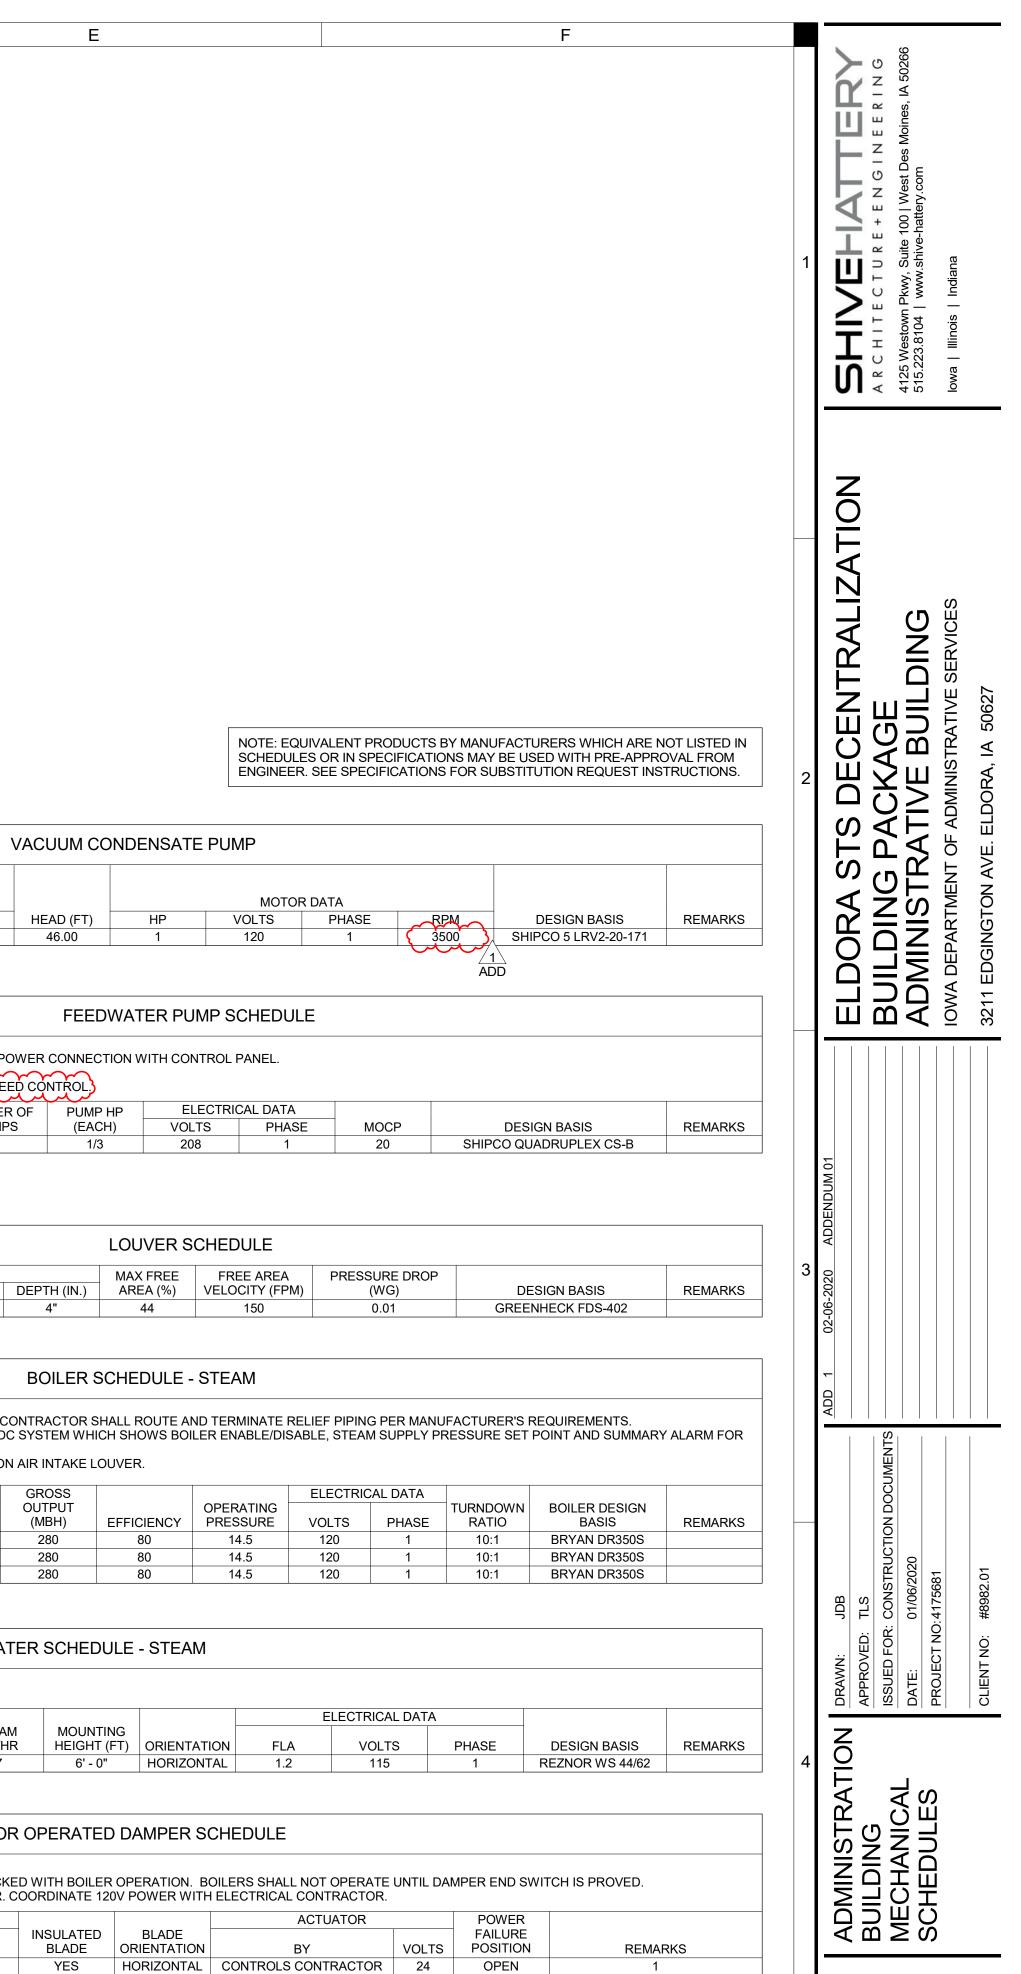



08-M6.00

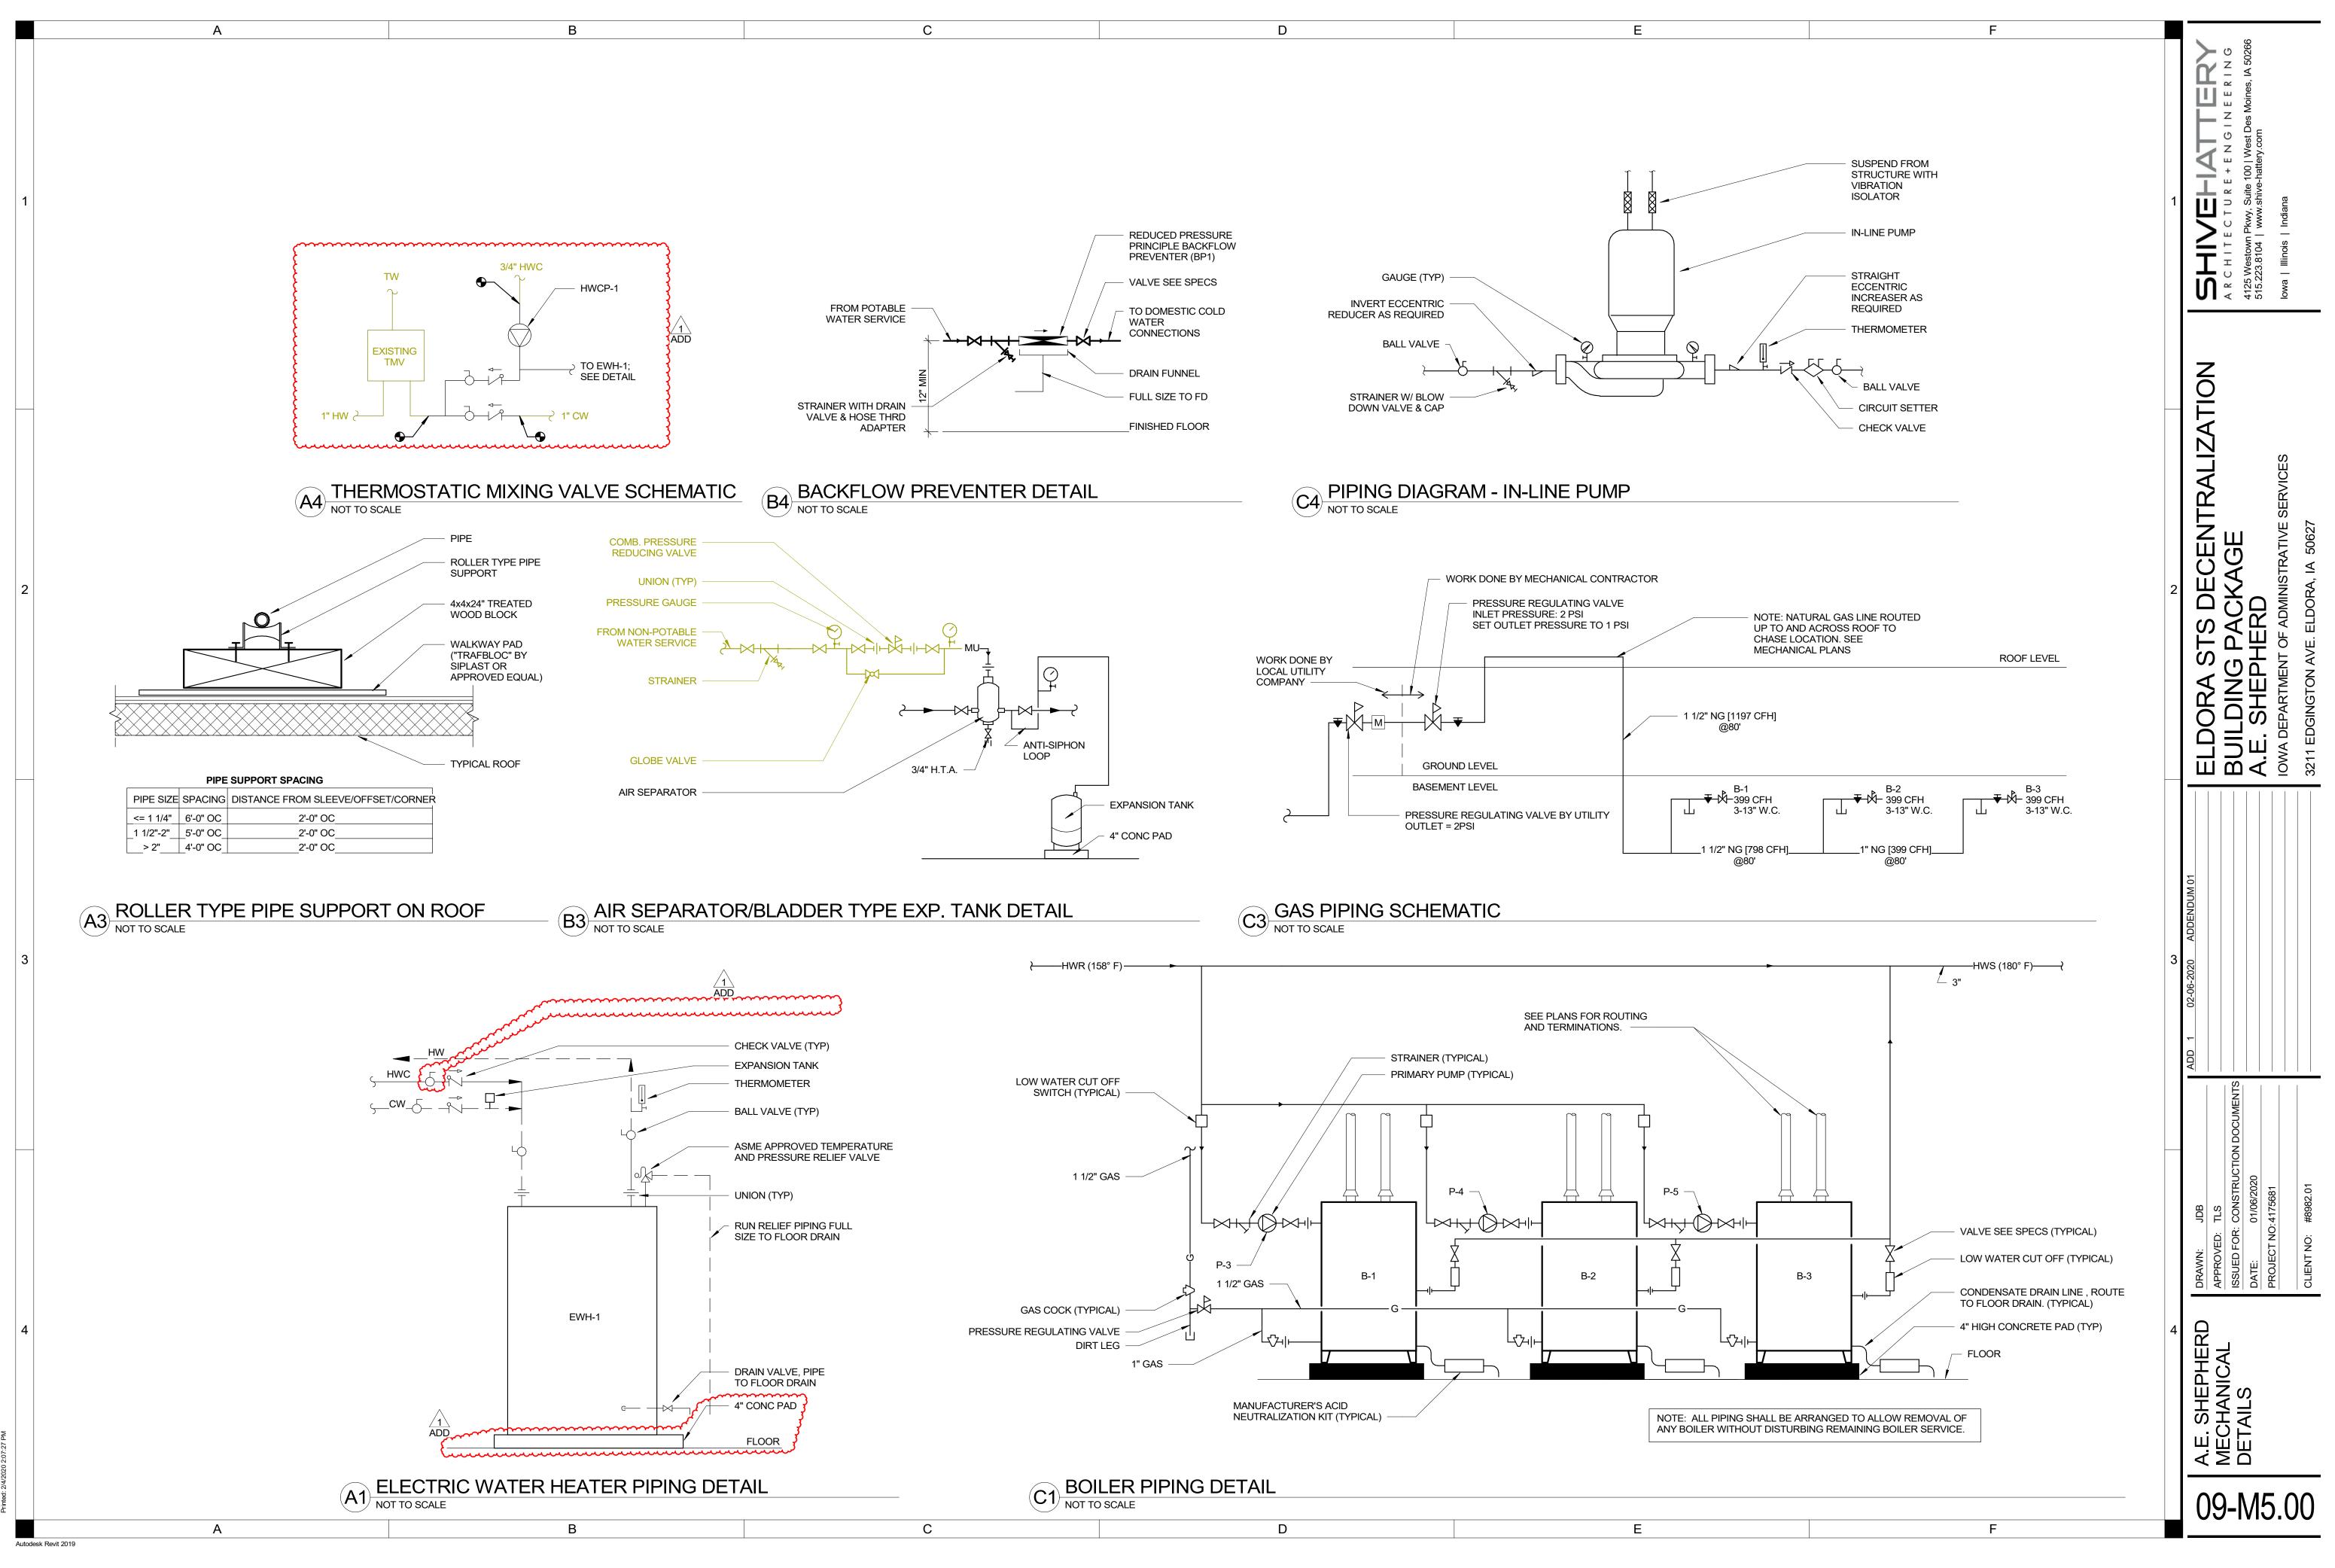

/.com.rvt	
hive-hatter	
mhover@s	
-Cent_jbau	
Iteen-MEP-C	
raSTS-Car	
ocal_2019\EldoraST	
Local	
ive\Revit	
Чs	1


			A	В	
	1				
	2				
	3				
	4				
3 PM					
20 1:30:2					
Printed: 2/4/2020 1:30:23 PM					
Print			•		
	Autode	esk Revit 2019	Α	В	

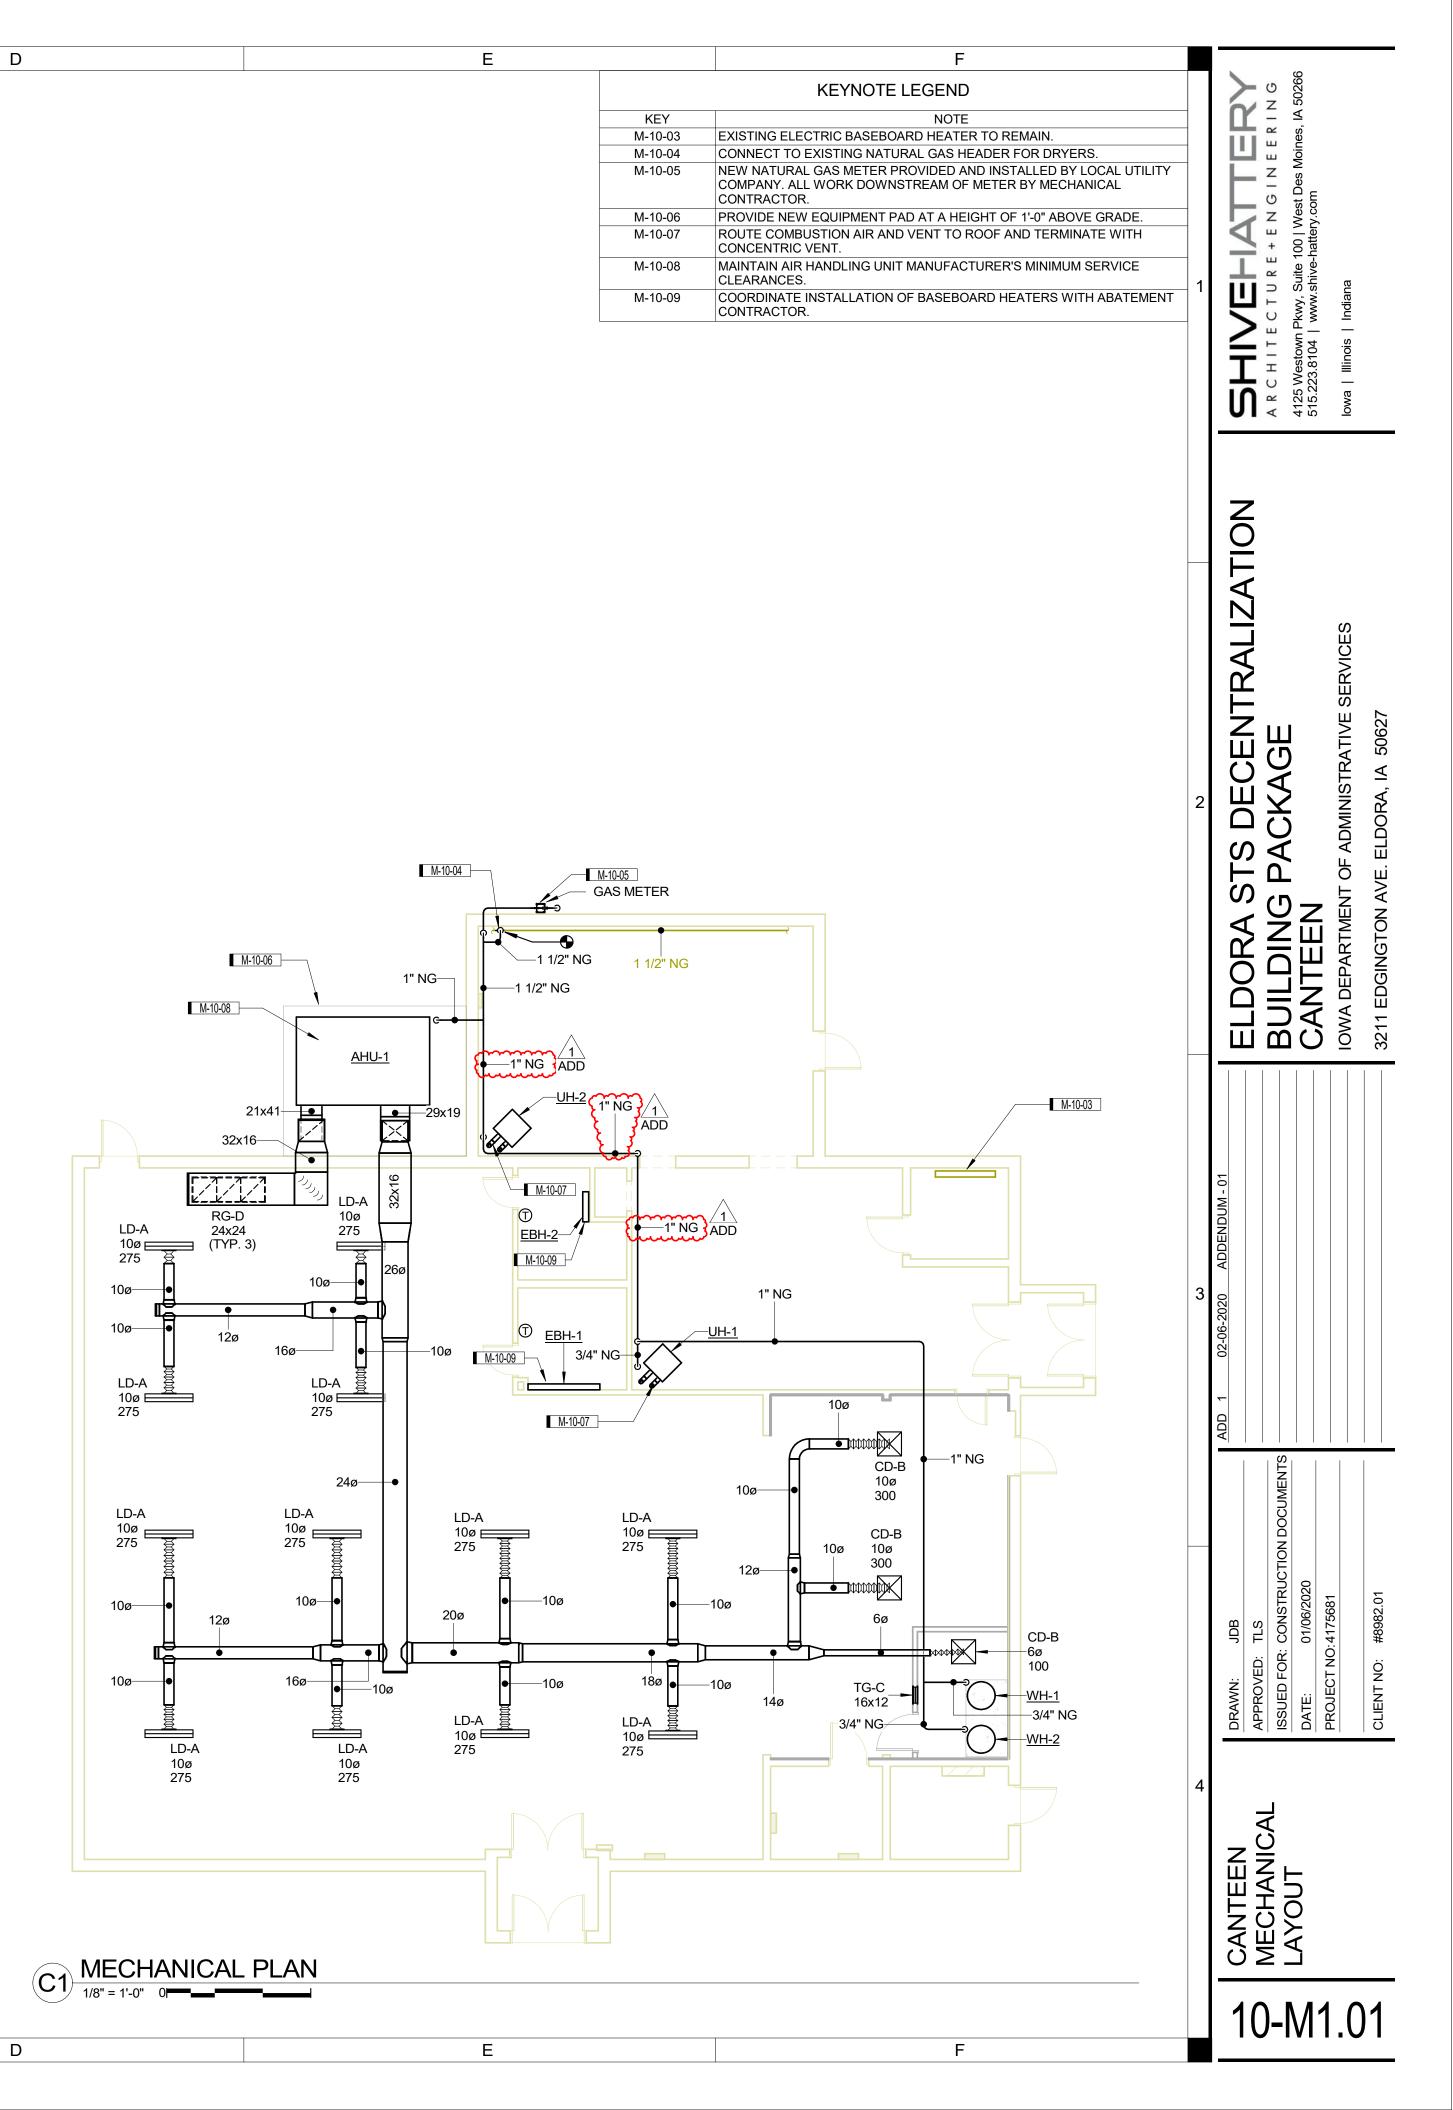


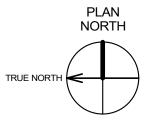


.MEP-Cent_jbaumhover@shive-hattery.com.rvt	
anteen-	
vit_Local_2019\EldoraSTS-C	
Local	
shive\Revit_	

		Α	В	
	1			
	•			
	2			
	3			
	4			
Mc				
1:30:24 F				
2/4/2020				
Printed: 2/4/2020 1:30:24 PM				
		Α	В	
	Autode	ssk Revit 2019		

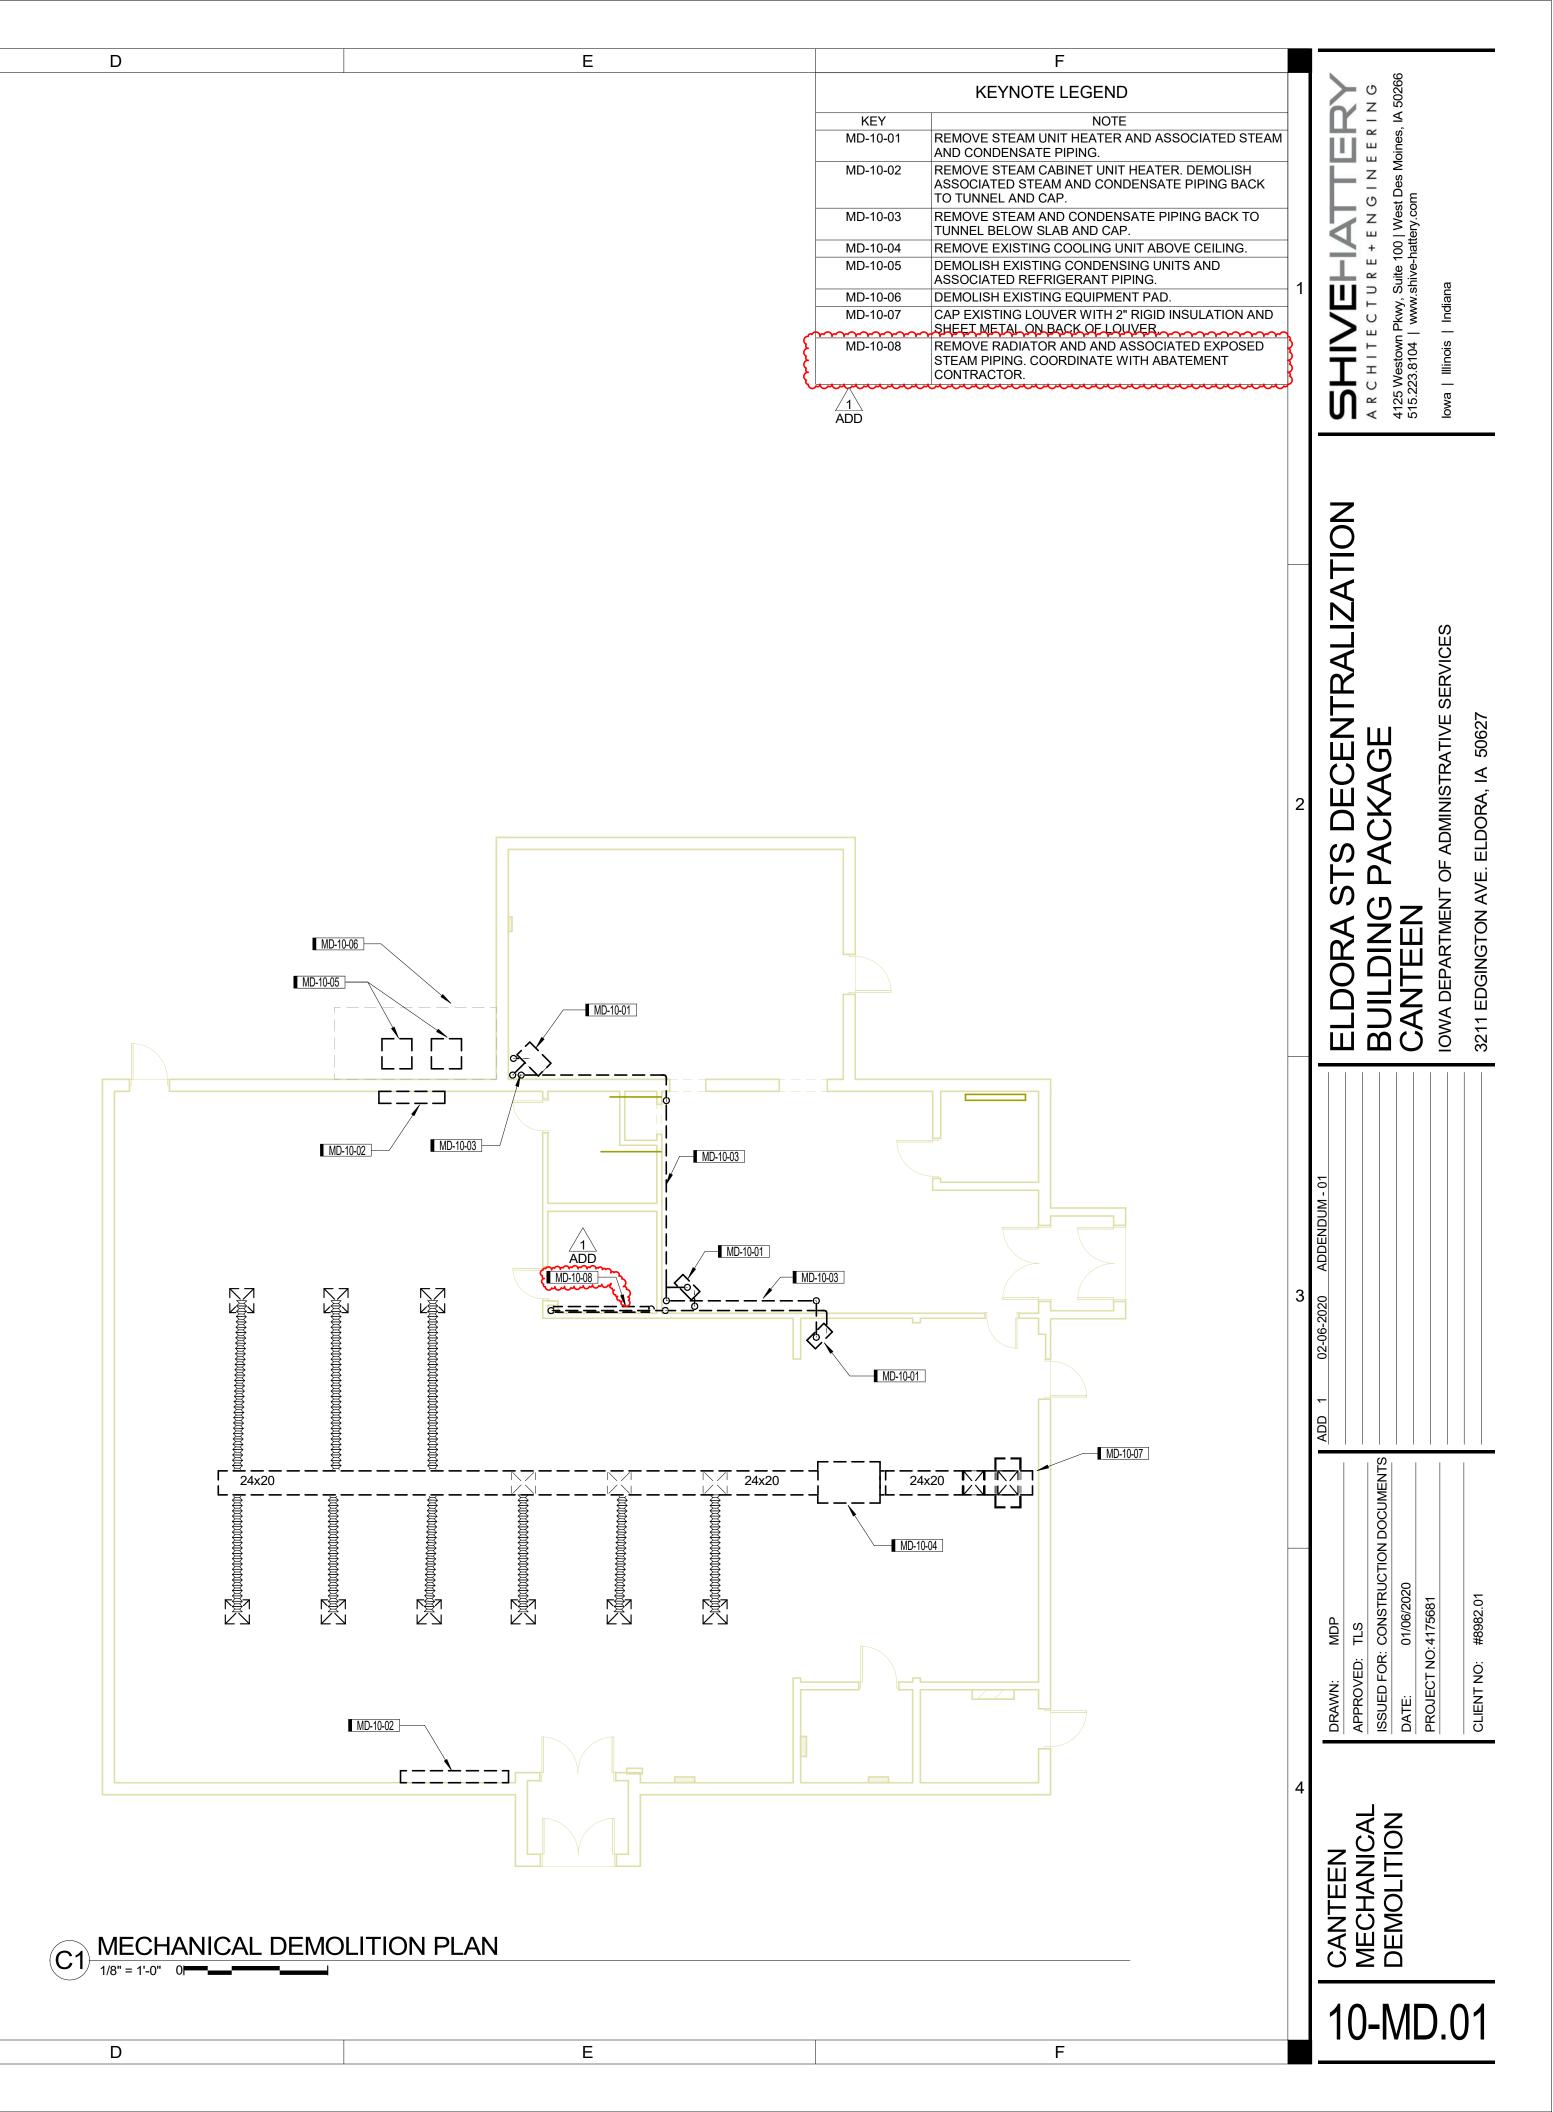


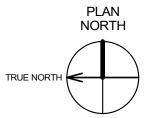

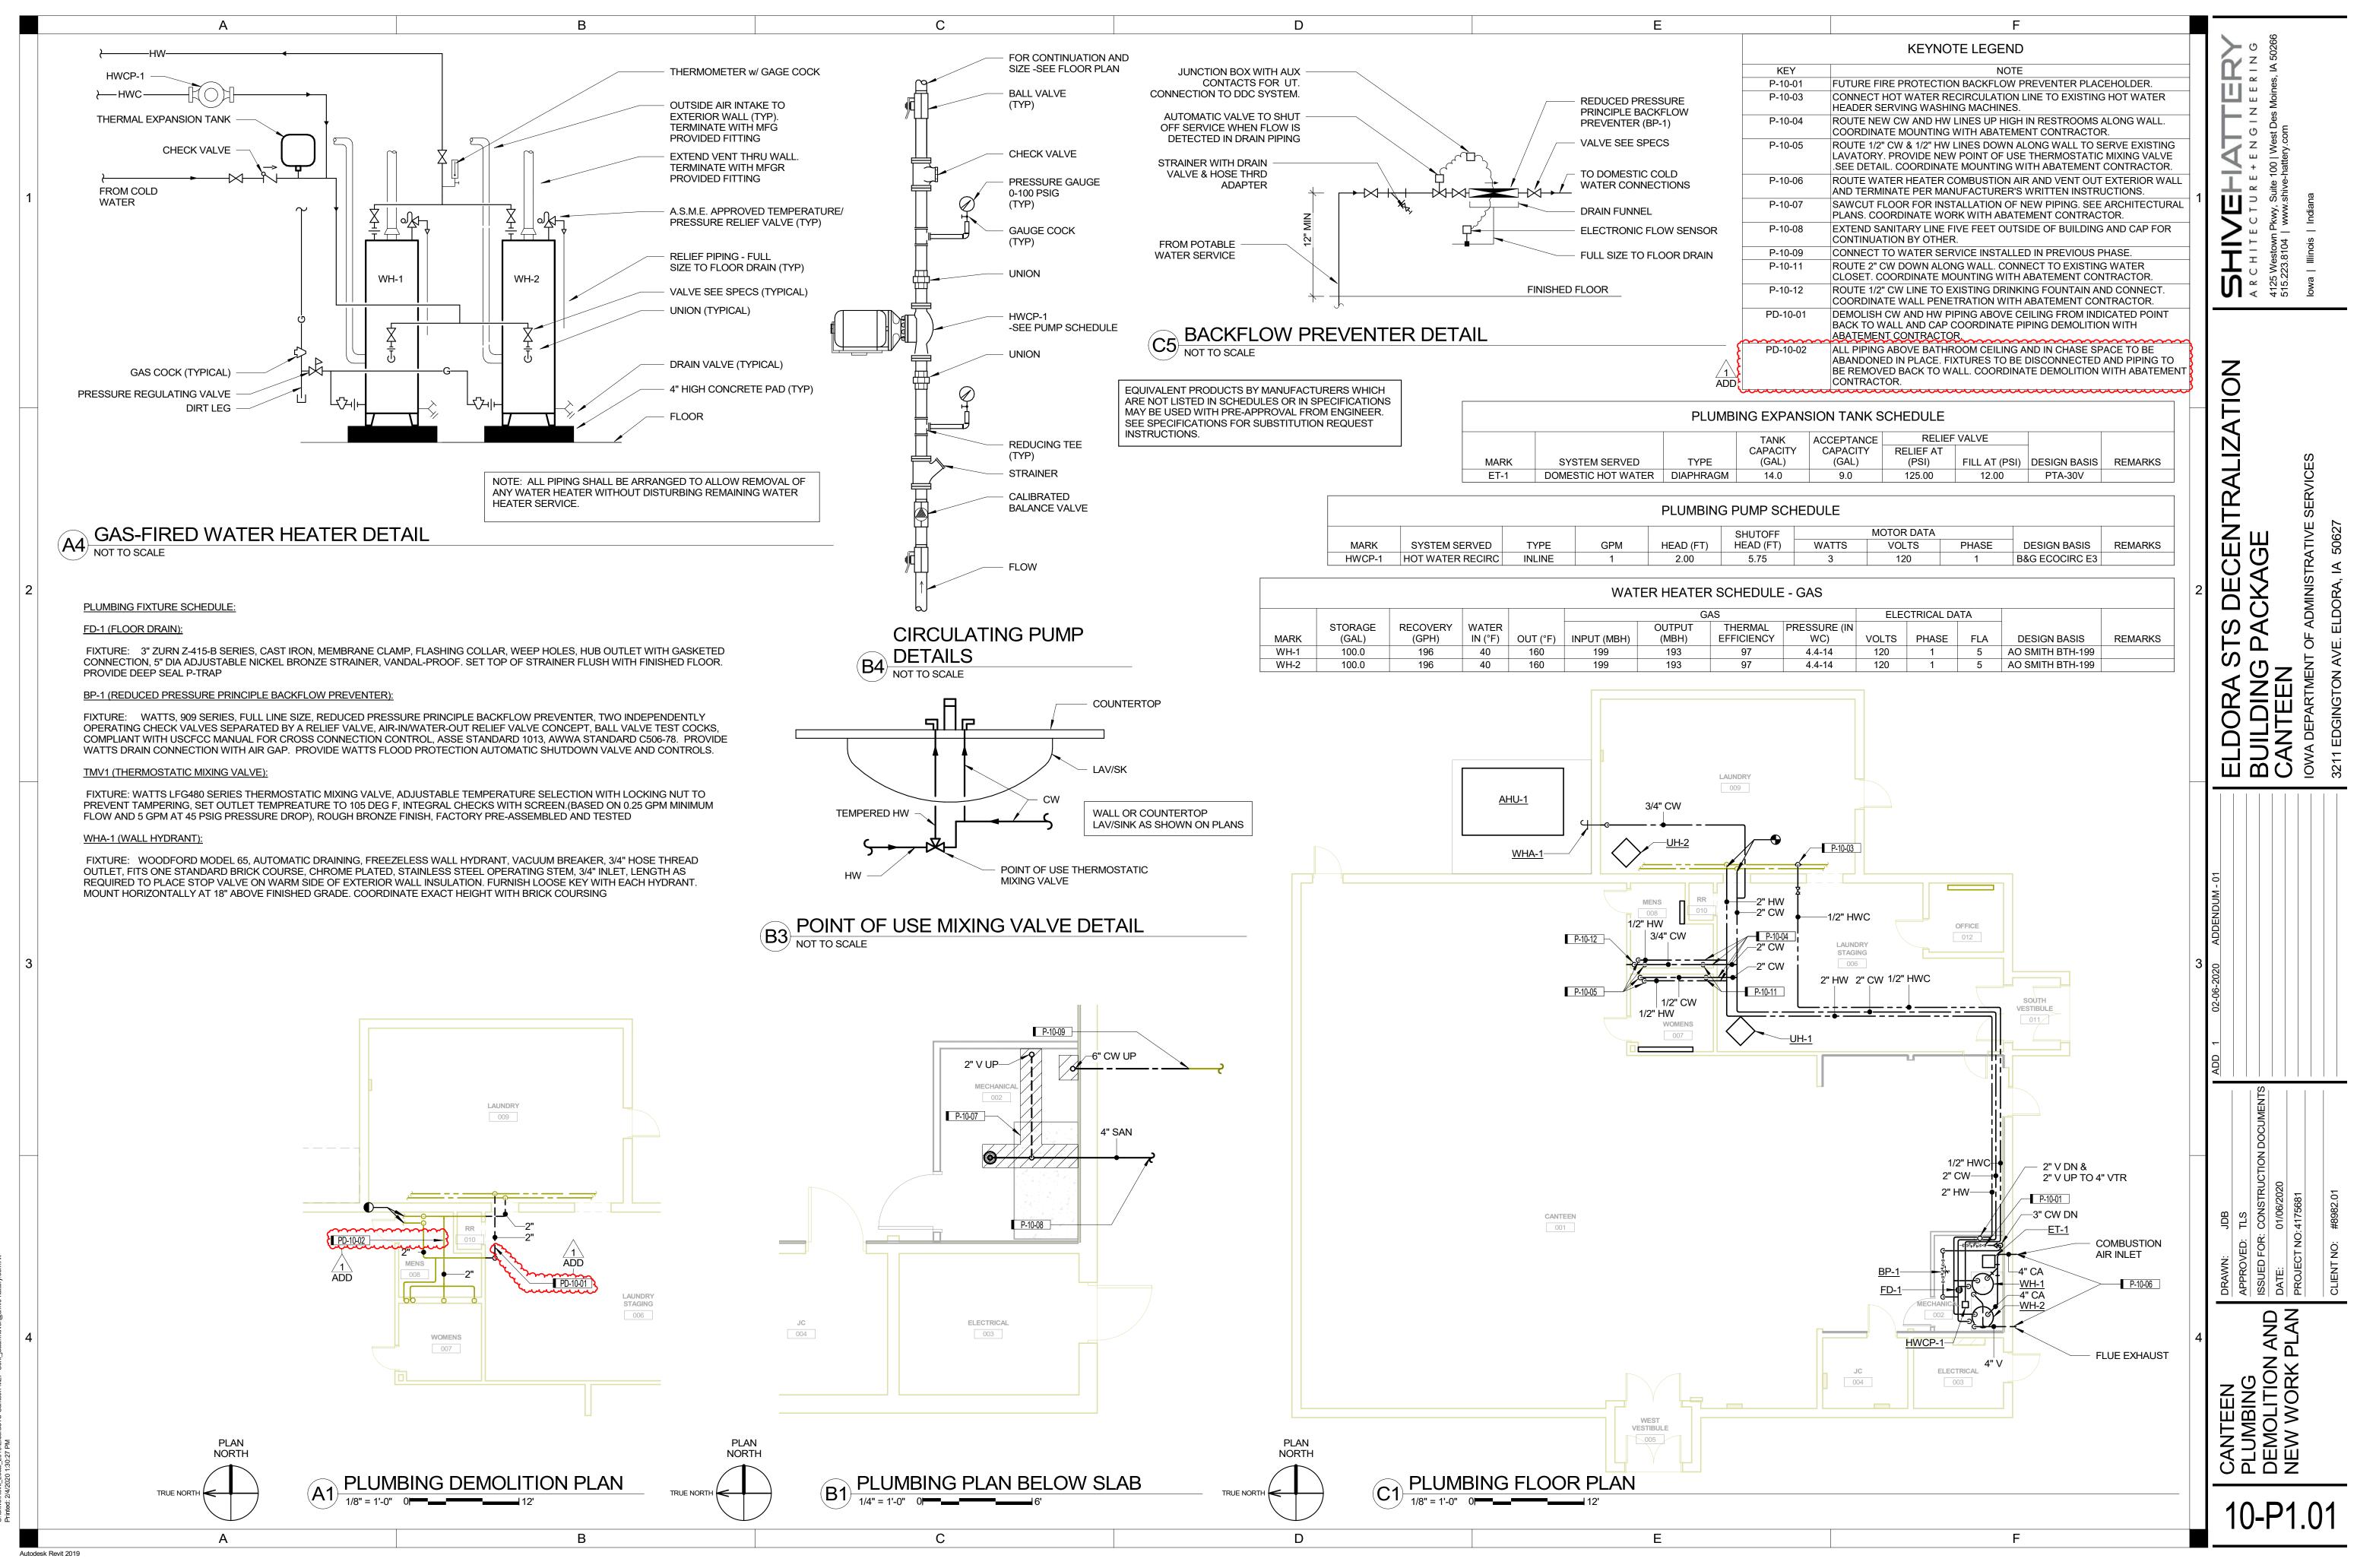


_Local_2019/EldoraSTS-Kitchen-MEP-Cent_jbaumhover@shive-hattery.com.rvt	


			A	В
	1			
	2			
	3			
	4			
59:51 PM				
Printed: 2/4/2020 1:59:51 PM	Δ. 1.14	≅k Revit 2019	A	В
	mul0de	2011 10 YR 2013		

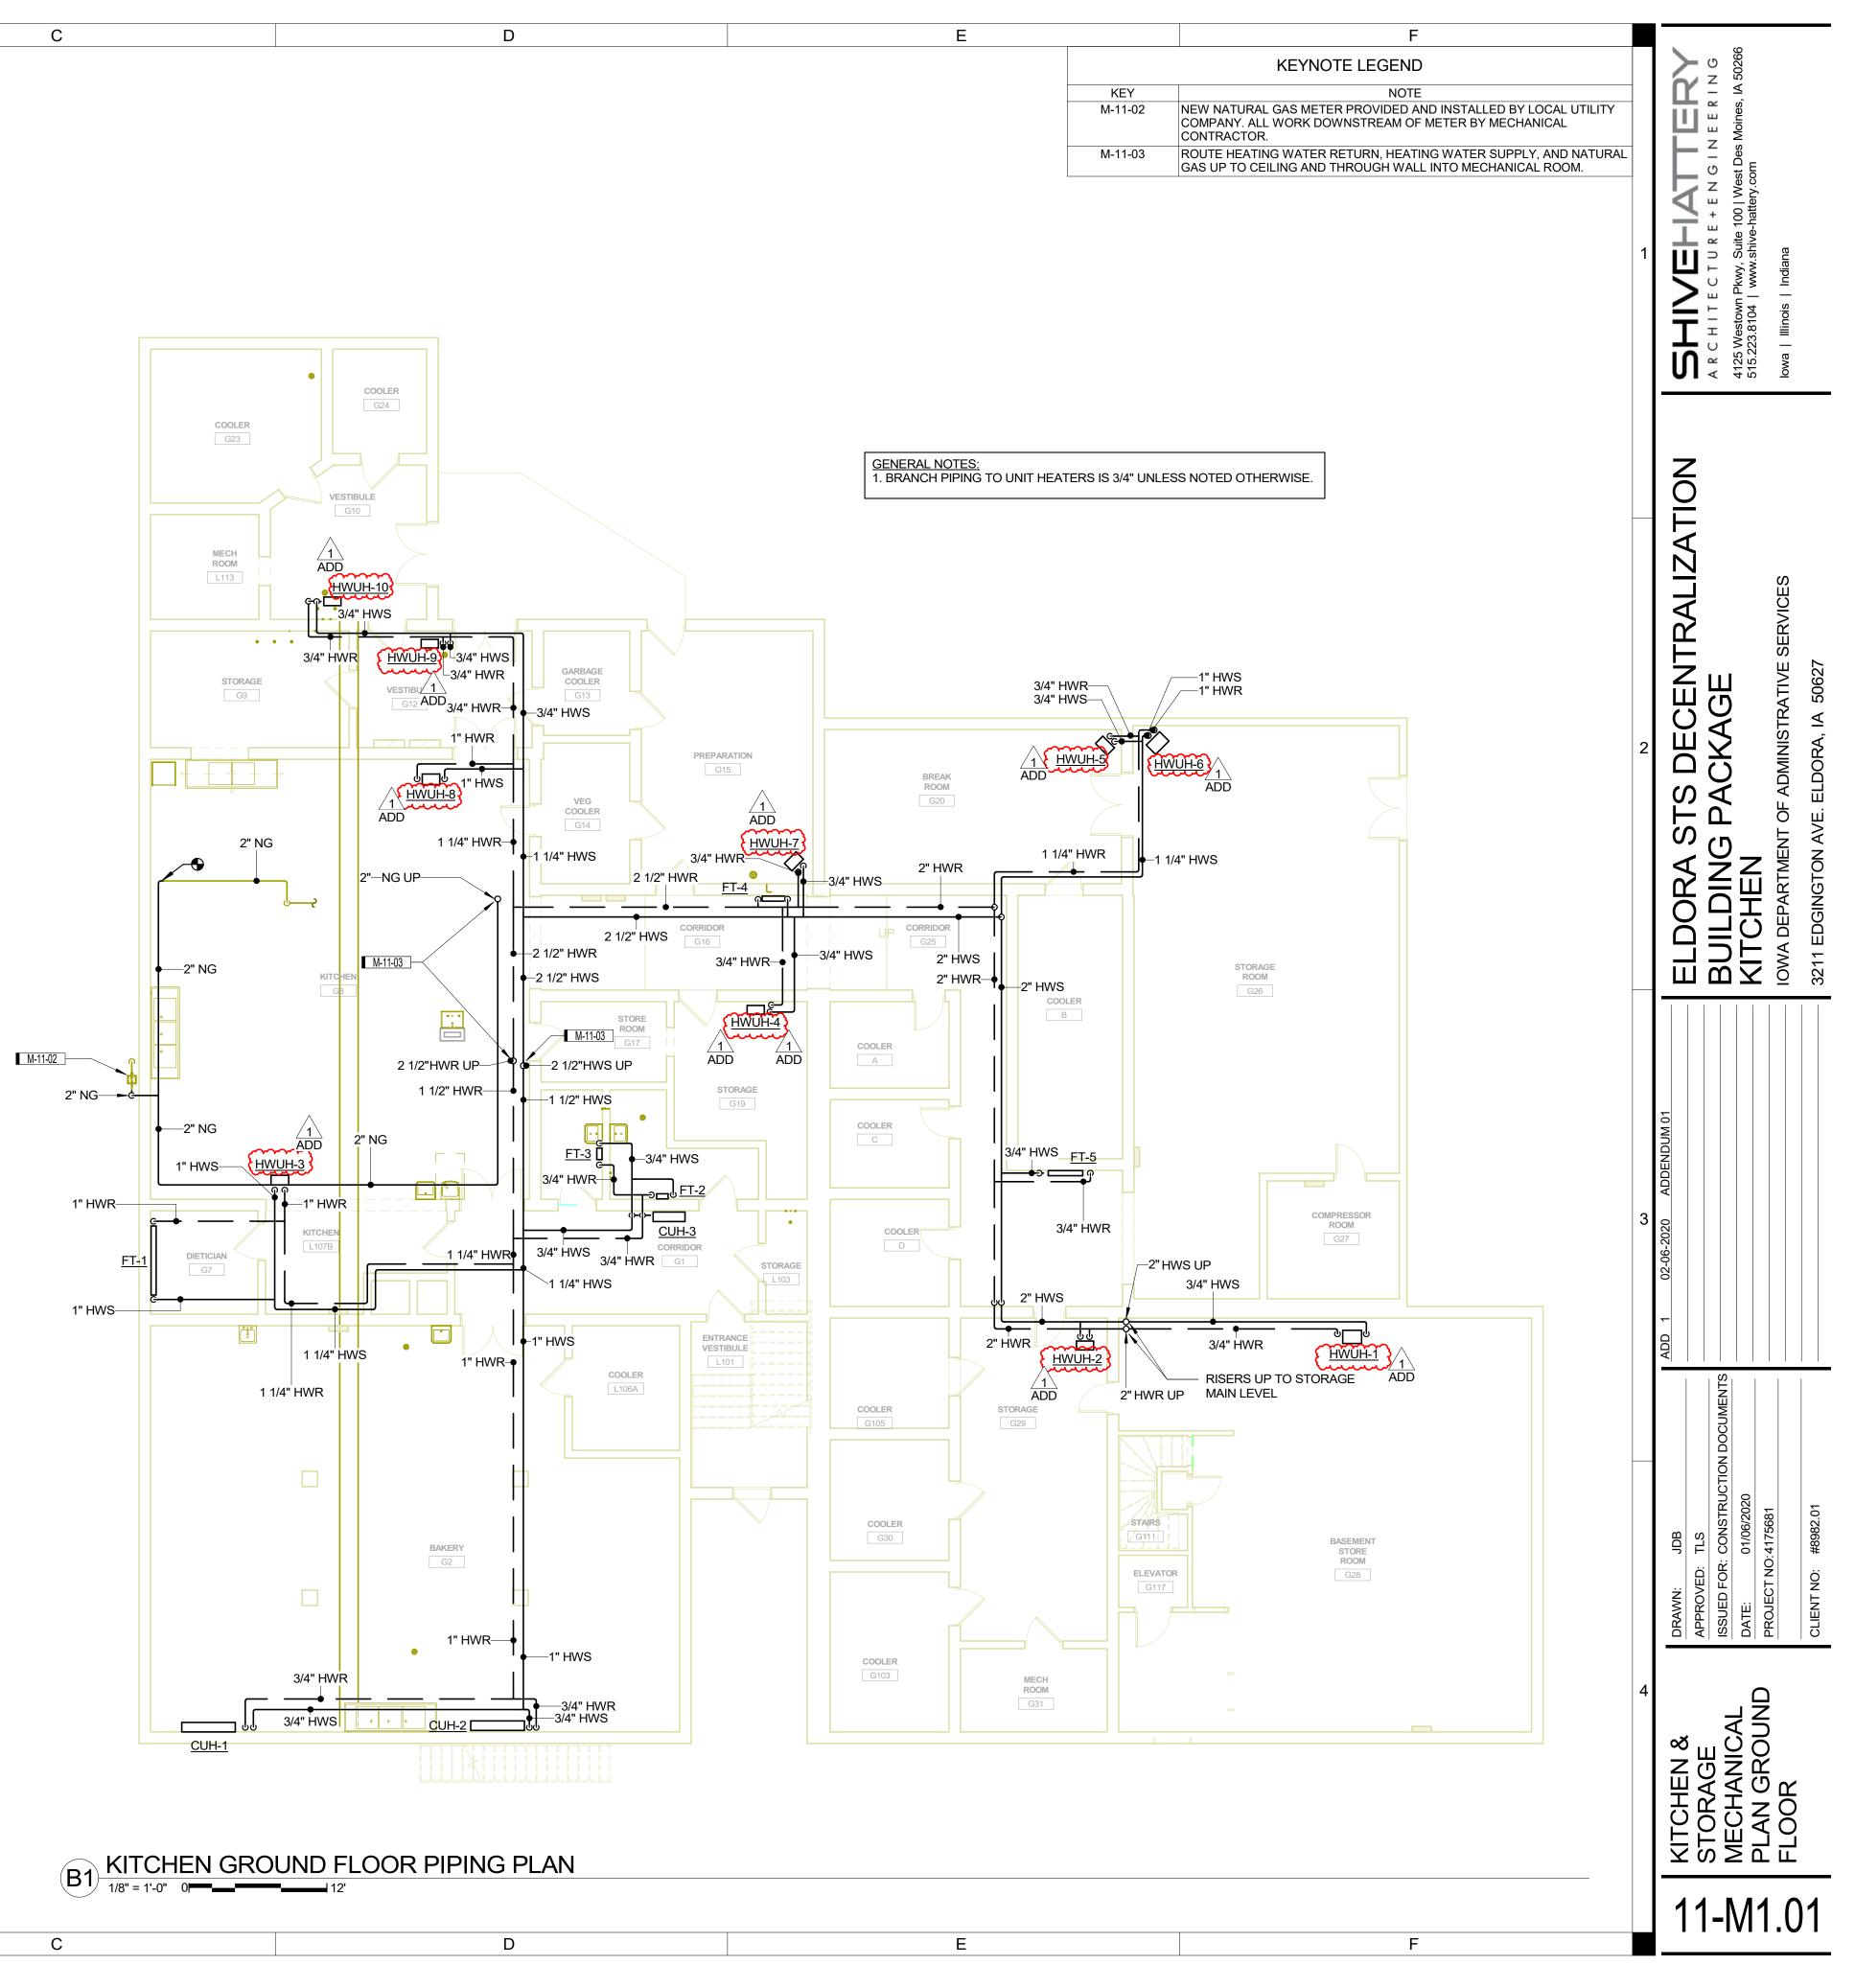

PLAN NORTH

TRUE NORTH

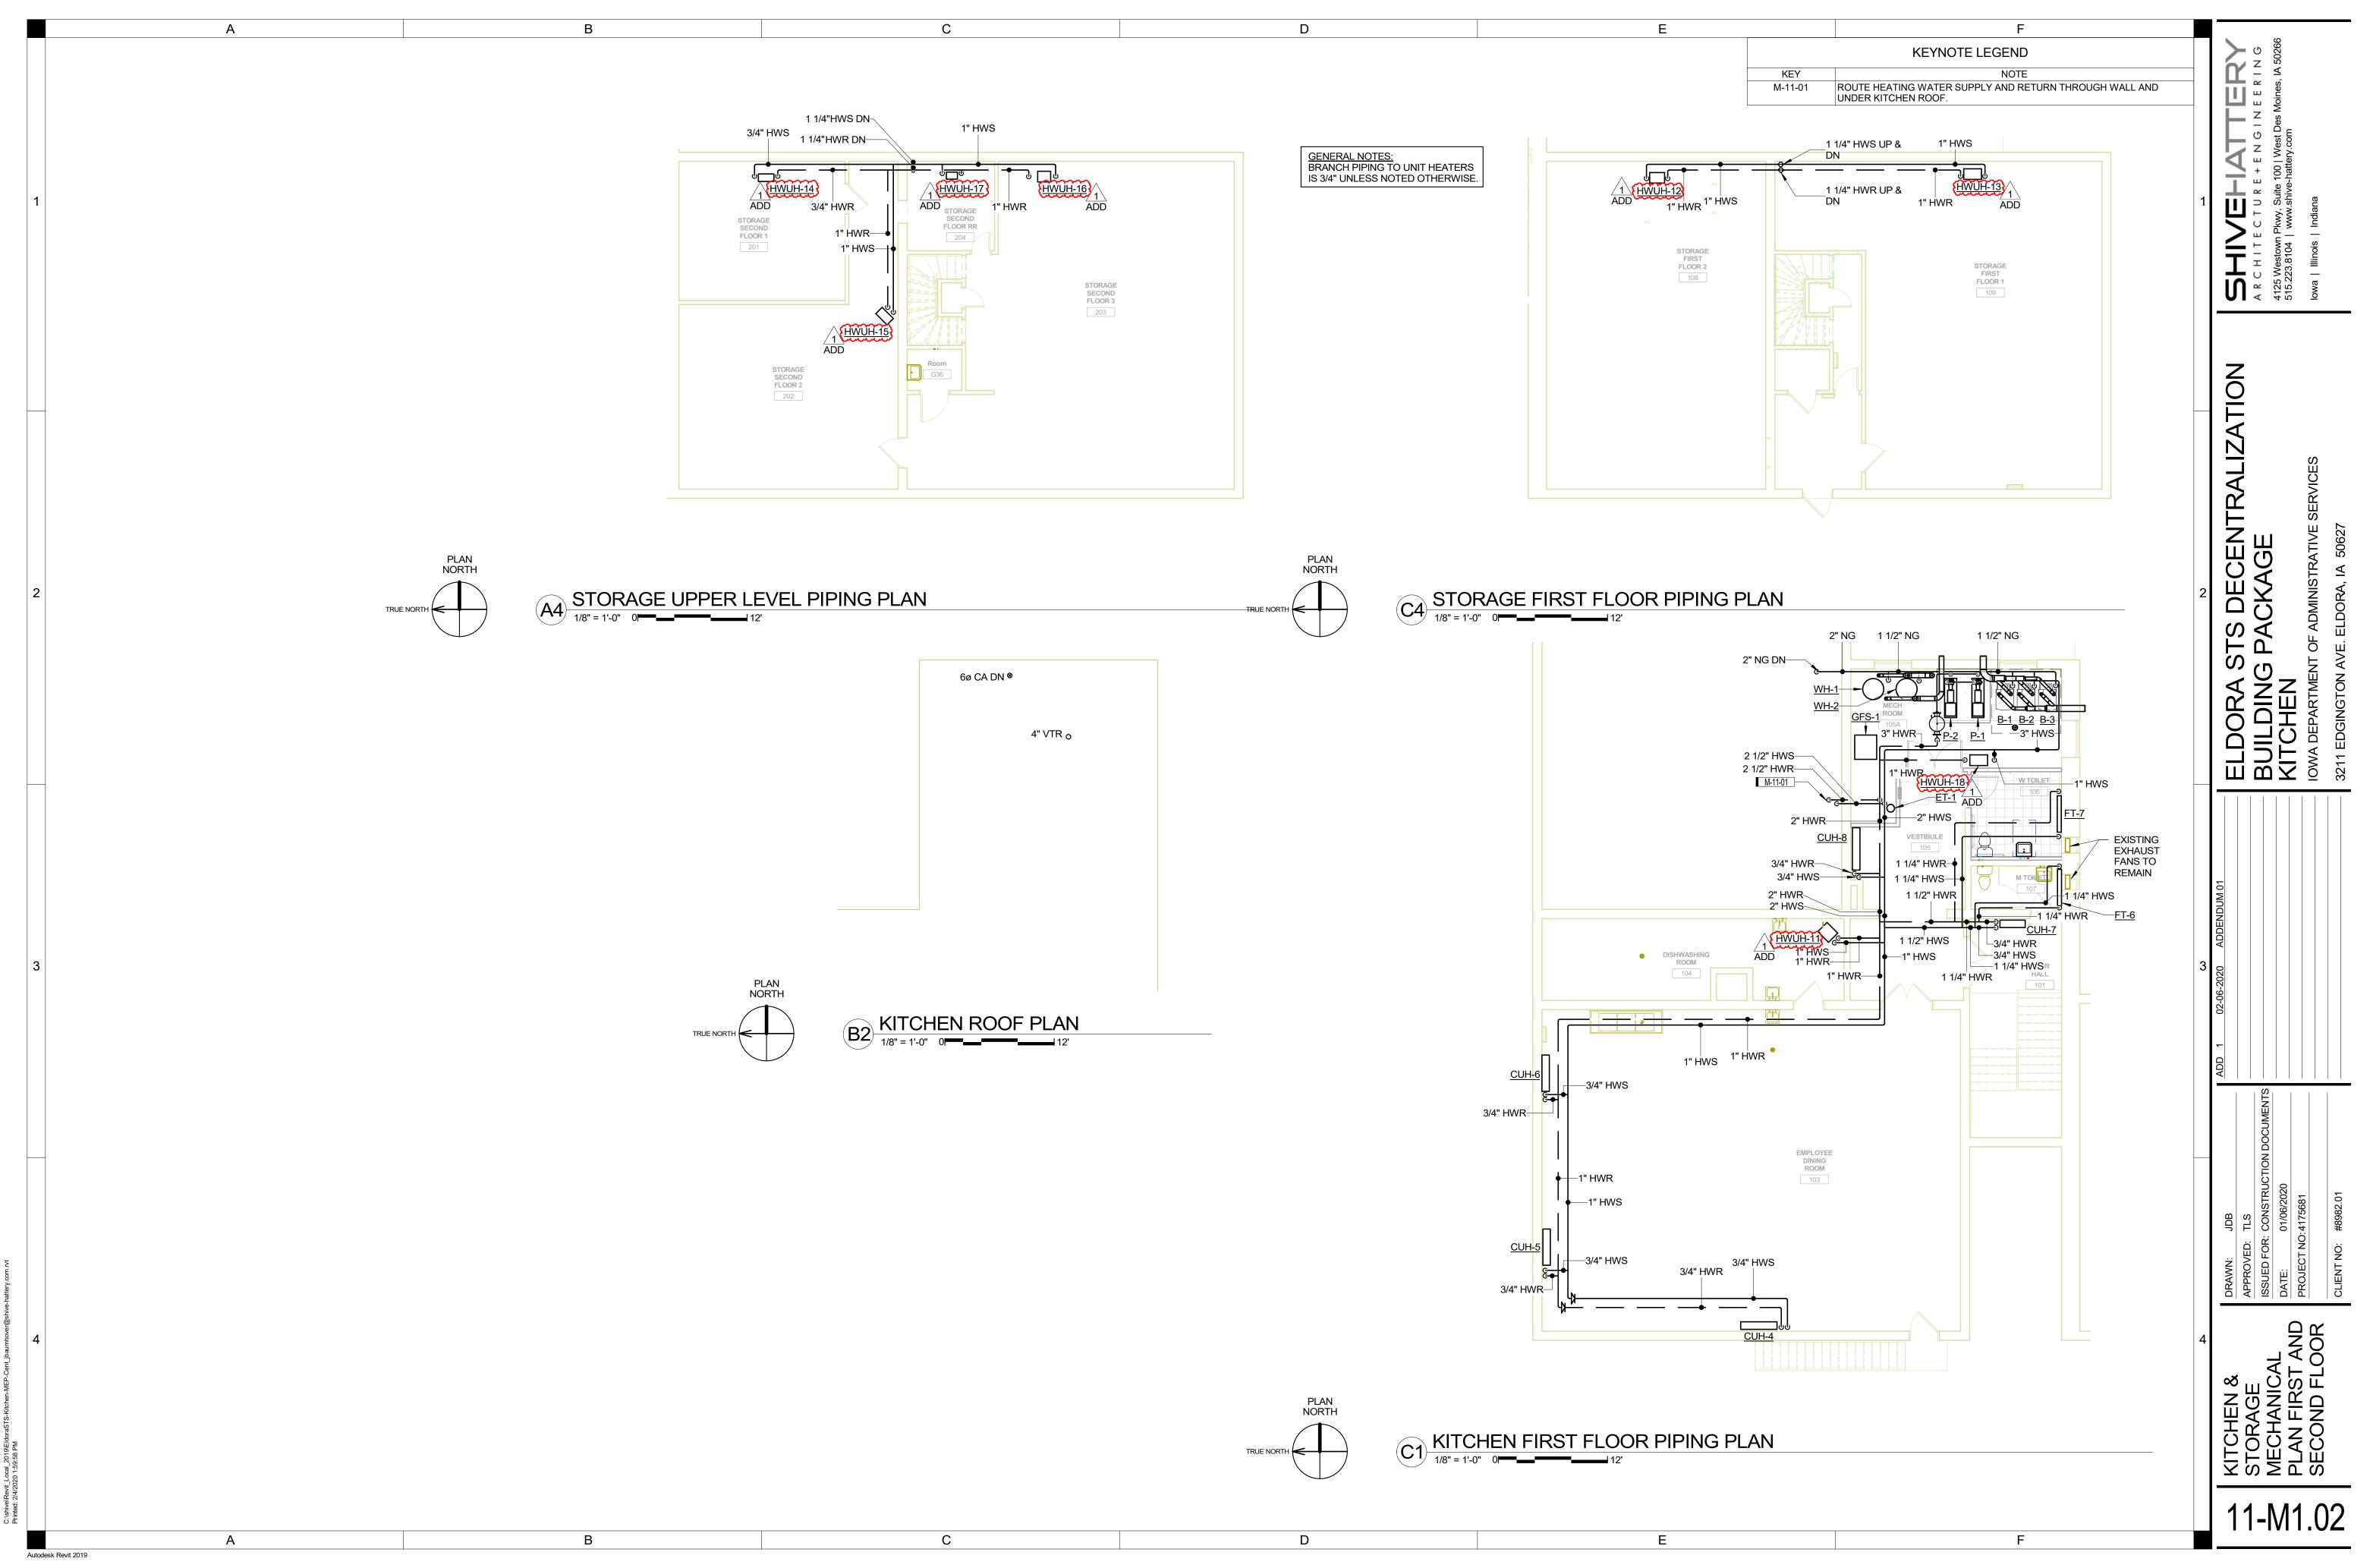

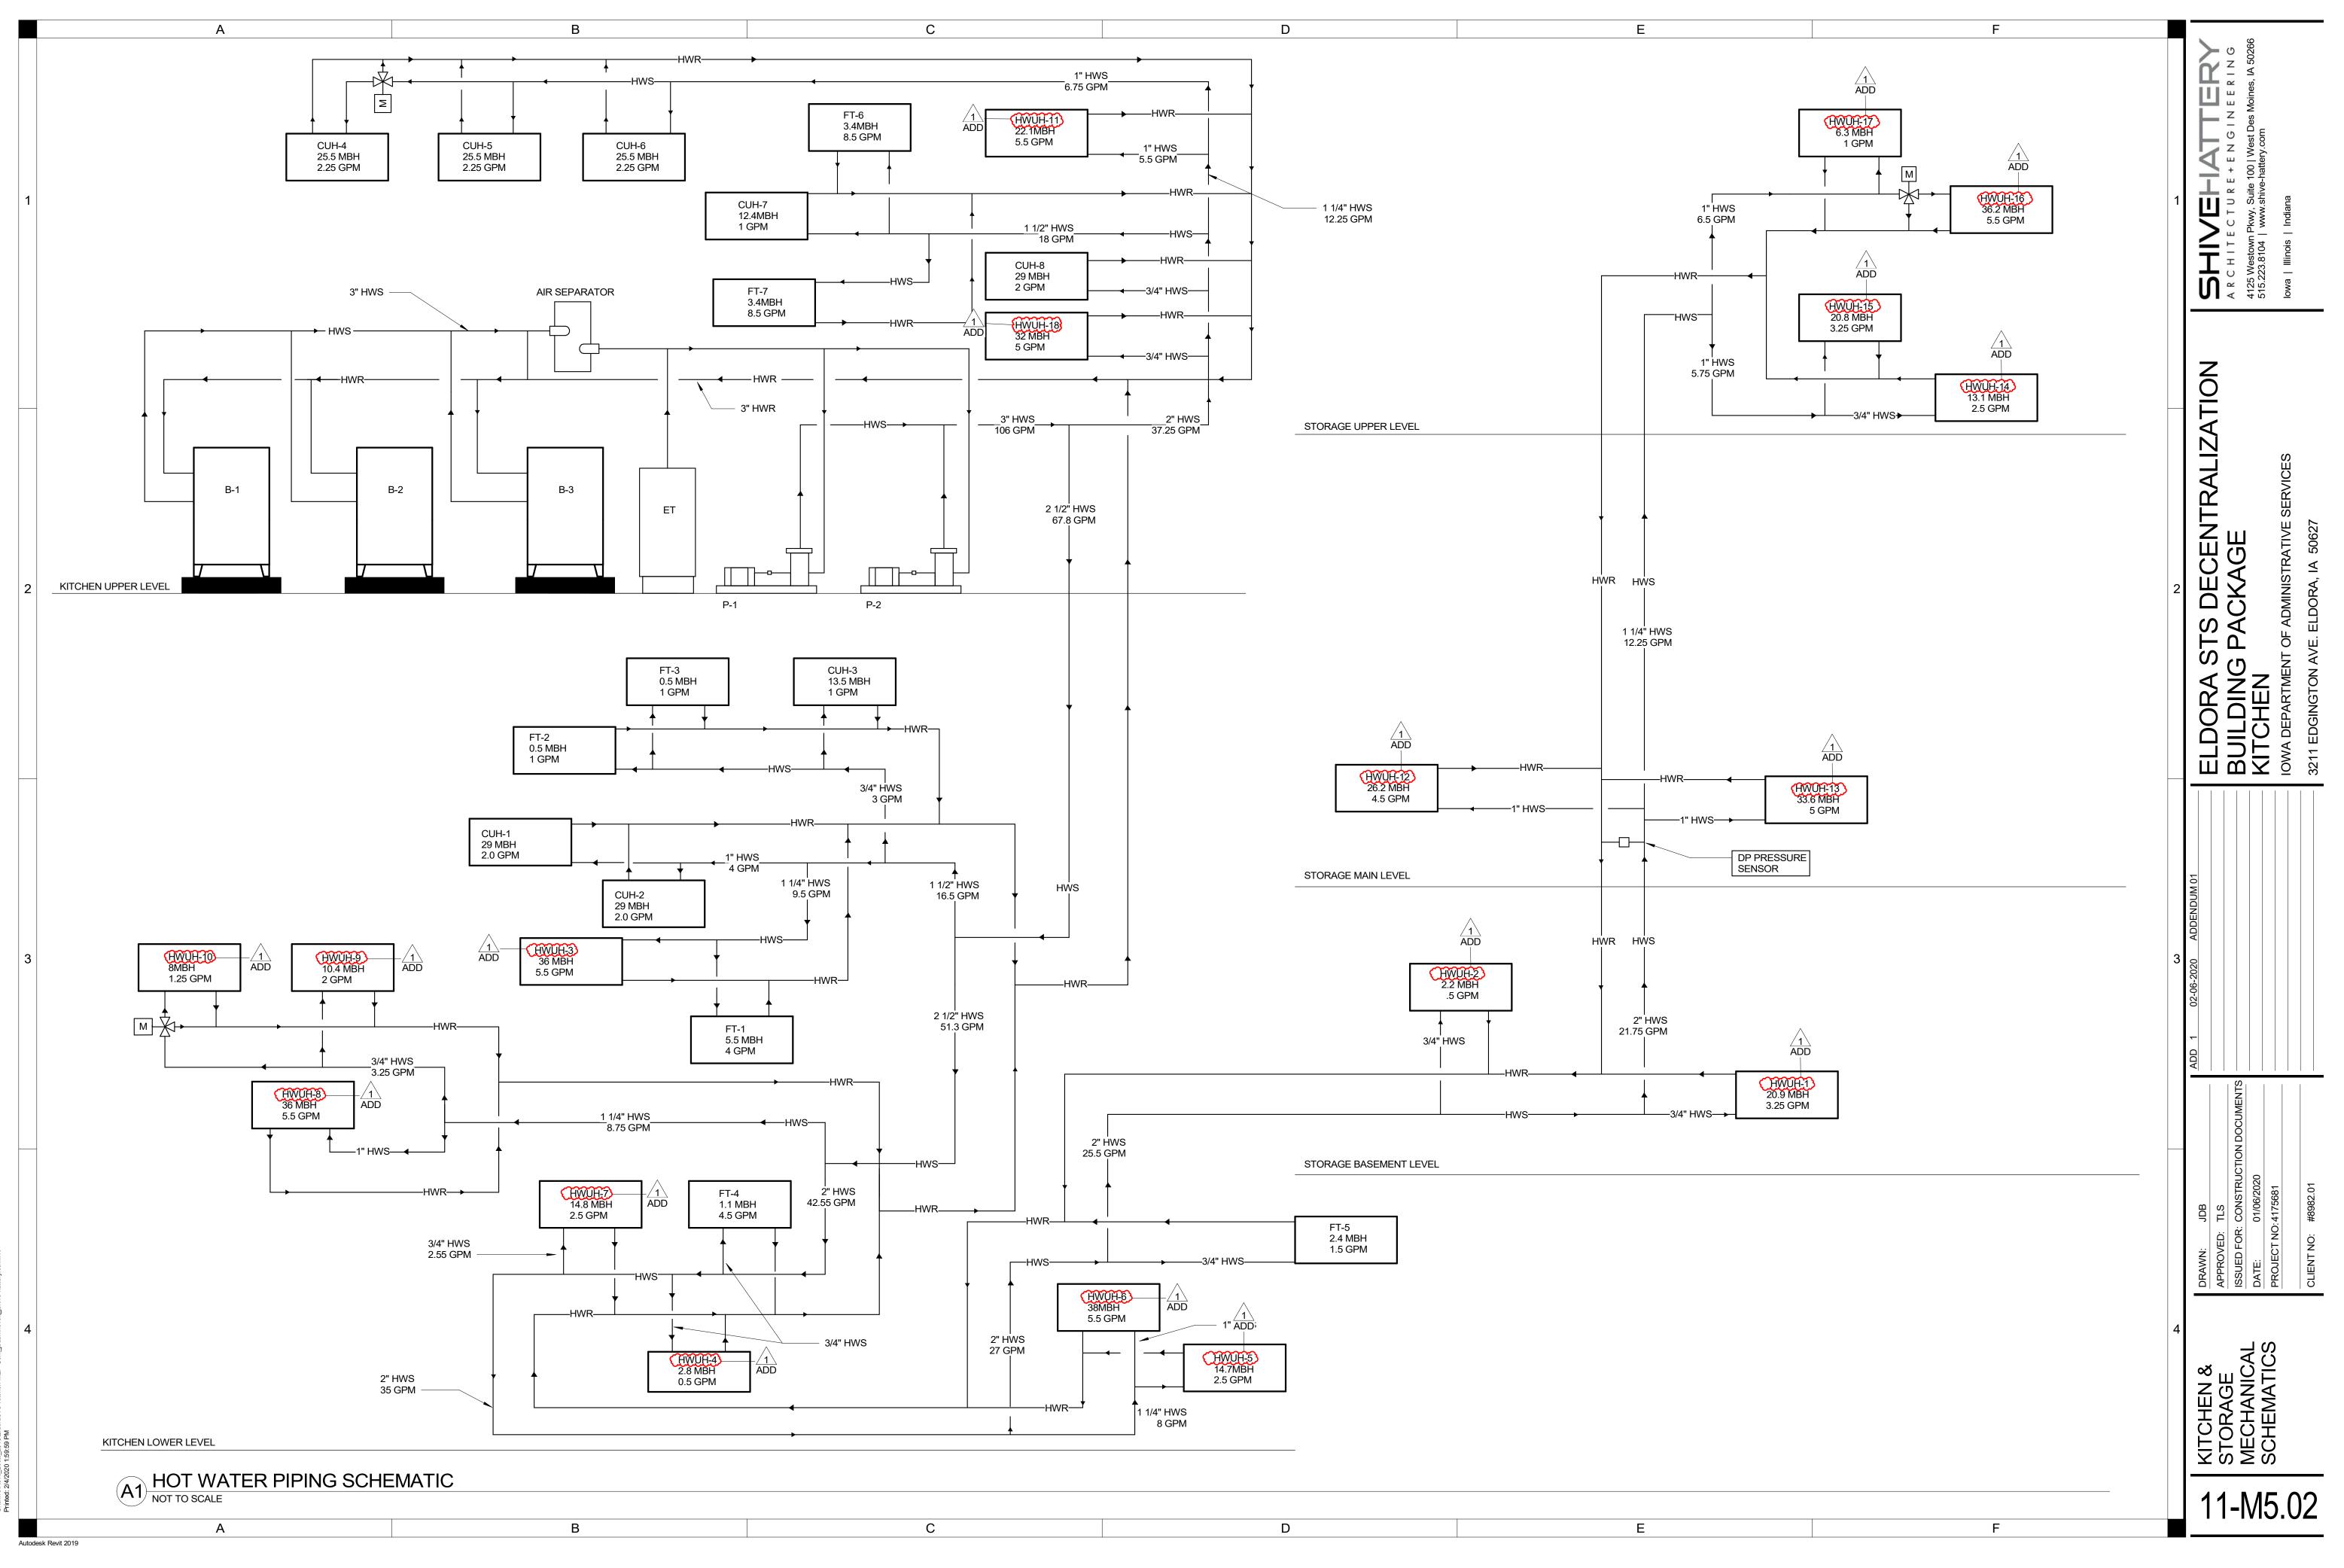

cent_jbaumhover@shive-hattery.com.rvt	
S-Kitchen-MEP-C	
hive\Revit_Local_	

	A	В	С	D	E	
				EQUIVALENT PRODUCTS BY MANUFACTURERS WHICH ARE NOT LISTED IN SCHEDULES OR IN SPECIFICATIONS MAY BE USED WITH PRE-APPROVAL FROM	MECHA	
				ENGINEER. SEE SPECIFICATIONS FOR SUBSTITUTION REQUEST INSTRUCTIONS.	MARK SYSTEM SERVED	
				NOTES:	YCOL FEED SYSTEM SCHEDULE	
				1. PROVIDE WITH PRE-MIXED 30% PROPYLENE GLYCOL SOLUTION. NO FIELD MIXING SHALL BE A 2. FURNISH AND INSTALL ALL PUMP CONTROLS AND WIRING. ADD 3. SYSTEM VOLUME APPROXIMATELY 150 GALLONS.		
				MARKSYSTEM SERVEDTANK CAPACITY (GAL)GPM @ 100 PSICUT IN RANGE (PSI)GFS-1HEATING WATER501.510-40	CUT OUT RANGE(PSI)         MOTOR DATA           20-60         1/3         120	
				MECHANI	CAL PUMP SCHEDULE	
			NOTES: 1. VARIABLE F	FREQUENCY DRIVE AND DISCONNECT TO BE PROVIDED AND INSTALLED BY ELECTRICAL CONTRACTOR.		
			2. PUMPS SEL 3. PUMPS SEL	LECTED FOR ONE PUMP TO BE LEAD AND ONE PUMP TO BE IN STAND-BY. LECTED AT 30% PROPYLENE GLYCOL. SYSTEM SHUTOFF HEAD	MOTOR DATA	
			MARK P-1 P-2	SERVED         TYPE         GPM         HEAD (FT)         (FT)         BHP           HWS         END SUCTION         72         37.00         42.00         1.04           HWS         END SUCTION         72         37.00         42.00         1.04	HP         VOLTS           1.5         208           1.5         208	
2			NOTES: 1. PERFORMA	ANCE BASED ON 30% PROPYLENE GLYCOL.	ATER SCHEDULE- HOT WATER	
			2. MANUFACT MARK	FURER SHALL PROVIDE FACTORY MOUNTED DISCONNECT.           AREA SERVED         CFM         EWT (°F)         LWT (°F)         EAT (°F)         LAT (°F)         MBH         GPM	MOUNTING MAX PD (FT) HEIGHT (FT) ORIENTATIO	
			CUH-1 CUH-2 CUH-3	BAKERY         479         140         110         60         115         29         2.00           BAKERY         479         140         110         60         115         29         2.00           CORRIDOR L102         256         140         107         60         109         13.5         1.00	4 0' - 0" VERTICAI 4 0' - 0" VERTICAI	
			CUH-4 CUH-5	DINING U103         541         140         114         60         103         25.5         2.25           DINING U103         541         140         114         60         103         25.5         2.25	4 0' - 0" VERTICAI 4 0' - 0" VERTICAI	
			CUH-6 CUH-7 CUH-8	DINING U103         541         140         114         60         103         25.5         2.25           VESTIBULE U102         277         140         111         60         101         12.4         1.00           LOUNGE U105         479         140         110         60         115         29         2.00	4 0' - 0" VERTICAI	
					TION SCHEDULE - HYDRONIC	
			NOTES: 1. PERFORMA	ANCE BASED ON 30% PROPYLENE GLYCOL.		
			MARK (BT		ING COIL FIN DATAFIN WIDTH (IN)FINS PER FOOT4 1/4"5072"	
			FT-2 5	533         140         1.0         0.75         1         1' - 0"         60         4 1/4"           533         140         1.0         0.75         1         1' - 0"         60         4 1/4"	4 1/4" 40 12"	
				<b>566 140 4.5 0.75 1 2' 0" 60 4.1/4"</b>	4 1/4" 40 12"	
			FT-5 T FT-6 8	566         140         4.5         0.75         1         2' - 0"         60         4 1/4"           791         140         1.5         0.75         3         3' - 0"         60         4 1/4"           855         140         8.5         1         3         4' - 0"         60         4 1/4"	4 1/4"4012"4 1/4"4024"4 1/4"3236"4 1/4"3248"	
3			FT-5 FT-6 8	791         140         1.5         0.75         3         3' - 0"         60         4 1/4"	4 1/4"         40         12"           4 1/4"         40         24"           4 1/4"         32         36"	
3			FT-5 FT-6 FT-7 8	791         140         1.5         0.75         3         3' - 0"         60         4 1/4"           855         140         8.5         1         3         4' - 0"         60         4 1/4"           855         140         8.5         1         3         4' - 0"         60         4 1/4"	4 1/4"4012"4 1/4"4024"4 1/4"3236"4 1/4"3248"	
3			FT-5     T       FT-6     8       FT-7     8       NOTES:     1. PERFORMA	791         140         1.5         0.75         3         3' - 0"         60         4 1/4"           855         140         8.5         1         3         4' - 0"         60         4 1/4"           855         140         8.5         1         3         4' - 0"         60         4 1/4"	4 1/4"       40       12"         4 1/4"       40       24"         4 1/4"       32       36"         4 1/4"       32       48"         4 1/4"       32       48"	
3			FT-5     T       FT-6     8       FT-7     8       NOTES:     1. PERFORMA	791         140         1.5         0.75         3         3' - 0"         60         4 1/4"           855         140         8.5         1         3         4' - 0"         60         4 1/4"           855         140         8.5         1         3         4' - 0"         60         4 1/4"           855         140         8.5         1         3         4' - 0"         60         4 1/4"           UNIT HEATEF           ANCE BASED ON 30% PROPYLENE GLYCOL.	4 1/4"       40       12"         4 1/4"       40       24"         4 1/4"       32       36"         4 1/4"       32       48"         4 1/4"       32       48"         4 1/4"       32       48"         2 1/4"       32       48"         8 SCHEDULE - HOT WATER       MOUNTING	
3			FT-5       T         FT-6       8         FT-7       8         NOTES:       1. PERFORMA         2. MANUFACT       MARK         HWUH-1       HWUH-2         HWUH-3       HWUH-3	791       140       1.5       0.75       3       3' - 0"       60       4 1/4"         855       140       8.5       1       3       4' - 0"       60       4 1/4"         855       140       8.5       1       3       4' - 0"       60       4 1/4"         855       140       8.5       1       3       4' - 0"       60       4 1/4"         UNIT HEATER         BASED ON 30% PROPYLENE GLYCOL.         TURER SHALL PROVIDE FACTORY MOUNTED DISCONNECT.         AREA SERVED       CFM       EWT (°F)       LWT (°F)       LAT (°F)       MBH         STORAGE BASEMENT       900       140 °F       110 °F       112 °F       20.9       36         STORAGE BASEMENT       245       140 °F       110 °F       91 °F       2.2       36         KITCHEN L107       1800       140 °F       110 °F       103 °F       36	4 1/4"       40       12"         4 1/4"       40       24"         4 1/4"       32       36"         4 1/4"       32       48"         4 1/4"       32       48"         4 1/4"       32       48"         4 1/4"       32       48"         4 1/4"       32       48"         4 1/4"       32       48"         4 1/4"       32       48"         4 1/4"       32       48"         6 GPM       MAX PD (FT)       MOUNTING         1 3.25       1       8'-0"         0.50       1       8'-0"         5.50       1       10'-0"	
3			FT-5       T         FT-6       8         FT-7       8         NOTES:       1. PERFORMA         2. MANUFACT       MARK         HWUH-1       HWUH-2         HWUH-3       HWUH-4         HWUH-4       HWUH-5         HWUH-6       1	791         140         1.5         0.75         3         3'-0"         60         4 1/4"           855         140         8.5         1         3         4'-0"         60         4 1/4"           855         140         8.5         1         3         4'-0"         60         4 1/4"           855         140         8.5         1         3         4'-0"         60         4 1/4"           UNIT HEATER           AREA SERVED CL. FURER SHALL PROVIDE FACTORY MOUNTED DISCONNECT.           AREA SERVED         CFM         EWT (°F)         LWT (°F)         LAT (°F)         MBH           STORAGE BASEMENT         900         140 °F         110 °F         112 °F         20.9         9           STORAGE BASEMENT         245         140 °F         110 °F         91 °F         2.2         2           KITCHEN L107         1800         140 °F         110 °F         91 °F         2.8         36           STORAGE L109         245         140 °F         110 °F         91 °F         2.8         36           STORAGE G113         750         140 °F         110 °F         111 °F	4 1/4"       40       12"         4 1/4"       40       24"         4 1/4"       32       36"         4 1/4"       32       48"         4 1/4"       32       48"         4 1/4"       32       48"         4 1/4"       32       48"         4 1/4"       32       48"         4 1/4"       32       48"         2 48"       41/4"       32       48"         8 SCHEDULE - HOT WATER       MOUNTING         GPM       MAX PD (FT)       HEIGHT (FT         3.25       1       8' - 0"         0.50       1       8' - 0"         5.50       1       10' - 0"         0.50       1       8' - 0"         2.50       1       8' - 0"         5.50       1       8' - 0"	
			FT-5       1         FT-7       8         FT-7       8         I. PERFORMA       2         MARK       HWUH-1         HWUH-2       HWUH-3         HWUH-3       HWUH-4         HWUH-5       1         HWUH-6       ADD         HWUH-7       HWUH-8	791         140         1.5         0.75         3         3'-0"         60         4 1/4"           855         140         8.5         1         3         4'-0"         60         4 1/4"           855         140         8.5         1         3         4'-0"         60         4 1/4"           855         140         8.5         1         3         4'-0"         60         4 1/4"           UNIT HEATER           ANCE BASED ON 30% PROPYLENE GLYCOL. TURER SHALL PROVIDE FACTORY MOUNTED DISCONNECT.           AREA SERVED         CFM         EWT (°F)         LWT (°F)         LAT (°F)         MBH           STORAGE BASEMENT         900         140 °F         110 °F         112 °F         20.9           STORAGE BASEMENT         245         140 °F         110 °F         91 °F         2.2           KITCHEN L107         1800         140 °F         110 °F         91 °F         2.8           BREAKROOM G113         750         140 °F         110 °F         111 °F         14.7           STORAGE G115         1800         140 °F         110 °F         101 °F         38           PREPARATION L117         750         140 °F	4 1/4"       40       12"         4 1/4"       40       24"         4 1/4"       32       36"         4 1/4"       32       48"         4 1/4"       32       48"         4 1/4"       32       48"         4 1/4"       32       48"         4 1/4"       32       48"         4 1/4"       32       48"         SCHEDULE - HOT WATER       HEIGHT (FT         3.25       1       8'-0"         0.50       1       8'-0"         5.50       1       10'-0"         0.50       1       8'-0"         2.50       1       8'-0"         2.50       1       8'-0"         2.50       1       8'-0"         5.50       1       8'-0"         5.50       1       8'-0"         5.50       1       8'-0"         5.50       1       8'-0"         5.50       1       10'-0"	
			FT-5       FT-6       8         FT-7       8         NOTES:       1. PERFORMA         2. MANUFACT       MARK         HWUH-1       HWUH-2         HWUH-3       HWUH-3         HWUH-4       HWUH-5         1       HWUH-7	791         140         1.5         0.75         3         3' - 0"         60         4 1/4"           855         140         8.5         1         3         4' - 0"         60         4 1/4"           855         140         8.5         1         3         4' - 0"         60         4 1/4"           855         140         8.5         1         3         4' - 0"         60         4 1/4"           UNIT HEATER           STORAGE BASEMENT         00         140 °F         110 °F         112 °F         20.9           STORAGE BASEMENT         900         140 °F         110 °F         112 °F         20.9           STORAGE BASEMENT         245         140 °F         110 °F         91 °F         2.2           KITCHEN L107         1800         140 °F         110 °F         91 °F         2.8           BREAKROOM G113         750         140 °F         110 °F         111 °F         14.7           STORAGE G115         1800         140 °F         110 °F         103 °F         36           STORAGE G115         1800         140 °F         110 °F         111 °F         14.7	4 1/4"       40       12"         4 1/4"       40       24"         4 1/4"       32       36"         4 1/4"       32       48"         4 1/4"       32       48"         4 1/4"       32       48"         4 1/4"       32       48"         4 1/4"       32       48"         4 1/4"       32       48"         4 1/4"       32       48"         4 1/4"       32       48"         2 SCHEDULE - HOT WATER       MOUNTING         Below       MAX PD (FT)       HEIGHT (FT)         1 3.25       1       8' - 0"         0.50       1       8' - 0"         0.50       1       8' - 0"         0.50       1       8' - 0"         2.50       1       8' - 0"         2.50       1       8' - 0"	
			FT-5       FT-6       8         FT-7       8         NOTES:       1. PERFORMA         2. MANUFACT         MARK         HWUH-1         HWUH-2         HWUH-3         HWUH-4         HWUH-5         1         HWUH-6         ADD         HWUH-10         HWUH-11         HWUH-12         HWUH-13	791         140         1.5         0.75         3         3'-0"         60         4 1/4"           855         140         8.5         1         3         4'-0"         60         4 1/4"           855         140         8.5         1         3         4'-0"         60         4 1/4"           855         140         8.5         1         3         4'-0"         60         4 1/4"           UNIT HEATER           Storage based of 4'-0"         60         4 1/4"           UNIT HEATER           AREA SERVED         CFM         EWT (°F)         LWT (°F)         LAT (°F)         MBH           STORAGE BASEMENT         900         140 °F         110 °F         112 °F         20.9           STORAGE BASEMENT         245         140 °F         110 °F         91 °F         2.2           KITCHEN L107         1800         140 °F         110 °F         113 °F         36           STORAGE L109         245         140 °F         110 °F         111 °F         14.7           STORAGE G115         1800         140 °F         110 °F         111 °F         14.7           STORAGE G115         1	4 1/4"       40       12"         4 1/4"       32       36"         4 1/4"       32       48"         4 1/4"       32       48"         4 1/4"       32       48"         4 1/4"       32       48"         4 1/4"       32       48"         4 1/4"       32       48"         2       48"       48"         32       48"       48"         32       48"       48"         CENEDULE - HOT WATER       HEIGHT (FT)         3.25       1       8' - 0"         0.50       1       8' - 0"         5.50       1       8' - 0"         5.50       1       8' - 0"         2.50       1       8' - 0"         2.50       1       8' - 0"         2.50       1       8' - 0"         5.50       1       8' - 0"         2.50       1       8' - 0"         5.50       1       8' - 0"         4.50       1       8' - 0"         5.50       1       8' - 0"         5.50       1       8' - 0"         5.50       1       8' - 0"	
			FT-5       FT-6       8         FT-7       8         NOTES:       1. PERFORMA         2. MANUFACT         MARK         HWUH-1         HWUH-2         HWUH-3         HWUH-4         HWUH-5         1       HWUH-6         ADD       HWUH-7         HWUH-8         HWUH-9         HWUH-10         HWUH-13         HWUH-14	791         140         1.5         0.75         3         3'-0"         60         4 1/4"           855         140         8.5         1         3         4'-0"         60         4 1/4"           855         140         8.5         1         3         4'-0"         60         4 1/4"           855         140         8.5         1         3         4'-0"         60         4 1/4"           855         140         8.5         1         3         4'-0"         60         4 1/4"           UNIT HEATER           STORAGE BASEMENT         245         140 °F         110 °F         12 °F         20.9            245	4 1/4"       40       12"         4 1/4"       32       36"         4 1/4"       32       48"         4 1/4"       32       48"         4 1/4"       32       48"         4 1/4"       32       48"         4 1/4"       32       48"         2       48"       48"         4 1/4"       32       48"         2       48"       48"         2       48"       48"         32       48"       48"         2       48"       48"         32       48"       48"         4 1/4"       32       48"         4 1/4"       32       48"         4 1/4"       32       48"         4 1/4"       32       48"         4 1/4"       32       48"         4 1/4"       32       48"         4 1/4"       32       48"         4 1/4"       32       48"         4 1/4"       32       48"         4 1/4"       32       48"         4 1/4"       10"       10"         5.50       1       8'-0"         5.50	
			FT-5       FT-6       8         FT-7       8         NOTES:       1. PERFORMA         2. MANUFACT         MARK         HWUH-1         HWUH-2         HWUH-3         HWUH-4         HWUH-5         HWUH-6         ADD         HWUH-8         HWUH-9         HWUH-10         HWUH-11         HWUH-12         HWUH-13         HWUH-14	791         140         1.5         0.75         3         3' - 0"         60         4 1/4"           855         140         8.5         1         3         4' - 0"         60         4 1/4"           855         140         8.5         1         3         4' - 0"         60         4 1/4"           855         140         8.5         1         3         4' - 0"         60         4 1/4"           UNIT HEATER           STORAGE BASED ON 30% PROPYLENE GLYCOL. FURER SHALL PROVIDE FACTORY MOUNTED DISCONNECT.           AREA SERVED         CFM         EWT (°F)         LWT (°F)         LAT (°F)         MBH           STORAGE BASEMENT         900         140 °F         110 °F         112 °F         20.9           STORAGE BASEMENT         245         140 °F         110 °F         91 °F         2.2           KITCHEN L107         1800         140 °F         110 °F         91 °F         2.8           STORAGE G113         750         140 °F         110 °F         111 °F         14.7           STORAGE G115         1800         140 °F         110 °F         103 °F         36           PREPARATION L117         750         140 °F <td>4 1/4"       40       12"         4 1/4"       32       36"         4 1/4"       32       48"         4 1/4"       32       48"         4 1/4"       32       48"         4 1/4"       32       48"         4 1/4"       32       48"         4 1/4"       32       48"         4 1/4"       32       48"         2 SCHEDULE - HOT WATER       HEIGHT (FT)         3.25       1       8' - 0"         0.50       1       8' - 0"         5.50       1       10' - 0"         0.50       1       8' - 0"         2.50       1       8' - 0"         2.50       1       8' - 0"         2.50       1       8' - 0"         1.25       1       8' - 0"         1.25       1       8' - 0"         4.50       1       8' - 0"         4.50       1       8' - 0"         5.50       1       8' - 0"         5.50       1       8' - 0"         5.50       1       8' - 0"         4.50       1       8' - 0"         5.00       1       8' - 0</td>	4 1/4"       40       12"         4 1/4"       32       36"         4 1/4"       32       48"         4 1/4"       32       48"         4 1/4"       32       48"         4 1/4"       32       48"         4 1/4"       32       48"         4 1/4"       32       48"         4 1/4"       32       48"         2 SCHEDULE - HOT WATER       HEIGHT (FT)         3.25       1       8' - 0"         0.50       1       8' - 0"         5.50       1       10' - 0"         0.50       1       8' - 0"         2.50       1       8' - 0"         2.50       1       8' - 0"         2.50       1       8' - 0"         1.25       1       8' - 0"         1.25       1       8' - 0"         4.50       1       8' - 0"         4.50       1       8' - 0"         5.50       1       8' - 0"         5.50       1       8' - 0"         5.50       1       8' - 0"         4.50       1       8' - 0"         5.00       1       8' - 0	
			FT-5         FT-6         FT-7         0         MARK         HWUH-1         HWUH-2         HWUH-3         HWUH-4         HWUH-5         1         HWUH-6         ADD         HWUH-7         HWUH-8         HWUH-9         HWUH-10         HWUH-11         HWUH-12         HWUH-13         HWUH-14         HWUH-15         HWUH-16         HWUH-17	791         140         1.5         0.75         3         3'-0"         60         4 1/4"           855         140         8.5         1         3         4'-0"         60         4 1/4"           855         140         8.5         1         3         4'-0"         60         4 1/4"           855         140         8.5         1         3         4'-0"         60         4 1/4"           855         140         8.5         1         3         4'-0"         60         4 1/4"           855         140         8.5         1         3         4'-0"         60         4 1/4"           UNIT HEATER           ARCE BASED ON 30% PROPYLENE GLYCOL.           TURER SHALL PROVIDE FACTORY MOUNTED DISCONNECT.           AREA SERVED         CFM         EWT (*F)         LWT (*F)         LAT (*F)         MBH           STORAGE BASEMENT         245         140 °F         110 °F         91 °F         2.2           KITCHEN L107         1800         140 °F         110 °F         101 °F         14.7           STORAGE G115         1800         140 °F         110 °F         111 °F         14.7           STORAG	4 1/4"         40         12"           4 1/4"         32         36"           4 1/4"         32         48"           4 1/4"         32         48"           4 1/4"         32         48"           4 1/4"         32         48"           4 1/4"         32         48"           2 1/4"         32         48"           4 1/4"         32         48"           2 SCHEDULE - HOT WATER         HEIGHT (FT)           3.25         1         8' - 0"           0.50         1         8' - 0"           0.50         1         8' - 0"           5.50         1         10' - 0"           2.50         1         8' - 0"           2.50         1         8' - 0"           2.50         1         8' - 0"           2.50         1         8' - 0"           5.50         1         8' - 0"           5.50         1         8' - 0"           4.50         1         8' - 0"           5.50         1         8' - 0"           4.50         1         8' - 0"           3.25         1         8' - 0"	
			FT-5       FT-6       3         FT-7       8         NOTES:       1. PERFORMA         2. MANUFACT         MARK         HWUH-1         HWUH-2         HWUH-3         HWUH-4         HWUH-5         1         HWUH-6         ADD         HWUH-7         HWUH-10         HWUH-11         HWUH-12         HWUH-13         HWUH-14         HWUH-15         HWUH-16         HWUH-17         HWUH-18	791         140         1.5         0.75         3         3'-0"         60         4 1/4"           855         140         8.5         1         3         4'-0"         60         4 1/4"           855         140         8.5         1         3         4'-0"         60         4 1/4"           UNIT HEATER           STORAGE BASEMENT         3         4'-0"         60         4 1/4"           UNIT HEATER           ARCE BASED ON 30% PROPYLENE GLYCOL.           UNIT HEATER           AREA SERVED         CFM         EWT ("F)         LWT ("F)         LAT ("F)         MBH           STORAGE BASEMENT         900         140 "F         110 "F         91 "F         2.2           KITCHEN L107         1800         140 "F         110 "F         91 "F         2.8           BREAKROOM G113         750         140 "F         110 "F         103 "F         36           STORAGE G115         1800         140 "F         110 "F         103 "F         38           PREPARATION L117         750         140 "F         110 "F         103 "F         36           DISHWASHING ROOM U104         140	4 1/4"         40         12"           4 1/4"         32         36"           4 1/4"         32         48"           4 1/4"         32         48"           4 1/4"         32         48"           4 1/4"         32         48"           4 1/4"         32         48"           4 1/4"         32         48"           2         48"         48"           2         48"         48"           2         48"         48"           32         48"         48"           32         48"         48"           4 1/4"         32         48"           4 1/4"         32         48"           4 1/4"         32         48"           4 1/4"         32         48"           4 1/4"         32         48"           4 1/4"         32         48"           4 1/4"         32         48"           4 1/4"         32         48"           4 1/4"         32         48"           4 1/4"         32         48"           4 1/4"         32         48"           4 1/4"         1	
			FT-5       FT-6       Ø         FT-7       8         NOTES:       1. PERFORMA         2. MANUFACT       MARK         HWUH-1       HWUH-2         HWUH-3       HWUH-3         HWUH-4       HWUH-7         HWUH-9       HWUH-9         HWUH-10       HWUH-10         HWUH-11       HWUH-12         HWUH-12       HWUH-13         HWUH-13       HWUH-14         HWUH-14       HWUH-16         HWUH-18       HWUH-18         HWUH-18       HWUH-18         HWUH-18       HWUH-18	791         140         1.5         0.75         3         3'-0"         60         4 1/4"           855         140         8.5         1         3         4'-0"         60         4 1/4"           855         140         8.5         1         3         4'-0"         60         4 1/4"           UNIT HEATER           Storage based of the s	4 1/4"         40         12"           4 1/4"         40         24"           4 1/4"         32         36"           4 1/4"         32         48"           4 1/4"         32         48"           4 1/4"         32         48"           4 1/4"         32         48"           2         48"         48"           32         48"         48"           32         48"         48"           CPM         MAX PD (FT)         HEIGHT (FT)           3.25         1         8'-0"           0.50         1         8'-0"           5.50         1         10'-0"           0.50         1         8'-0"           2.50         1         8'-0"           5.50         1         10'-0"           2.50         1         8'-0"           5.50         1         8'-0"           5.50         1         8'-0"           4.50         1         8'-0"           5.50         1         8'-0"           5.50         1         8'-0"           3.25         1         8'-0"           5.00	
			FT-5       FT-6       8         FT-7       8         NOTES:       1. PERFORMA       2. MANUFACT         MARK       HWUH-1       HWUH-2         HWUH-3       HWUH-3       HWUH-4         HWUH-4       HWUH-3       HWUH-4         HWUH-5       HWUH-10       HWUH-10         HWUH-11       HWUH-10       HWUH-10         HWUH-13       HWUH-112       HWUH-13         HWUH-14       HWUH-16       HWUH-17         HWUH-18       HWUH-16       HWUH-17         HWUH-18       HWUH-16       HWUH-17         HWUH-18       HWUH-18       HWUH-16         HWUH-17       HWUH-18       HWUH-18	791         140         1.5         0.75         3         3'-0"         60         4 1/4"           855         140         8.5         1         3         4'-0"         60         4 1/4"           855         140         8.5         1         3         4'-0"         60         4 1/4"           UNIT HEATER           Storage based of the s	4 1/4"         40         12"           4 1/4"         40         24"           4 1/4"         32         36"           4 1/4"         32         48"           4 1/4"         32         48"           4 1/4"         32         48"           4 1/4"         32         48"           4 1/4"         32         48"           2 SCHEDULE - HOT WATER         MOUNTING HEIGHT (FT)           3.25         1         8'-0"           0.50         1         8'-0"           0.50         1         8'-0"           5.50         1         10'-0"           0.50         1         8'-0"           2.50         1         8'-0"           2.50         1         8'-0"           2.50         1         8'-0"           2.50         1         8'-0"           2.50         1         8'-0"           3.25         1         8'-0"           3.25         1         8'-0"           3.25         1         8'-0"           3.25         1         8'-0"           3.25         1         8'-0"           5.00	
			FT-5       FT-6       8         FT-7       8         NOTES:       1. PERFORMA       2. MANUFACT         MARK       HWUH-1       HWUH-2         HWUH-3       HWUH-3       HWUH-4         HWUH-4       HWUH-3       HWUH-4         HWUH-5       HWUH-10       HWUH-10         HWUH-11       HWUH-10       HWUH-10         HWUH-13       HWUH-112       HWUH-13         HWUH-14       HWUH-16       HWUH-17         HWUH-18       HWUH-16       HWUH-17         HWUH-18       HWUH-16       HWUH-17         HWUH-18       HWUH-18       HWUH-16         HWUH-17       HWUH-18       HWUH-18	791         140         1.5         0.75         3         3'-0"         60         4 1/4"           855         140         8.5         1         3         4'-0"         60         4 1/4"           855         140         8.5         1         3         4'-0"         60         4 1/4"           UNIT HEATER           AREA SERVED         CFM         EWT ("F)         LWT ("F)         LAT ("F)         MBH           STORAGE BASEMENT         245         140 "F         110 "F         103 "F         28           STORAGE LIOP         245         140 "F         110 "F         101 "F         141         14 <td colspa<="" td=""><td>4 1/4"         40         12"           4 1/4"         40         24"           4 1/4"         32         36"           4 1/4"         32         48"           4 1/4"         32         48"           4 1/4"         32         48"           4 1/4"         32         48"           4 1/4"         32         48"           2 SCHEDULE - HOT WATER         MOUNTING HEIGHT (FT           3.25         1         8' - 0"           0.50         1         8' - 0"           5.50         1         10' - 0"           0.50         1         8' - 0"           2.50         1         8' - 0"           2.50         1         8' - 0"           2.50         1         8' - 0"           2.50         1         8' - 0"           2.50         1         8' - 0"           1.25         1         8' - 0"           1.25         1         8' - 0"           3.25         1         8' - 0"           3.25         1         8' - 0"           3.25         1         8' - 0"           3.25         1         8' - 0"</td></td>	<td>4 1/4"         40         12"           4 1/4"         40         24"           4 1/4"         32         36"           4 1/4"         32         48"           4 1/4"         32         48"           4 1/4"         32         48"           4 1/4"         32         48"           4 1/4"         32         48"           2 SCHEDULE - HOT WATER         MOUNTING HEIGHT (FT           3.25         1         8' - 0"           0.50         1         8' - 0"           5.50         1         10' - 0"           0.50         1         8' - 0"           2.50         1         8' - 0"           2.50         1         8' - 0"           2.50         1         8' - 0"           2.50         1         8' - 0"           2.50         1         8' - 0"           1.25         1         8' - 0"           1.25         1         8' - 0"           3.25         1         8' - 0"           3.25         1         8' - 0"           3.25         1         8' - 0"           3.25         1         8' - 0"</td>	4 1/4"         40         12"           4 1/4"         40         24"           4 1/4"         32         36"           4 1/4"         32         48"           4 1/4"         32         48"           4 1/4"         32         48"           4 1/4"         32         48"           4 1/4"         32         48"           2 SCHEDULE - HOT WATER         MOUNTING HEIGHT (FT           3.25         1         8' - 0"           0.50         1         8' - 0"           5.50         1         10' - 0"           0.50         1         8' - 0"           2.50         1         8' - 0"           2.50         1         8' - 0"           2.50         1         8' - 0"           2.50         1         8' - 0"           2.50         1         8' - 0"           1.25         1         8' - 0"           1.25         1         8' - 0"           3.25         1         8' - 0"           3.25         1         8' - 0"           3.25         1         8' - 0"           3.25         1         8' - 0"

-	-	-	-	-

								RERS WHICH BE USED WITI	-		M			MECHAN	IC.
								3STITUTION F				MARI			YPI
												ET-1	HEATING	WATER BLA	
			NOTES:										SYSTEM SCH	EDULE	
			2. FURNIS	SH AND INS	E-MIXED 30 TALL ALL PU APPROXIMA	MP CON	TROLS AND	WIRING.	N. NO FIEL	.D MIXING S	HALL BE AL	LOWED. SEE S	PEC.		
			MAR GFS-		YSTEM SER EATING WA		TANK CA (GA 5	AL) 1	GPM @ 00 PSI 1.5	CUT IN RAN 10-4	· /	CUT OUT RANGE(PSI) 20-60	HP 1/3	MOTOR DATA VOLTS 120	
										М	ECHANIC	CAL PUMP S	CHEDULE		
1. 2.	PUMPS SEL	ECTED I	FOR ONE I	PUMP TO BE	E LEAD AND			INSTALLED B N STAND-BY.	Y ELECTR	ICAL CONTF	RACTOR.				
3.		S	/STEM							FF HEAD			MOTOR		
	MARK P-1 P-2		ERVED HWS HWS	END S	YPE SUCTION SUCTION		6PM 72 72	HEAD (FT) 37.00 37.00	42	FT) 2.00 2.00	BHP 1.04 1.04	HF 1.5	5 208	3	IAS 3 3
									C				DULE- HOT W		
1.					ENE GLYCO										
	MANUFACT		HALL PRO	VIDE FACTO			ONNECT.	EAT (°F)	LAT (°F)	MBH	GPM	MAX PD (F	MOUNTING T) HEIGHT (FT)	ORIENTATION	F
	CUH-1 CUH-2	BA	KERY KERY	479 479	140	,	110 110	60 60	115 115	29 29	2.00	4	0' - 0" 0' - 0"	VERTICAL	-
	CUH-3 CUH-4	CORRI	DOR L102 G U103	256 541	140		107 114	60 60	109 103	13.5 25.5	1.00 2.25	4	0' - 0" 0' - 0"	VERTICAL	+
	CUH-5	DININ	G U103	541	140		114	60	103	25.5	2.25	4	0' - 0"	VERTICAL	
	CUH-6 CUH-7		G U103 ULE U102	541 277	140		114 111	60 60	103 101	25.5	2.25	4	0' - 0"	VERTICAL VERTICAL	+
	CUH-8	LOUN	GE U105	479	140		110	60	115	29	2.00	4	0' - 0"	VERTICAL	
										FIN TUBI	E RADIA	TION SCHEE	ULE - HYDRC	NIC	
					ENE GLYCO										
	ARK (BT	ACITY U/FT)	EWT (°F)	GPM	TUBE SIZE (IN)		BER OF OR ROWS	ELEMENT LENGTH (FT	, , ,	FIN HEIG		ING COIL FIN DA	FINS PER FOOT	LENGTH (IN)	
		904 533	140 140	4.0	1.25 0.75		3	6' - 0" 1' - 0"	60 60	4 1/4		4 1/4" 4 1/4"	50 40	72"	$\vdash$
F	T-3 (	533	140	1.0	0.75		1	1' - 0"	60	4 1/-	4"	4 1/4"	40	12"	
		566 791	140 140	4.5	0.75		1 3	2' - 0" 3' - 0"	60 60	4 1/-		4 1/4" 4 1/4"	40	24"	+
F	T-6 8	355	140	8.5	1		3	4' - 0"	60	4 1/-	4"	4 1/4"	32	48"	+
f	T-7 8	355	140	8.5	1		3	4' - 0"	60	4 1/-	4"	4 1/4"	32	48"	
										UNIT	HEATER	SCHEDULE	- HOT WATEF	१	
1.							EWT (°F)	LWT (°F)	IA	T (°F)	MBH	GPM	MAX PD (FT)	MOUNTING HEIGHT (FT)	0
۱.	PERFORMA MANUFACT	URER SH	AREA SEI		CEM		. ,	· · · · ·		2 °F	20.9	3.25	1	8' - 0"	Н
	PERFORMA MANUFACT MARK HWUH-1	URER SH	AREA SEF	SEMENT	CFM 900		140 °F	110 °F							
	PERFORMA MANUFACT	URER SH		SEMENT SEMENT			140 °F 140 °F 140 °F	110 °F 110 °F	9	1 °F	2.2 36	0.50	1	8' - 0" 10' - 0"	
	PERFORMA MANUFACT HWUH-1 HWUH-2 HWUH-3 HWUH-3	URER SH	DRAGE BA DRAGE BA KITCHEN STORAGE	SEMENT SEMENT L107 L109	900 245 1800 245		140 °F 140 °F 140 °F	110 °F 110 °F 110 °F	9 10 9	1 °F )3 °F 1 °F	2.2 36 2.8	0.50 5.50 0.50	1 1 1	10' - 0" 8' - 0"	H
	MARK HWUH-1 HWUH-2 HWUH-3 HWUH-4 HWUH-5	URER SH	DRAGE BA DRAGE BA KITCHEN STORAGE REAKROO	SEMENT SEMENT L107 L109 M G113	900 245 1800 245 245 750		140 °F 140 °F 140 °F 140 °F	110 °F 110 °F 110 °F 110 °F	9 10 9 1 <sup>°</sup>	1 °F )3 °F 1 °F 1 °F	2.2 36 2.8 14.7	0.50 5.50 0.50 2.50	1 1 1 1	10' - 0" 8' - 0" 8' - 0"	H H H
	PERFORMA MANUFACT HWUH-1 HWUH-2 HWUH-3 HWUH-3 HWUH-5 HWUH-6 HWUH-7	URER SH	DRAGE BA DRAGE BA KITCHEN STORAGE	SEMENT SEMENT L107 L109 M G113 G115	900 245 1800 245 750 1800 750		140 °F 140 °F 140 °F 140 °F 140 °F 140 °F	110 °F	9 10 9 11 10	1 °F )3 °F 1 °F	2.2 36 2.8 14.7 38 14.8	0.50 5.50 0.50 2.50 5.50 2.50	1 1 1	10' - 0" 8' - 0"	H H H
	PERFORMA MANUFACT HWUH-1 HWUH-2 HWUH-3 HWUH-4 HWUH-5 HWUH-6 HWUH-7 HWUH-8	URER SH	DRAGE BA DRAGE BA KITCHEN STORAGE REAKROO STORAGE REPARATIO KITCHEN	SEMENT SEMENT L107 L109 M G113 G115 DN L117 L107	900 245 1800 245 750 1800 750 1800		140 °F 140 °F 140 °F 140 °F 140 °F 140 °F 140 °F 140 °F	110 °F	9 10 9 1 <sup>2</sup> 10 1 <sup>2</sup> 10	1°F 3°F 1°F 1°F 3°F 1°F 1°F 03°F	2.2 36 2.8 14.7 38 14.8 36	0.50 5.50 0.50 2.50 5.50 2.50 5.50	1 1 1 1 1 1 1 1	10' - 0" 8' - 0" 8' - 0" 8' - 0" 8' - 0" 10' - 0"	H H H H H
	PERFORMA MANUFACT HWUH-1 HWUH-2 HWUH-3 HWUH-3 HWUH-5 HWUH-6 HWUH-7	URER SH	DRAGE BA DRAGE BA KITCHEN STORAGE REAKROO STORAGE REPARATIO	SEMENT SEMENT L107 L109 M G113 G115 ON L117 L107 ULE L111	900 245 1800 245 750 1800 750		140 °F 140 °F 140 °F 140 °F 140 °F 140 °F	110 °F	9 10 9 11 10 10 10 10 10	1 °F )3 °F 1 °F 1 °F )3 °F 1 °F	2.2 36 2.8 14.7 38 14.8	0.50 5.50 0.50 2.50 5.50 2.50	1 1 1 1 1 1 1	10' - 0" 8' - 0" 8' - 0" 8' - 0" 8' - 0"	H H H H H
	PERFORMA MANUFACT HWUH-1 HWUH-2 HWUH-3 HWUH-3 HWUH-4 HWUH-5 HWUH-6 HWUH-6 HWUH-7 HWUH-8 HWUH-9 HWUH-10 HWUH-11	URER SH	DRAGE BA DRAGE BA KITCHEN STORAGE REAKROO STORAGE REPARATIO KITCHEN KITCHEN K VESTIBULI VASHING I	SEMENT SEMENT L107 L109 M G113 G115 DN L117 L107 ULE L111 E L116 ROOM U104	900 245 1800 245 750 1800 750 1800 550 500 1100		140 °F 140 °F	110 °F	9 10 9 1 <sup>2</sup> 10 10 10 10 10 10 10 10	1°F )3°F 1°F 1°F )3°F 1°F )3°F )3°F )3°F )3°F 03°F 03°F 06°F	2.2 36 2.8 14.7 38 14.8 36 10.44 8 22.1	0.50 5.50 0.50 2.50 5.50 2.50 5.50 2.00 1.25 5.50	1 1 1 1 1 1 1 1 1 1 1 1 1	10' - 0" 8' - 0" 8' - 0" 8' - 0" 10' - 0" 8' - 0" 8' - 0" 8' - 0"	H H H H H H H H H
	PERFORMA MANUFACT HWUH-1 HWUH-2 HWUH-3 HWUH-3 HWUH-4 HWUH-5 HWUH-6 HWUH-6 HWUH-7 HWUH-8 HWUH-9 HWUH-10	URER SH	DRAGE BA DRAGE BA KITCHEN STORAGE REAKROO STORAGE REPARATIO KITCHEN CK VESTIB /ESTIBULI	SEMENT SEMENT L107 L109 M G113 G115 DN L117 L107 ULE L111 E L116 ROOM U104 GE 107	900 245 1800 245 750 1800 750 1800 550 500		140 °F 140 °F 140 °F 140 °F 140 °F 140 °F 140 °F 140 °F 140 °F 140 °F	110 °F	9 10 9 11 10 10 10 10 10 9 10 10	1°F )3°F 1°F 1°F 1°F 1°F )3°F )3°F )3°F )3°F )3°F )3°F	2.2 36 2.8 14.7 38 14.8 36 10.44 8	0.50 5.50 0.50 2.50 5.50 2.50 5.50 2.00 1.25	1 1 1 1 1 1 1 1 1 1	10' - 0" 8' - 0" 8' - 0" 8' - 0" 10' - 0" 8' - 0" 8' - 0" 8' - 0"	H H H H H H H H
	PERFORMA MANUFACT HWUH-1 HWUH-2 HWUH-3 HWUH-3 HWUH-4 HWUH-4 HWUH-5 HWUH-6 HWUH-7 HWUH-6 HWUH-7 HWUH-10 HWUH-10 HWUH-11 HWUH-12 HWUH-13 HWUH-14	URER SH	DRAGE BA DRAGE BA KITCHEN STORAGE REAKROO STORAGE REPARATIO KITCHEN KITCHEN KITCHEN KITCHEN KITCHEN KITCHEN KITCHEN KITCHEN KITCHEN KITCHEN STORAGE STORAGE	SEMENT SEMENT L107 L109 M G113 G115 DN L117 L107 ULE L111 E L116 ROOM U104 GE 107 E 109 E 201	900           245           1800           245           750           1800           750           1800           550           500           1100           1400           750		140 °F 140 °F	110 °F	9 10 9 11 10 10 10 10 10 10 10 10 10 10 10 10	1°F         )3°F         1°F         1°F         )3°F         03°F         05°F         05°F	2.2 36 2.8 14.7 38 14.8 36 10.44 8 22.1 26.2 33.6 13.1	0.50 5.50 0.50 2.50 5.50 2.50 5.50 2.00 1.25 5.50 4.50 5.00 2.50	1 1 1 1 1 1 1 1 1 1 1 1 1 1 1 1 1	10' - 0" 8' - 0" 8' - 0" 8' - 0" 10' - 0" 8' - 0"	H H H H H H H H H H H H
	PERFORMA MANUFACT HWUH-1 HWUH-2 HWUH-3 HWUH-3 HWUH-4 HWUH-5 HWUH-6 HWUH-5 HWUH-6 HWUH-7 HWUH-8 HWUH-10 HWUH-11 HWUH-11 HWUH-13 HWUH-15	URER SH	DRAGE BA DRAGE BA KITCHEN STORAGE REAKROO STORAGE EPARATIO KITCHEN KITCHEN KVESTIBULI VASHING I RY STORAGE STORAGE STORAGE	SEMENT SEMENT L107 L109 M G113 G115 DN L117 L107 ULE L111 E L116 ROOM U104 GE 107 E 109 E 201 E 202	900           245           1800           245           750           1800           750           1800           550           500           1100           1400           750           900		140 °F 140 °F	110 °F           110 °F	9 10 9 1 <sup>2</sup> 10 10 10 10 10 10 10 10 10 11 11	1°F )3°F 1°F )3°F )3°F )3°F )3°F )3°F )3°F 06°F )6°F 3°F 1°F 2°F	2.2 36 2.8 14.7 38 14.8 36 10.44 8 22.1 26.2 33.6 13.1 20.8	0.50           5.50           0.50           2.50           5.50           2.50           5.50           2.50           5.50           2.00           1.25           5.50           4.50           5.00           2.50           3.25	1 1 1 1 1 1 1 1 1 1 1 1 1 1 1	10' - 0" 8' - 0" 8' - 0" 8' - 0" 10' - 0" 8' - 0"	
	PERFORMA MANUFACT HWUH-1 HWUH-2 HWUH-3 HWUH-3 HWUH-4 HWUH-4 HWUH-5 HWUH-6 HWUH-7 HWUH-6 HWUH-7 HWUH-10 HWUH-10 HWUH-11 HWUH-12 HWUH-13 HWUH-14	URER SH	DRAGE BA DRAGE BA KITCHEN STORAGE REAKROO STORAGE REPARATIO KITCHEN KITCHEN KITCHEN KITCHEN KITCHEN KITCHEN KITCHEN KITCHEN KITCHEN KITCHEN STORAGE STORAGE	SEMENT SEMENT L107 L109 M G113 G115 DN L117 L107 ULE L111 E L116 ROOM U104 GE 107 E 109 E 201 E 202 E 203 E 204	900           245           1800           245           750           1800           750           1800           550           500           1100           1400           750		140 °F 140 °F	110 °F	9 10 9 11 10 10 10 10 10 10 10 10 10 10 10 10	1°F         )3°F         1°F         1°F         )3°F         03°F         05°F         05°F	2.2 36 2.8 14.7 38 14.8 36 10.44 8 22.1 26.2 33.6 13.1	0.50 5.50 0.50 2.50 5.50 2.50 5.50 2.00 1.25 5.50 4.50 5.00 2.50	1 1 1 1 1 1 1 1 1 1 1 1 1 1 1 1 1 1 1	10' - 0" 8' - 0" 8' - 0" 8' - 0" 10' - 0" 8' - 0"	H H H H H H H H H H

1. PERFO	ORMANCE BASED C	ON OPERAT	ING CONDIT	IONS.							
		INPUT	OUTPUT	MIN GAS PRESSURE		EWT	LWT		MAX PD		TURNDOWN
MARK	AREA SERVED	(MBH)	(MBH)	REQUIRED (IN)	EFFICIENCY	(°F)	(°F)	GPM	(FT)	FUEL TYPE	RATIO
B-1	KITCHEN	399	363	3	91	110	140	40	6.10	NATURAL GAS	8:1
B-2	KITCHEN	399	363	3	91	110	140	40	6.10	NATURAL GAS	8:1
B-3	KITCHEN	399	363	3	91	110	140	40	6.10	NATURAL GAS	8:1

т	ICAL PIPIN C/ YPE ADDER	G EXPA TANK APACITY (GAL) 10.0	ACCE CAF (0	N TANK S PTANCE PACITY GAL) 10.0		FILL /	E AT (PSI) 2.00	DESIGN BASIS B&G B-35LA	1	SHIVEHATTERY	N 32402	515.223.8104   www.shive-hattery.com Iowa   Illinois   Indiana	
DATA S	PHASE 1 IASE 3 3		N BASIS	50 ELECT DESIGI B&G E1510	RICAL TO PF		DUPLEX F	RECEPTACLE		CENTRALIZATION		ATIVE SERVICES	50627
TATION TICAL TICAL TICAL TICAL TICAL TICAL TICAL			ASE 1 1 1 1 1 1 1 1 1 1	TRANE TRANE TRANE TRANE TRANE TRANE TRANE	N BASIS FFBB080 FFBB030 FFBB060 FFBB060 FFBB060 FFBB030 FFBB080		REMA	RKS	2		UILDING PACK	HICHEN IOWA DEPARTMENT OF ADMINISTRATIVE SERVICES	3211 EDGINGTON AVE. ELDORA, IA 50627
TH (IN) 2" 2" 2" 4" 6" 8" 8"	ENCLOSURE DEPTH (IN) 5 5/16" 5 5/16" 5 5/16" 5 5/16" 5 5/16" 5 5/16" 5 5/16"	E HEIGHT 14" 14" 24" 24" 24" 24"	1 1 1 1 1	STERLIN STERLIN STERLIN STERLIN STERLIN STERLIN	GN BASIS NG JVB-FT24 NG JVB-FT14 NG JVB-FT14 NG JVB-FT24 NG JVB-FT24 NG JVB-FT24	· · · · · · · · · · · · · · · · · · ·	REN	IARKS	3	02-06-2020 ADDENDUM 01			
TING T (FT) 0" 0" 0" 0" 0" 0" 0" 0" 0" 0" 0" 0" 0"	ORIENTATION HORIZONTAL HORIZONTAL HORIZONTAL HORIZONTAL HORIZONTAL HORIZONTAL HORIZONTAL HORIZONTAL HORIZONTAL HORIZONTAL HORIZONTAL HORIZONTAL HORIZONTAL HORIZONTAL HORIZONTAL HORIZONTAL HORIZONTAL	- 1/2   - 1/2 - 1/2          -		AN MOTOR VOLTS 120 120 120 120 120 120 120 120 120 120		ASE 1 1 1 1 1 1 1 1 1 1 1 1 1	REZ REZ REZ REZ REZ REZ REZ REZ REZ REZ	SIGN BASIS ZNOR S-60 ZNOR S-408 ZNOR S-108 ZNOR S-48 ZNOR S-48 ZNOR S-108 ZNOR S-108 ZNOR S-108 ZNOR S-36 ZNOR S-36 ZNOR S-72 ZNOR S-72 ZNOR S-84 ZNOR S-96 ZNOR S-108 ZNOR S-108 ZNOR S-108 ZNOR S-18 ZNOR S-96			D FOR:	PROJECT NO:4175681	CLIENT NO: #8982.01
'N		CTRICAL D		MOCP 20 20 20	DESIGN B AERCO AI AERCO AI AERCO AI	ASIS M399 M399		EMARKS		KITCHEN &	STORAGE MECHANICAL	SCHEDULES	


F

11-M6.00

			A	В	
	1				
	2				
	3				
					DOMESTIC H STATION DE NOT TO SCALE
@shive-hattery.com.rvt					B2 NOT TO SCALE
5-Kitchen-MEP-Cent_jbaumhover	4				
C:\shive\Revit_Local_2019\EldoraSTS-Kitchen-MEP-Cent_jbaumhover@shive-hattery.com.rvt Printed: 2/4/2020 2:00:03 PM					
	Autode	sk Revit 2019	A	В	



Е

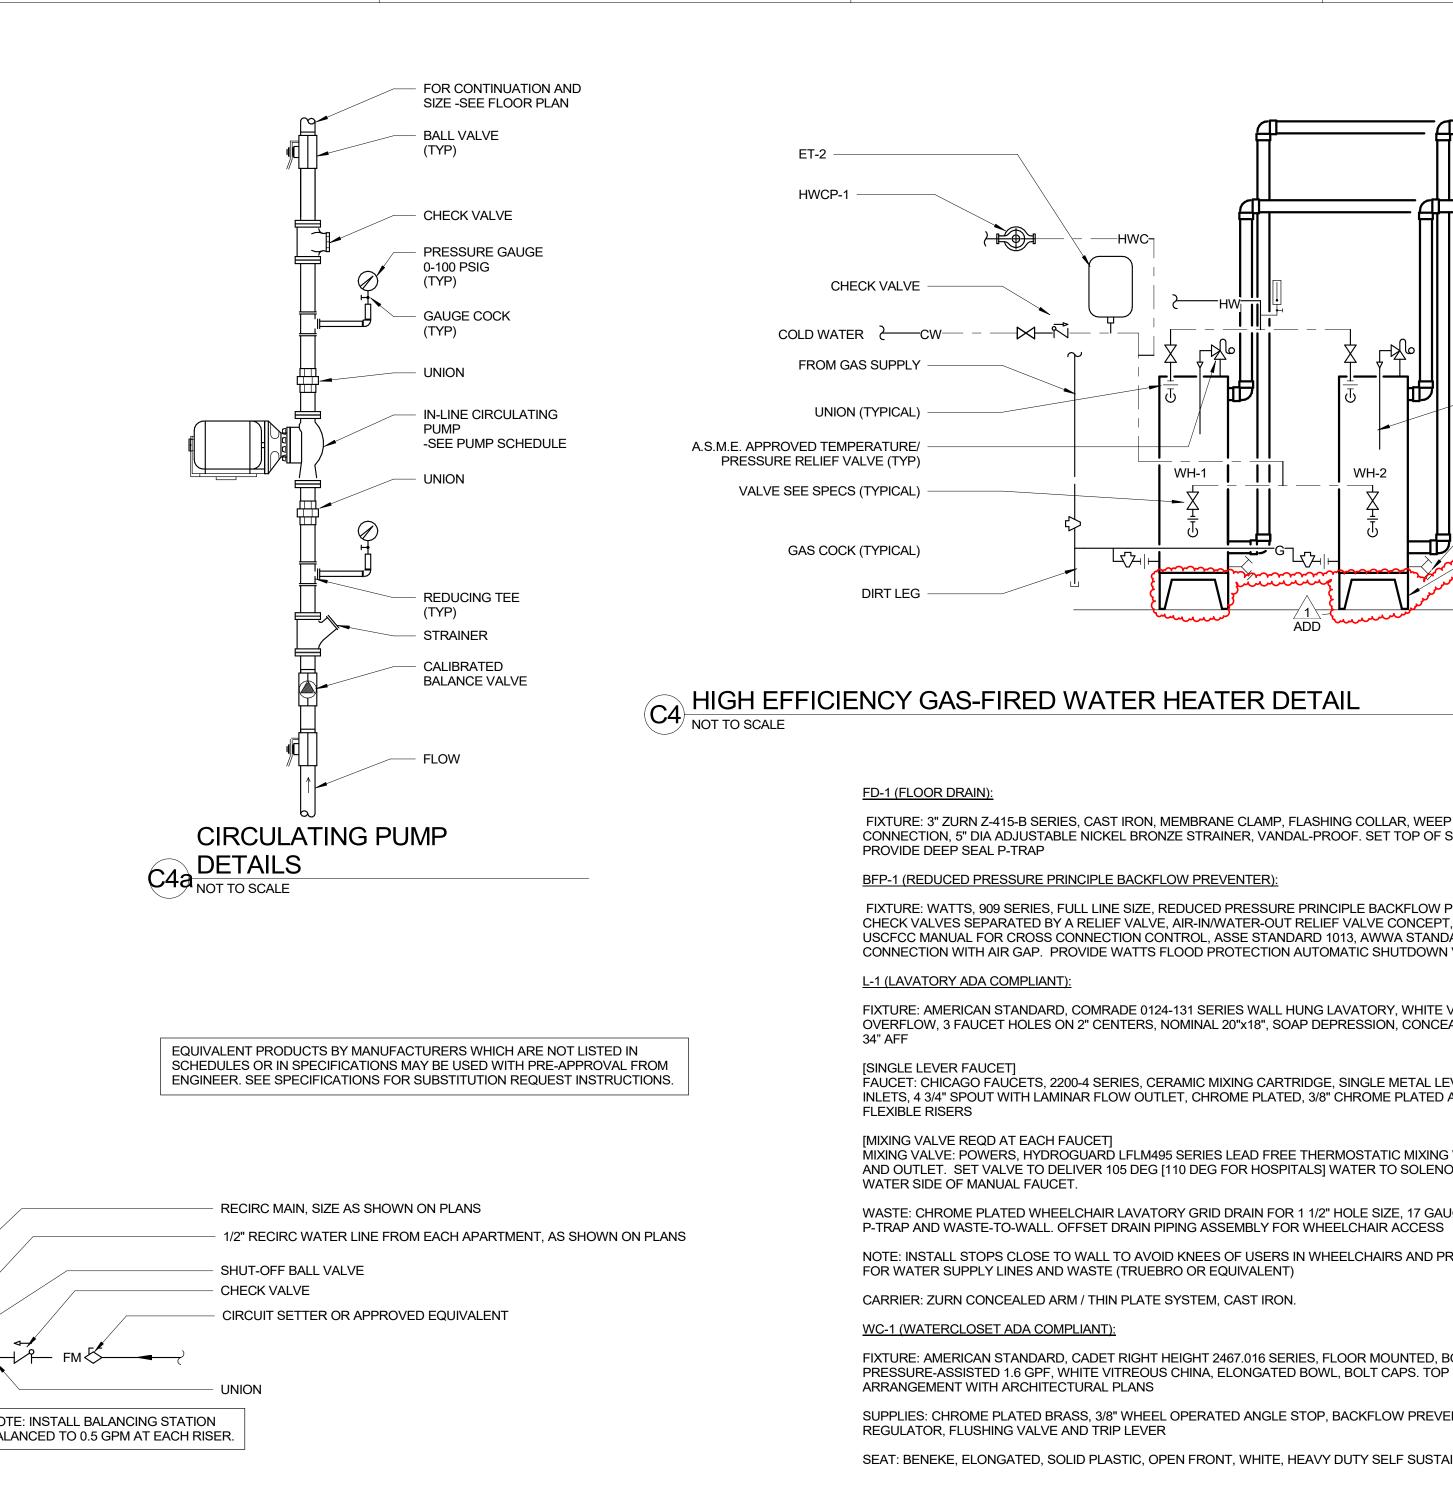

# IC HOT WATER RECIRCULATING BALA DETAIL

С


С

ICING			PLUMBING EXPANSION TANK SCHEDULE										
						TANK	ACCEPTANCE	RELIEF	- VALVE				
			MARK	SYSTEM SERVED	TYPE	CAPACITY (GAL)	CAPACITY (GAL)	RELIEF AT (PSI)	FILL AT (PSI)	DESIGN BASIS	REMARKS		
			ET-2	DOMESTIC HOT WATER	R DIAPHRAG	M 14.0	9.0	125.00	12.00	PTA-30V			
		,		PLUMBIN	G PUMP SC	HEDULE (WA	TTAGE)						
				SI	HUTOFF		MOTOR DATA						
	MARK	SYSTEM SERVED	GPM	HEAD (FT)	EAD (FT)	VATTS V	OLTS PHA	SE RI	PM DE	SIGN BASIS	REMARKS		
	HWCP-1	HOT WATER CIRCULATION	2.2	3.10	3.28	4	115 1	11	82 B&G I	ECOCIRC 19-16	XXX		

	WATER HEATER SCHEDULE - GAS												
IOTES: . DISCON	NECT TO BE	PROVIDED AI	ND INSTA	LLED BY	ELECTRICAL CO	ONTRACTOR.							
					GAS				ELE	CTRICAL D	ATA		
	STORAGE	RECOVERY	WATER	OUT		OUTPUT	THERMAL	PRESSURE					
MARK	(GAL)	(GPH)	IN (°F)	(°F)	INPUT (MBH)	(MBH)	EFFICIENCY	(IN WC)	VOLTS	PHASE	FLA	DESIGN BASIS	REMARKS
WH-1	100.0	235	40	140	199	193	97	4.8-14	120	1	5	AO SMITH BTH-199	
WH-2	100.0	235	40	140	199	193	97	4.8-14	120	1	5	AO SMITH BTH-199	

D

E

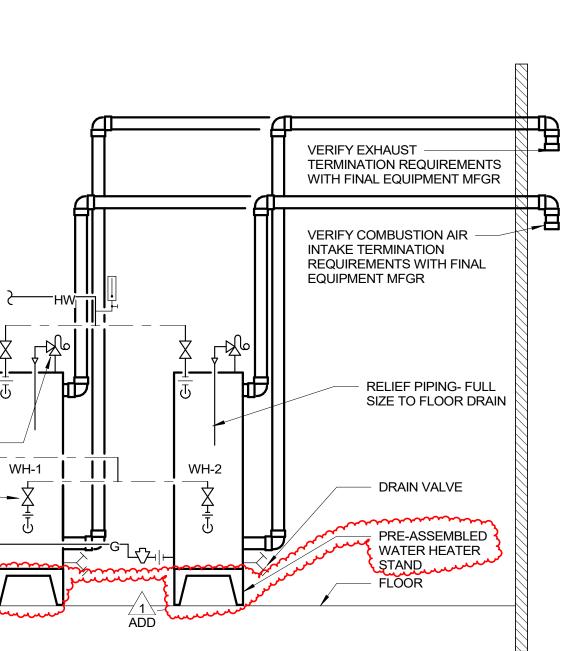

F

FIXTURE: 3" ZURN Z-415-B SERIES, CAST IRON, MEMBRANE CLAMP, FLASHING COLLAR, WEEP HOLES, HUB OUTLET WITH GASKETED CONNECTION, 5" DIA ADJUSTABLE NICKEL BRONZE STRAINER, VANDAL-PROOF. SET TOP OF STRAINER FLUSH WITH FINISHED FLOOR.

FIXTURE: WATTS, 909 SERIES, FULL LINE SIZE, REDUCED PRESSURE PRINCIPLE BACKFLOW PREVENTER, TWO INDEPENDENTLY OPERATING CHECK VALVES SEPARATED BY A RELIEF VALVE, AIR-IN/WATER-OUT RELIEF VALVE CONCEPT, BALL VALVE TEST COCKS, COMPLIANT WITH USCFCC MANUAL FOR CROSS CONNECTION CONTROL, ASSE STANDARD 1013, AWWA STANDARD C506-78. PROVIDE WATTS DRAIN CONNECTION WITH AIR GAP. PROVIDE WATTS FLOOD PROTECTION AUTOMATIC SHUTDOWN VALVE AND CONTROLS.

FIXTURE: AMERICAN STANDARD, COMRADE 0124-131 SERIES WALL HUNG LAVATORY, WHITE VITREOUS CHINA, FAUCET LEDGE, BACK OVERFLOW, 3 FAUCET HOLES ON 2" CENTERS, NOMINAL 20"x18", SOAP DEPRESSION, CONCEALED ARM SUPPORT. MOUNT TOP OF BASIN AT

FAUCET: CHICAGO FAUCETS, 2200-4 SERIES, CERAMIC MIXING CARTRIDGE, SINGLE METAL LEVER HANDLE, 3/8" FLEXIBLE STAINLESS STEEL INLETS, 4 3/4" SPOUT WITH LAMINAR FLOW OUTLET, CHROME PLATED, 3/8" CHROME PLATED ANGLE STOPS WITH WHEEL HANDLE AND

MIXING VALVE: POWERS, HYDROGUARD LFLM495 SERIES LEAD FREE THERMOSTATIC MIXING VALVE. MOUNT UNDER THE FIXTURE, 1/2" INLETS AND OUTLET. SET VALVE TO DELIVER 105 DEG [110 DEG FOR HOSPITALS] WATER TO SOLENOID VALVE FOR ELECTRONIC FAUCET OR HOT

WASTE: CHROME PLATED WHEELCHAIR LAVATORY GRID DRAIN FOR 1 1/2" HOLE SIZE, 17 GAUGE - 1 1/4" CHROME PLATED BRASS ADJUSTABLE

NOTE: INSTALL STOPS CLOSE TO WALL TO AVOID KNEES OF USERS IN WHEELCHAIRS AND PROVIDE WHITE PREFABRICATED VINYL COVER

FIXTURE: AMERICAN STANDARD, CADET RIGHT HEIGHT 2467.016 SERIES, FLOOR MOUNTED, BOTTOM OUTLET, CLOSE-COUPLED TANK, PRESSURE-ASSISTED 1.6 GPF, WHITE VITREOUS CHINA, ELONGATED BOWL, BOLT CAPS. TOP OF RIM 16 1/2" AFF. COORDINATE TRIP LEVER

SUPPLIES: CHROME PLATED BRASS, 3/8" WHEEL OPERATED ANGLE STOP, BACKFLOW PREVENTER WATER CONTROL WITH VOLUME

SEAT: BENEKE, ELONGATED, SOLID PLASTIC, OPEN FRONT, WHITE, HEAVY DUTY SELF SUSTAINING CHECK HINGE, BUMPERS, NO COVER

F


1			A C H I T E C T U R E + E N G I N E E R I N G	4125 Westown Pkwy, Suite 100   West Des Moines, IA 50266		carcipal   sizai			
2	EL DORA STS DECENTRALIZATION	T.	BUILDING PACKAGE	KITCHEN		IOWA DEPARTMENT OF ADMINISTRATIVE SERVICES		3211 EDCINCTON AVE ELDODA IN 50627	
3	ADD 1 02-06-2020 ADDENDUM 01								
	DRAWN: JDB	APPROVED: TLS	ISSUED FOR: CONSTRUCTION DOCUMENTS	DATE: 01/06/2020	DPO IECT NO: 4175684			CLIENT NO: #8982 01	
4	KITCHEN &				DETALS &				_
		1	-		5		U	0	


_Local_2019/EldoraSTS-AutoTech-MEP-Cent_jbaumhover@shive-hattery.com.rvt	

Δ1.1 <del>1</del>	A B lesk Revit 2019	
		NORTH
-		
4		
3		
~		
2		
1		
1		

А

В

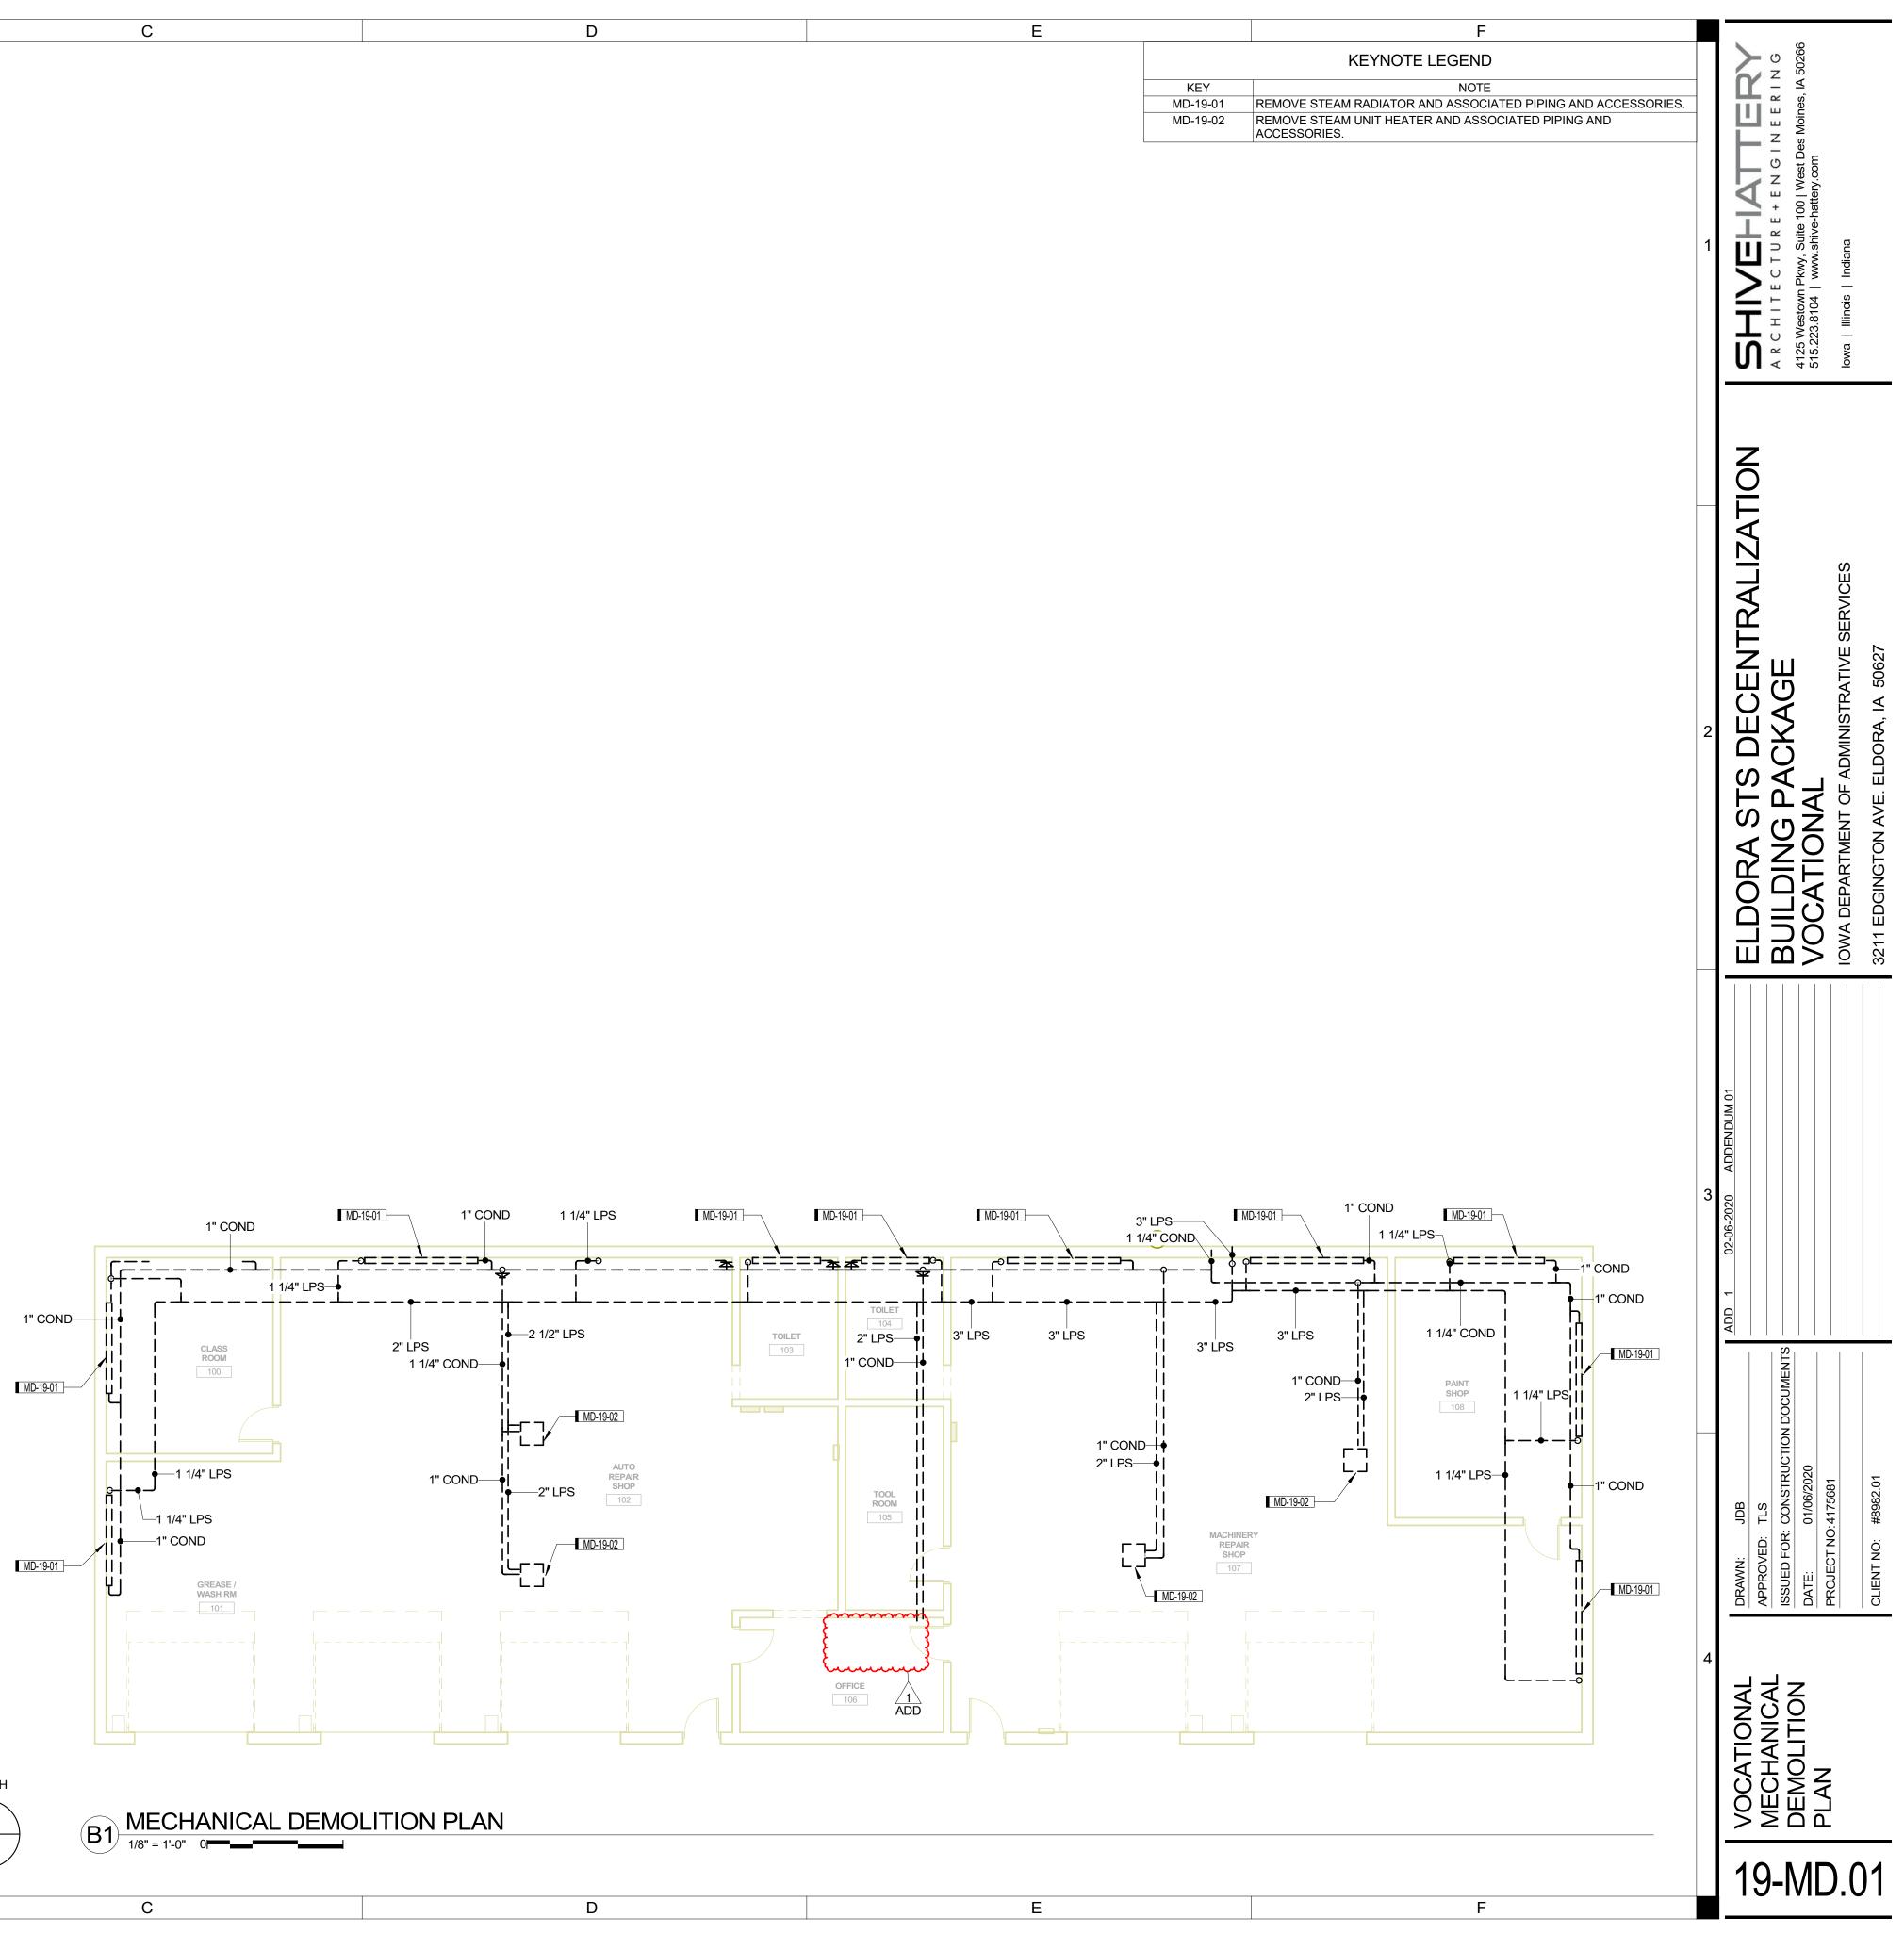

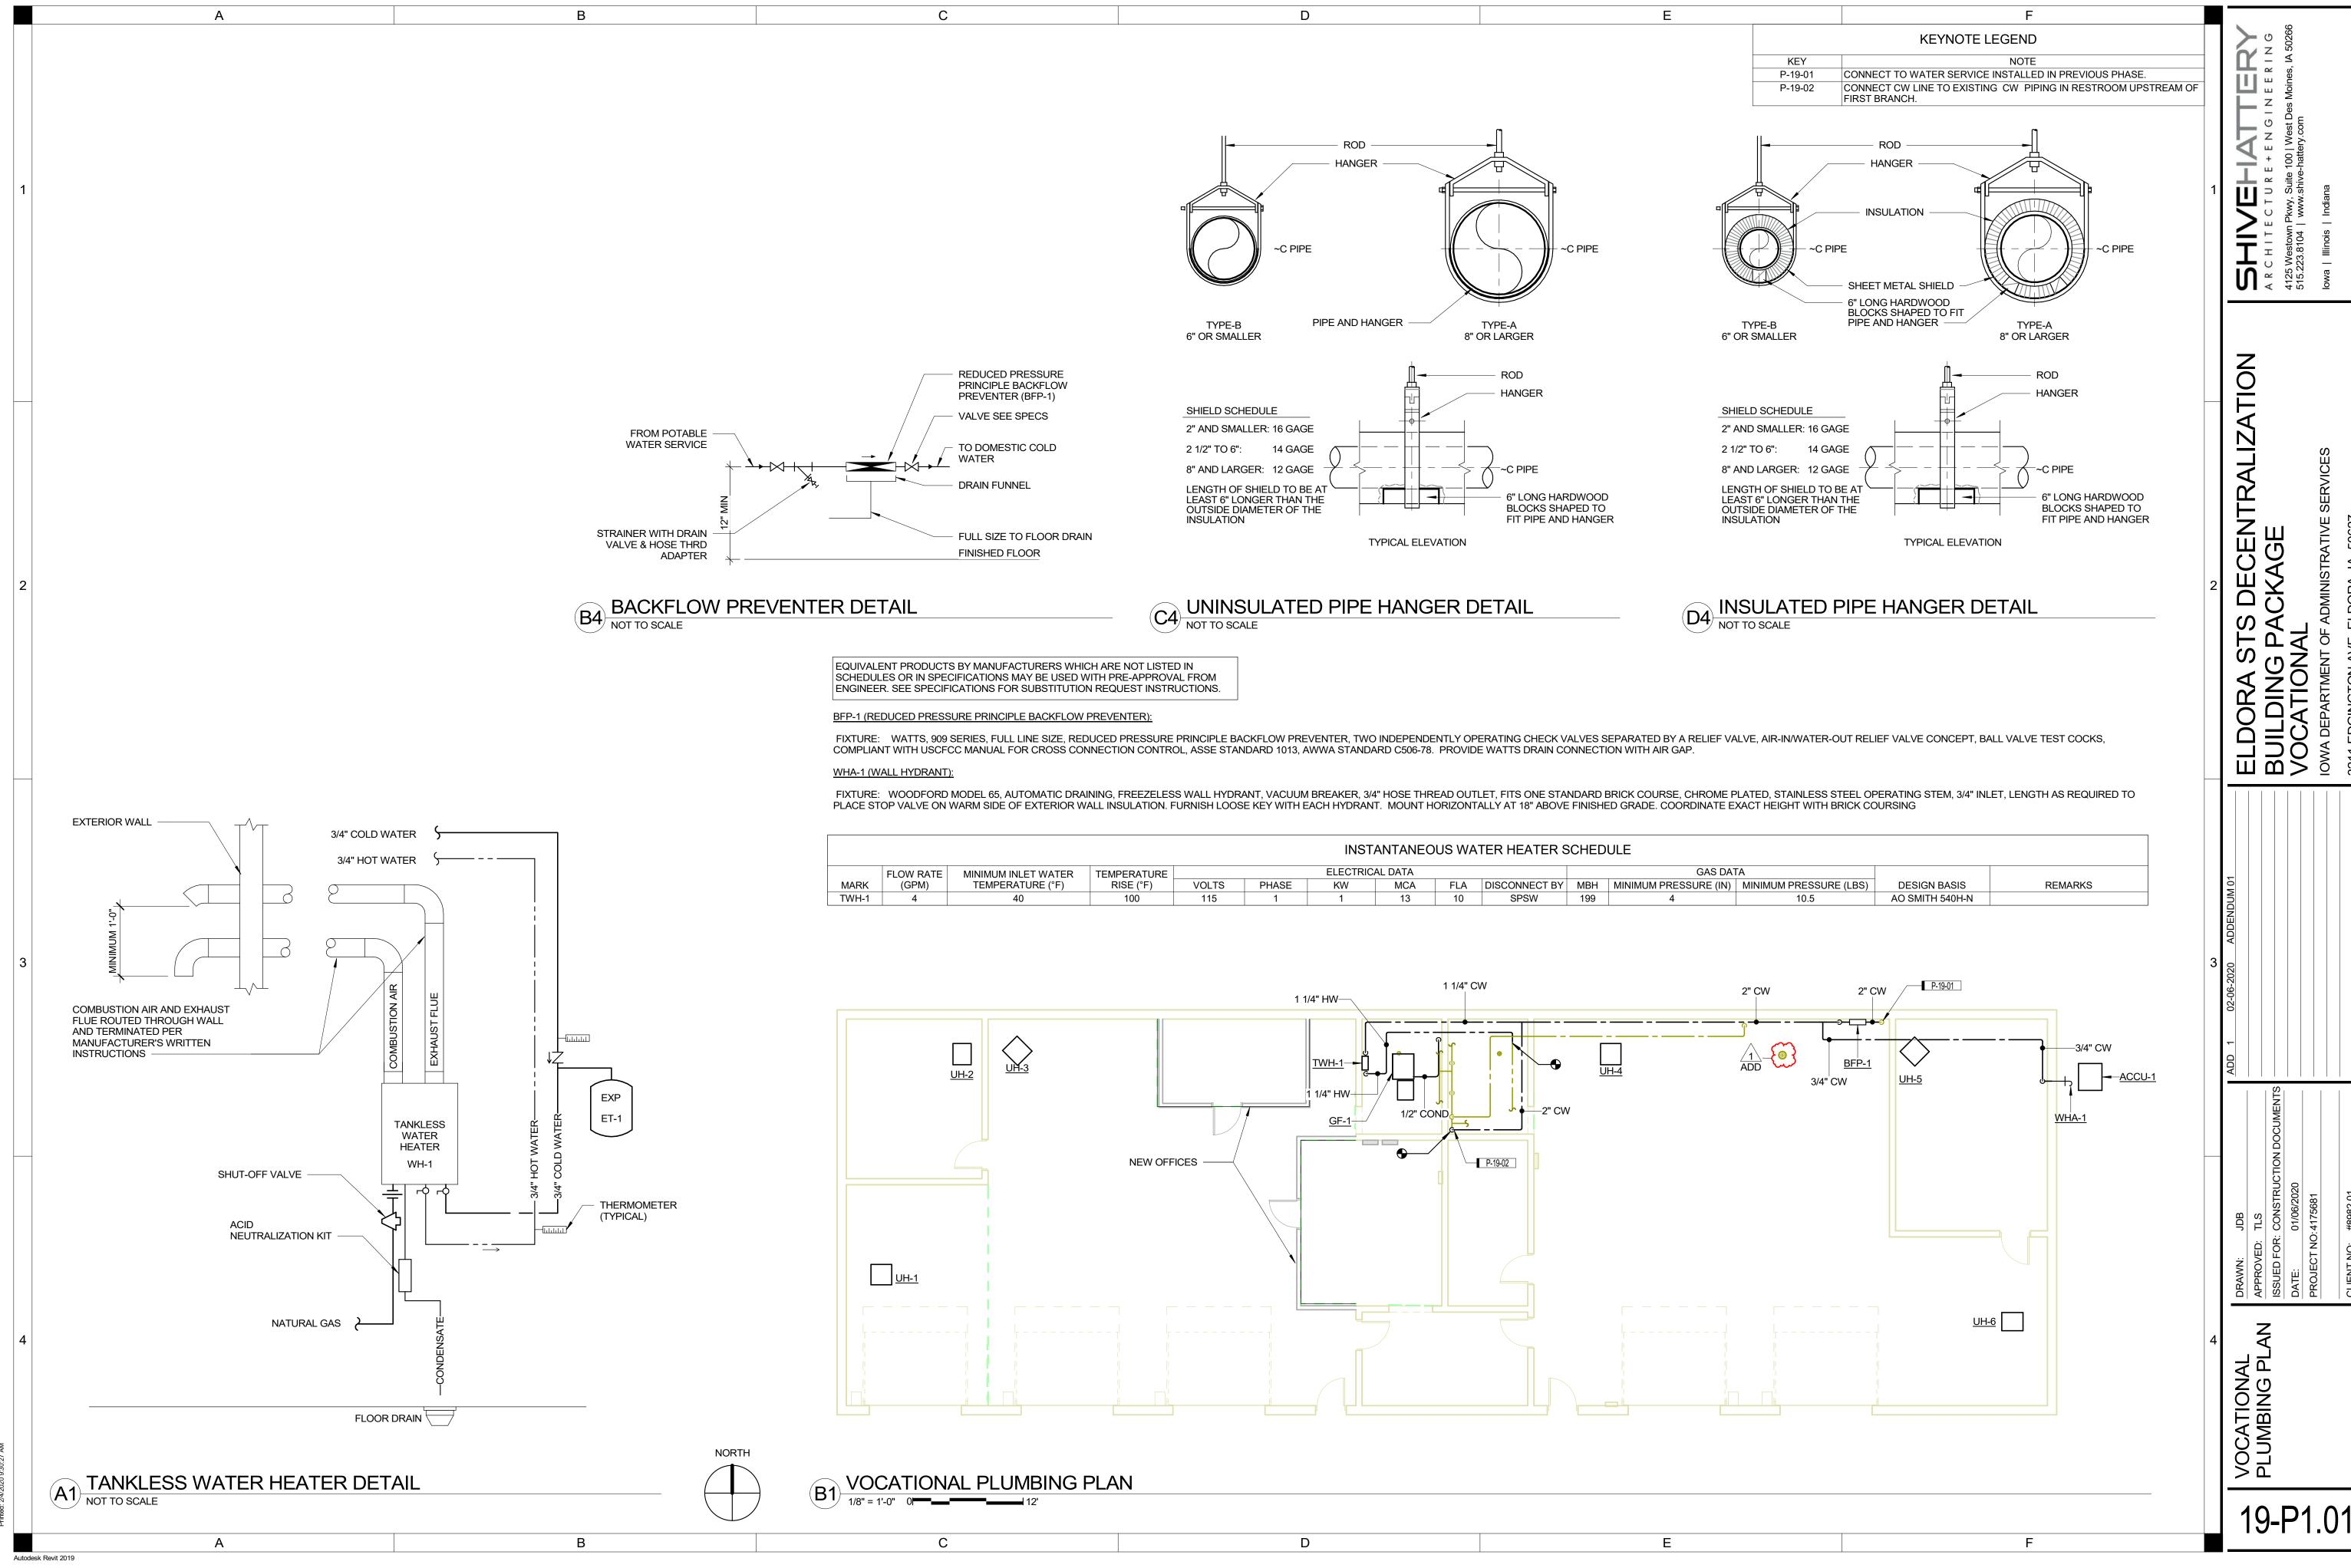

						INST	ANTANEC	OUS WA	TER HEATER S	SCHED	ULE	
	FLOW RATE	MINIMUM INLET WATER	TEMPERATURE			ELECTRIC	AL DATA				GAS DA	ΓA
MARK	(GPM)	TEMPERATURE (°F)	RISE (°F)	VOLTS	PHASE	KW	MCA	FLA	DISCONNECT BY	MBH	MINIMUM PRESSURE (IN)	MI
TWH-1	4	40	100	115	1	1	13	10	SPSW	199	4	

.com.rvt
jbaumhover@shive-hattery
STS-AutoTech-MEP-Cent_j
vit_Local_2019\EldoraS

		Α		В	
	1				
	2				
	3				
	4				
v					
30:29 AN					
4/2020 9:					
Printed: 2/4/2020 9:30:29 AM					
Ϋ́		A		В	
	Autode	esk Revit 2019	1	-	

NORTH

